


AMENDED

SCALE: = $\frac{1}{2}$ " = ONE FOOT.

✓ WOOD SCANTLINGS.
BEAMS 6'-3"-38 BA ON ALTER² FRAMES (3 ROW) ✓
3 ROWS OF PILLARS 2 1/2 DIA COMPLETE STEEL 2"-30 1/2-34 ✓
WOOD SHEATHING OVER ACCOM² 2 1/2 PP.
STRINGER ANGLE 3 1/2-3 1/2-34 SIDE PLATING 37" ✓
BUTTLAPS 2 SEAMS OF DECK & SIDE PLATING SINGLEIN² ✓
FORECASTLE SCANTLINGS
BEAMS 6'-3"-38 BA ON EVERY FRAME (2 ROW) ✓
2 ROWS OF PILLARS 2 1/2 DIA COMPLETE STEEL 2"-33 ✓
STRINGER ANGLE 3 1/2-3 1/2-40 SIDE PLATING 40" ✓
BUTTLAPS & SEAMS OF DECK & SIDE PLATING SINGLE EN ✓

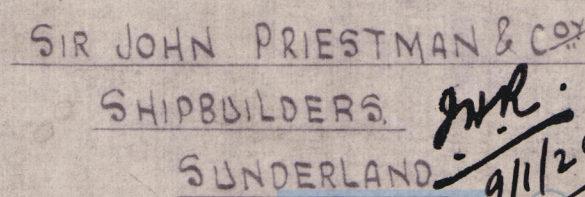

004556-004563-0003

Sunderland

Sir John Priestman & Co

MIDSHIP SECTION

(AS BUILT)

No 286

S. S. "PENHALE"

BUNDERLAND RPT. NO. 28415

M/P "PREVENT"
X



© 2020

Lloyd's Register
Foundation

004556-004556-004556