



# AMENDED DECK PLANS N<sup>o</sup> 286.


SCALE  $\frac{1}{8}$ " = ONE FOOT

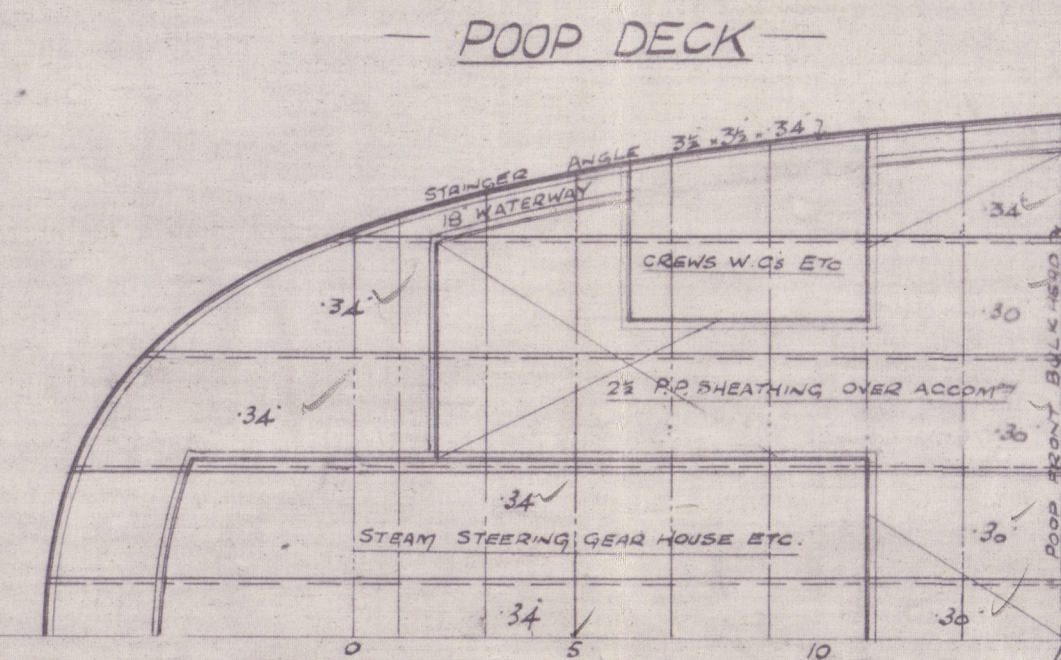


## BRIDGE DECK

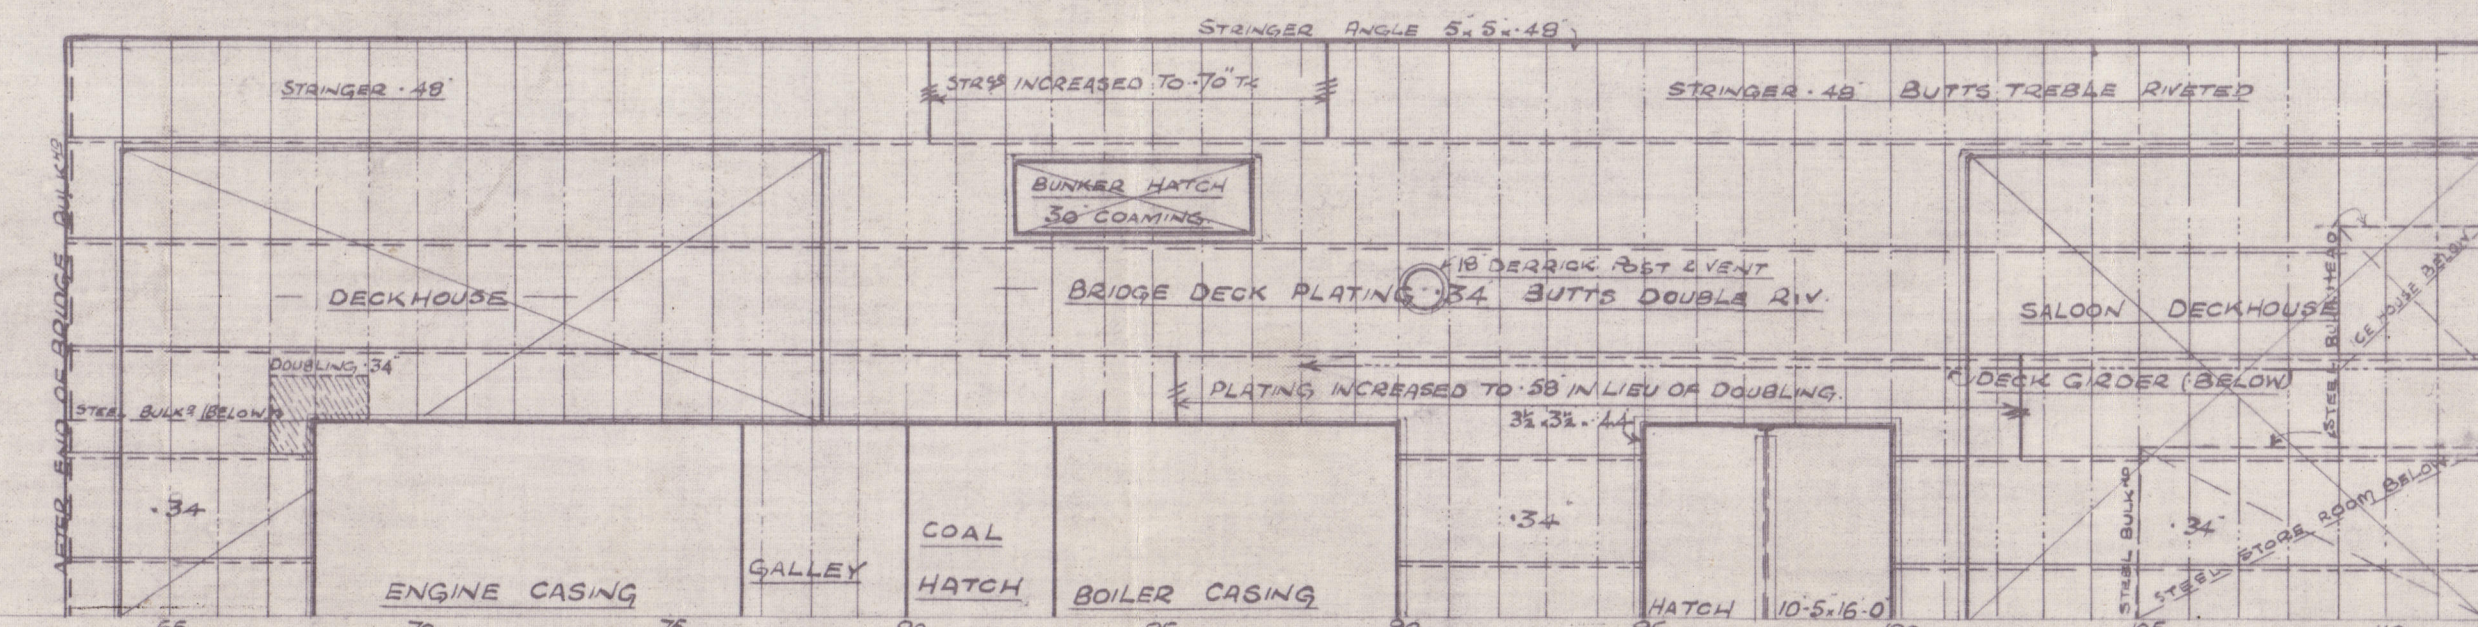

## FORECASTLE DECK

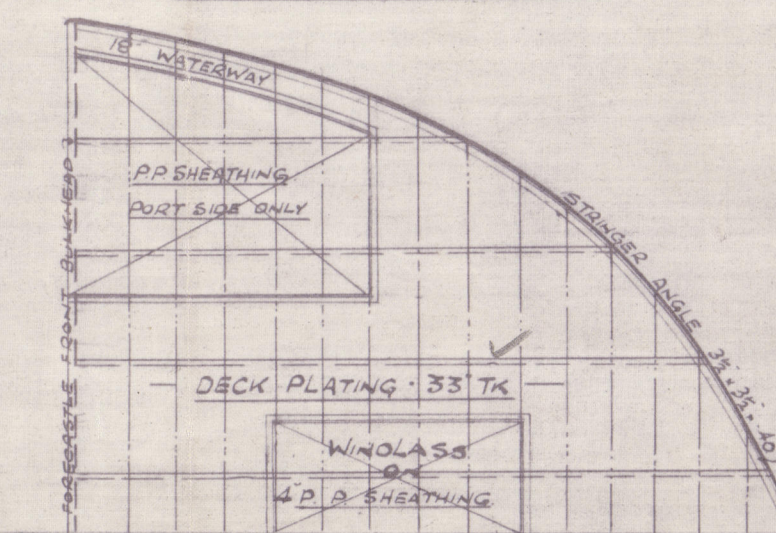

## UPPER DECK

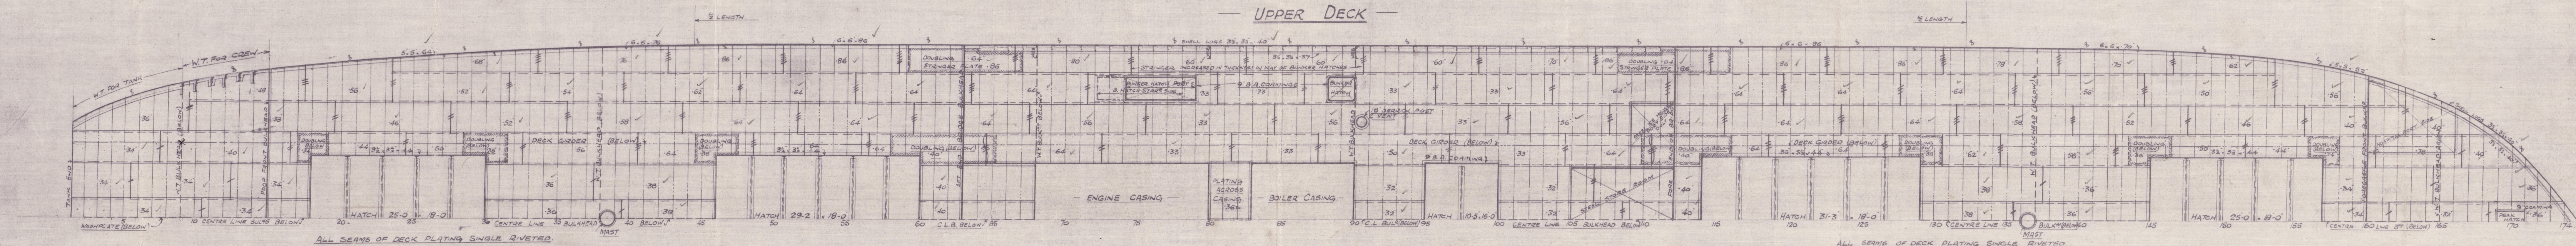

SIR JOHN PRIESTMAN & CO.

SHIPBUILDERS

9/1/24.

SUNDERLAND. © 2020



Sunderland

Sir John Priestman & Co

No 286

DECK PLAN

(AS BUILT)

"S. S. PENHALE"

N.W. PREVENT  
\*

SUNDERLAND RPT. NO. 28415



© 2020

Lloyd's Register  
Foundation

004556-004563-0004