


LETTER h 1 1

EQUIPMENT

3 BOWEN ANCHORS STOCK NO.	971	291.4
1 29M 1/2 CWT EXCL. STOCK	954	290.0
330 FATHOMS 2 3/4" HIGH TENSILE STEEL CHAIN.		
120 --- 5/8" STEEL WIRE G-24 SPEC FLEX STEEL WIRE ROPE		
120 --- 6/8" --- 1.000 --- 1.000 --- 1.000 --- 1.000		
2 120 --- 2 3/4" --- 1.000 --- 1.000 --- 1.000 --- 1.000		
2 120 --- 2 3/4" --- 1.000 --- 1.000 --- 1.000 --- 1.000		
2 120 --- 2 3/4" --- 1.000 --- 1.000 --- 1.000 --- 1.000		

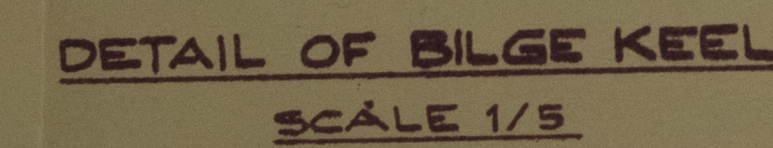


PART NO	CLASS	T.T. 350 360	
350	LLOYD'S		
360			
		MIDSHIP SECTION.	
		AS BUILT.	
		SCALE 1/25	KOCKUMS
		KONTO	MEK. VERKSTADS A-B
			MALMO - SWEDEN
ETIAN	<i>JK</i>		
KOP AV			
GRANSK 5.53			
DATUM MAJ 53		13 349 / 1C	

Midship section
(as built)

★ SAXONSKY

RECORDS DEPT.
LONDON

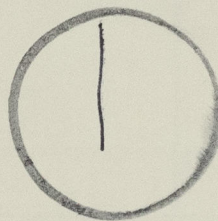

RETAIN



© 2021

Lloyd's Register
Foundation

005013- 005019- 0037