


# SHIP N° 567

## LONGITUDINAL PLAN

DIMENSIONS - 225'-0" B.P. x 35'-10" x 16'-0" D.MLD TO UPPER DECK  
19'-5" D.MLD. TO R.Q. DECK.

SCALE 1/8" = 1 FT.

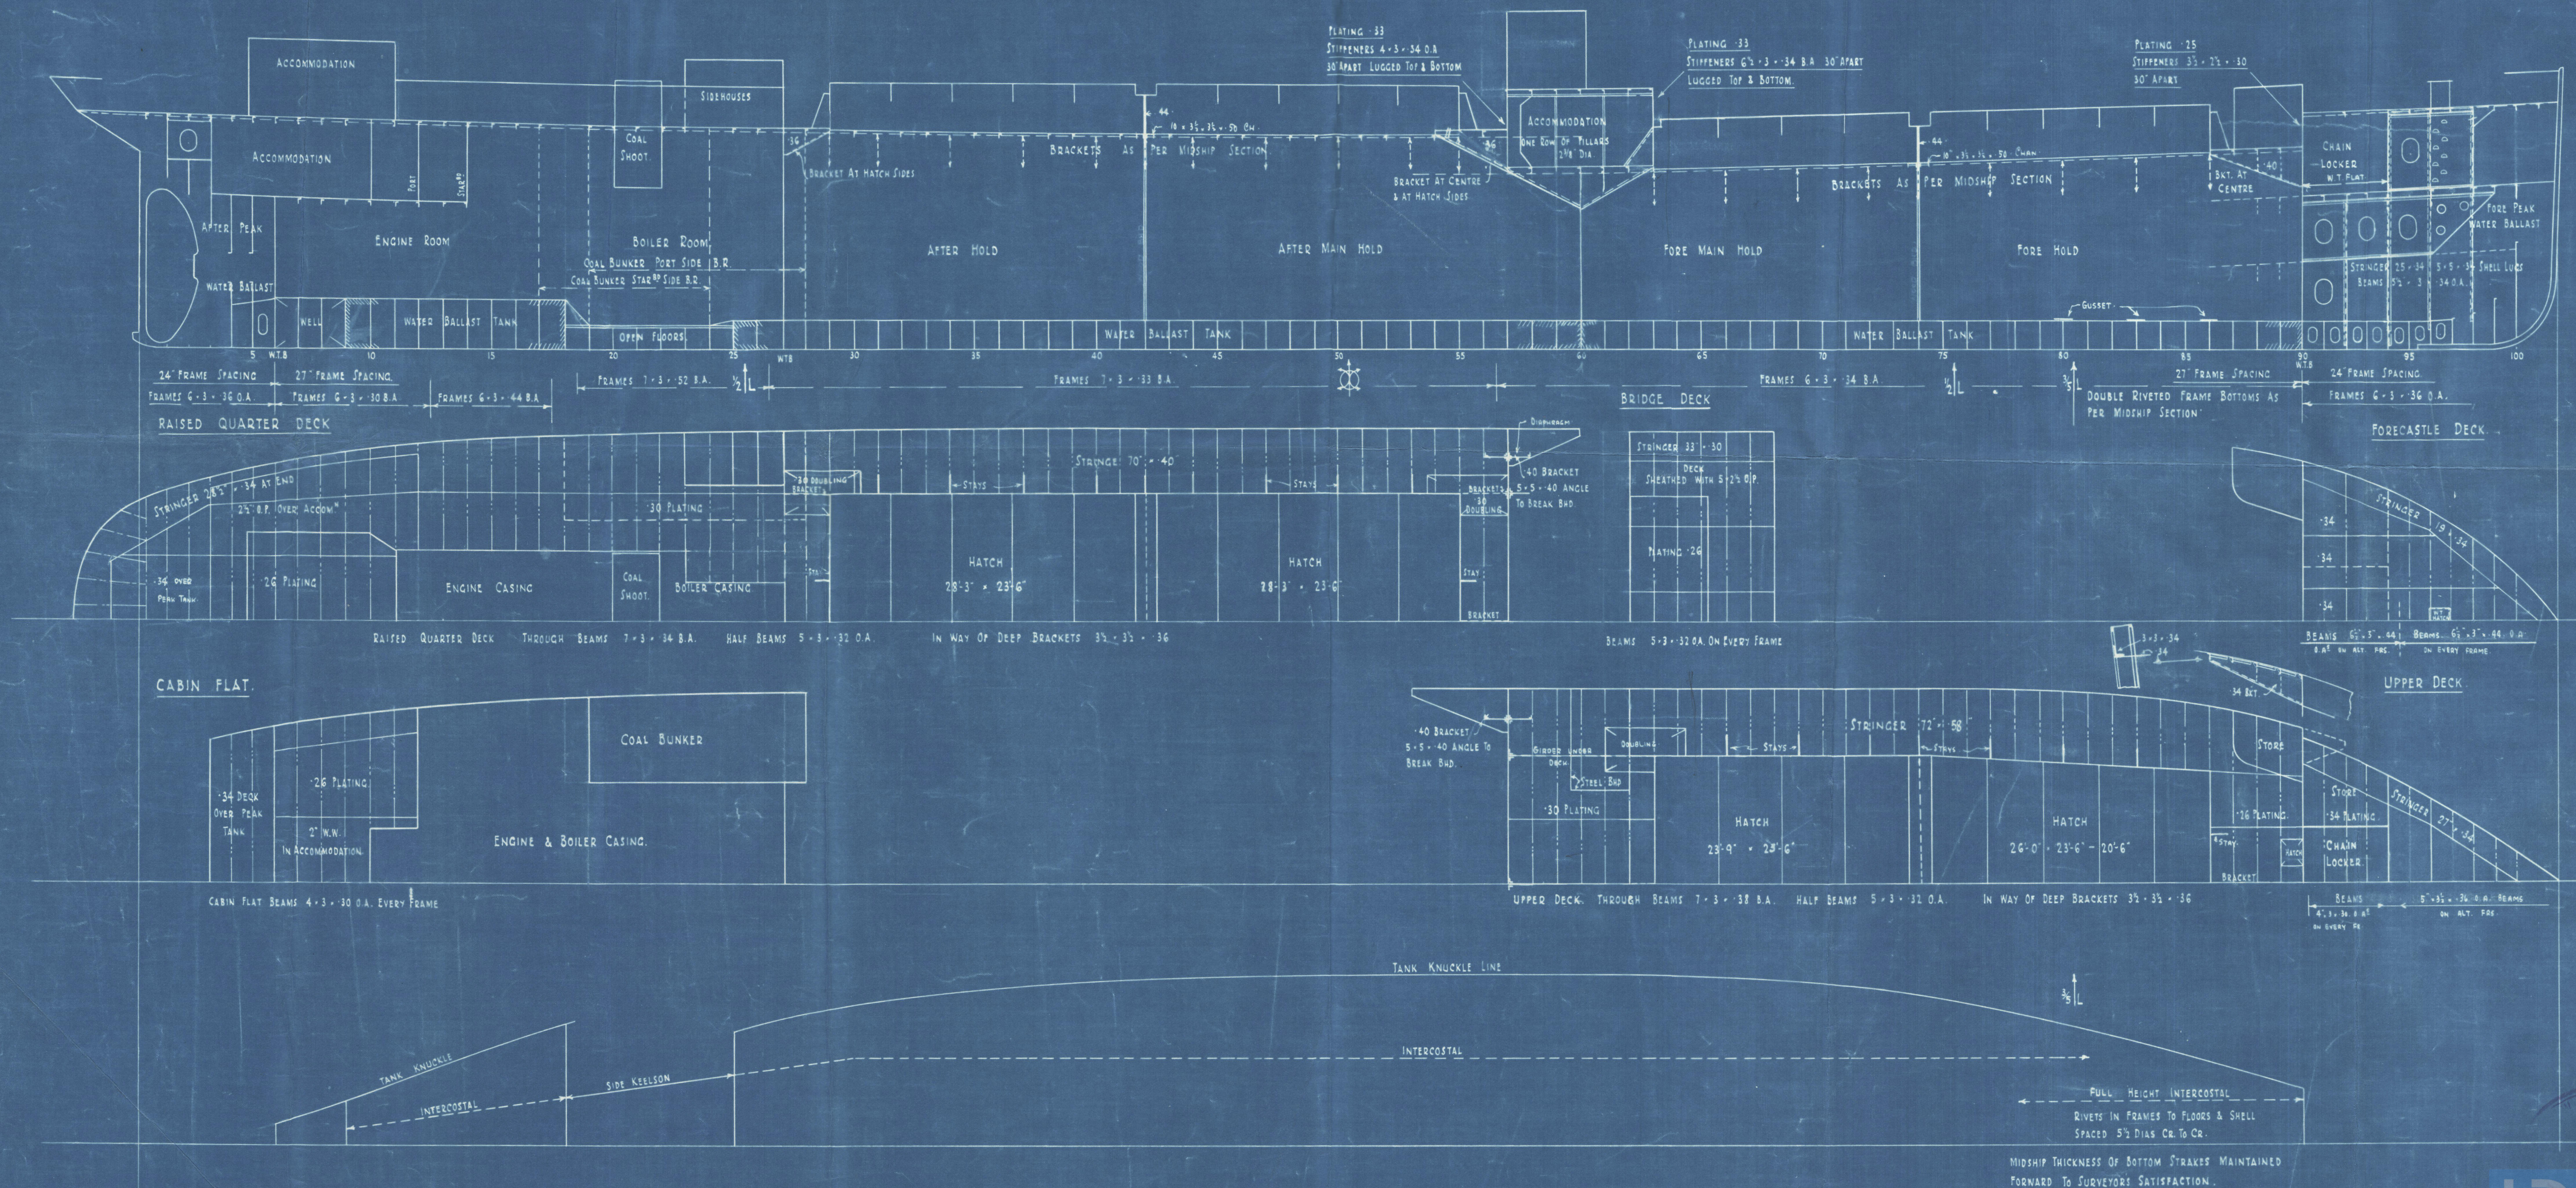



ENCLOSURE TO

© 2020  
*MESSRS. LLOYDS. (MR BROWN)*

34/02742.

FROM R. & W. HAWTHORN, LESLIE & CO. LTD.,  
HEBBURN-ON-TYNE.

2/2

10.

Hawthorn Leslies

567

Profile & Deck Plans  
as built

515. "WILLIAM CASH"

W S R I

Report No. 84798.

RETAIN



Lloyd's Register  
Foundation

005075-005081-0113 1/2