


CLASS: ENGLISH LLOYD 100 A1 SINGLE DECK STEEL

DIMENSIONS.

LENGTH P.P. ... m 54.3 = 178'-2" ENG.

BREADTH MOULDED ... 9.3 m = 30'-6 1/8"

DEPTH MOULDED ... 4.575 m = 15'-0"

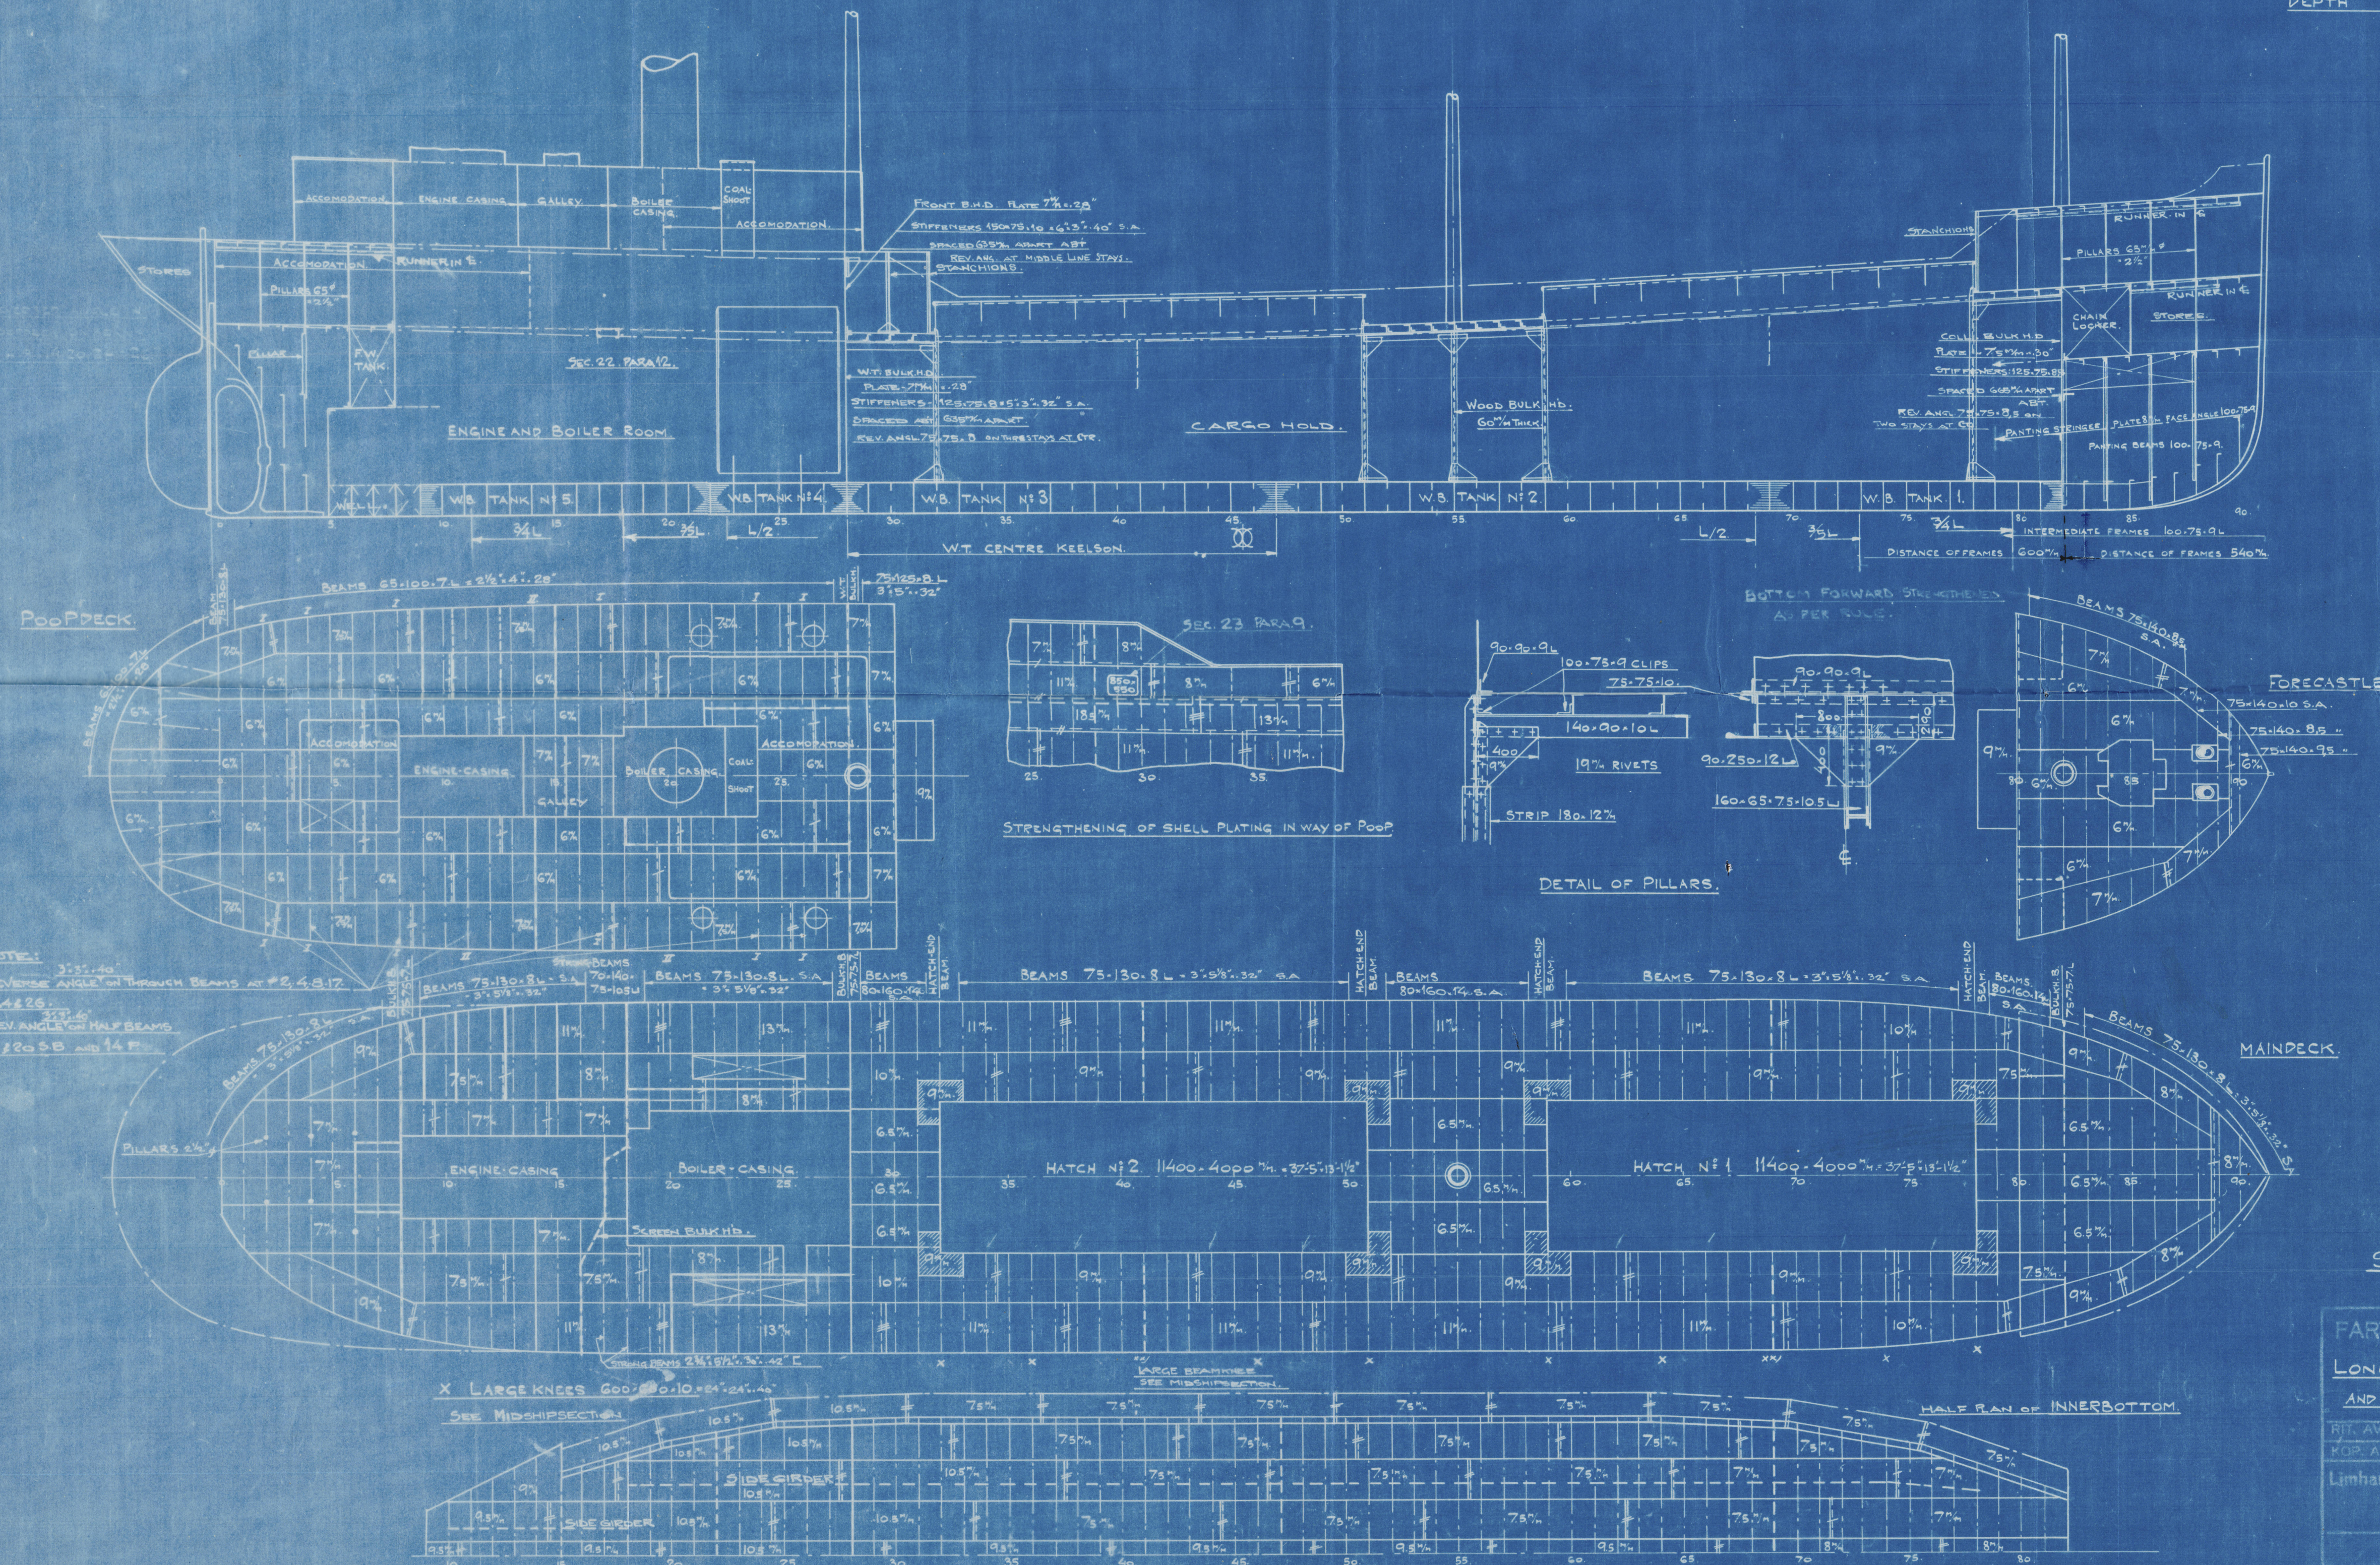

55" WATERWAY.

PART. No 14		Best No
LONGITUDINAL SECTION		SKALA: 1:100
AND PLANS.		1:25
RIT. AV.	GR. AV.	UTSLAG V.
KOP. AV.	GODK. AV.	PLATS. V.
Limhamns Skeppsvarv Aktiebolag		RIG.
DATUM 28-10-20.		TIMM V.
		SNICK V.
		MASK V.
		SMEDJA
		KOPFSL

R

Q.F. 848

005280-005292-0173




S.S. "Waterway"

Limhamns Skeppswarv's Yard No. 14.

Profile.  
Vessel as built.

Malinö F.E. Report No. 325.

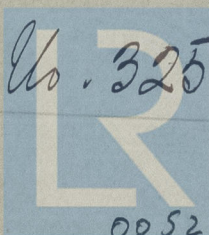

© 2021

Lloyd's Register

Foundation 005280-005292-0173