


T.S.M.S. GARONNE.

SCALE  $\frac{1}{2}" = 1'-0"$

DIMENSIONS: LENGHT B.P. 425'-0", BREADTH 58'-6", DEPTH 33'-3".

## BRACKETLESS SYSTEM PATENT.

LLOYD'S NUMERALS:  $L \times D = 13812$ ;  $L \times (B + D) = 38675$ ;  $L/D = 12.78$ .

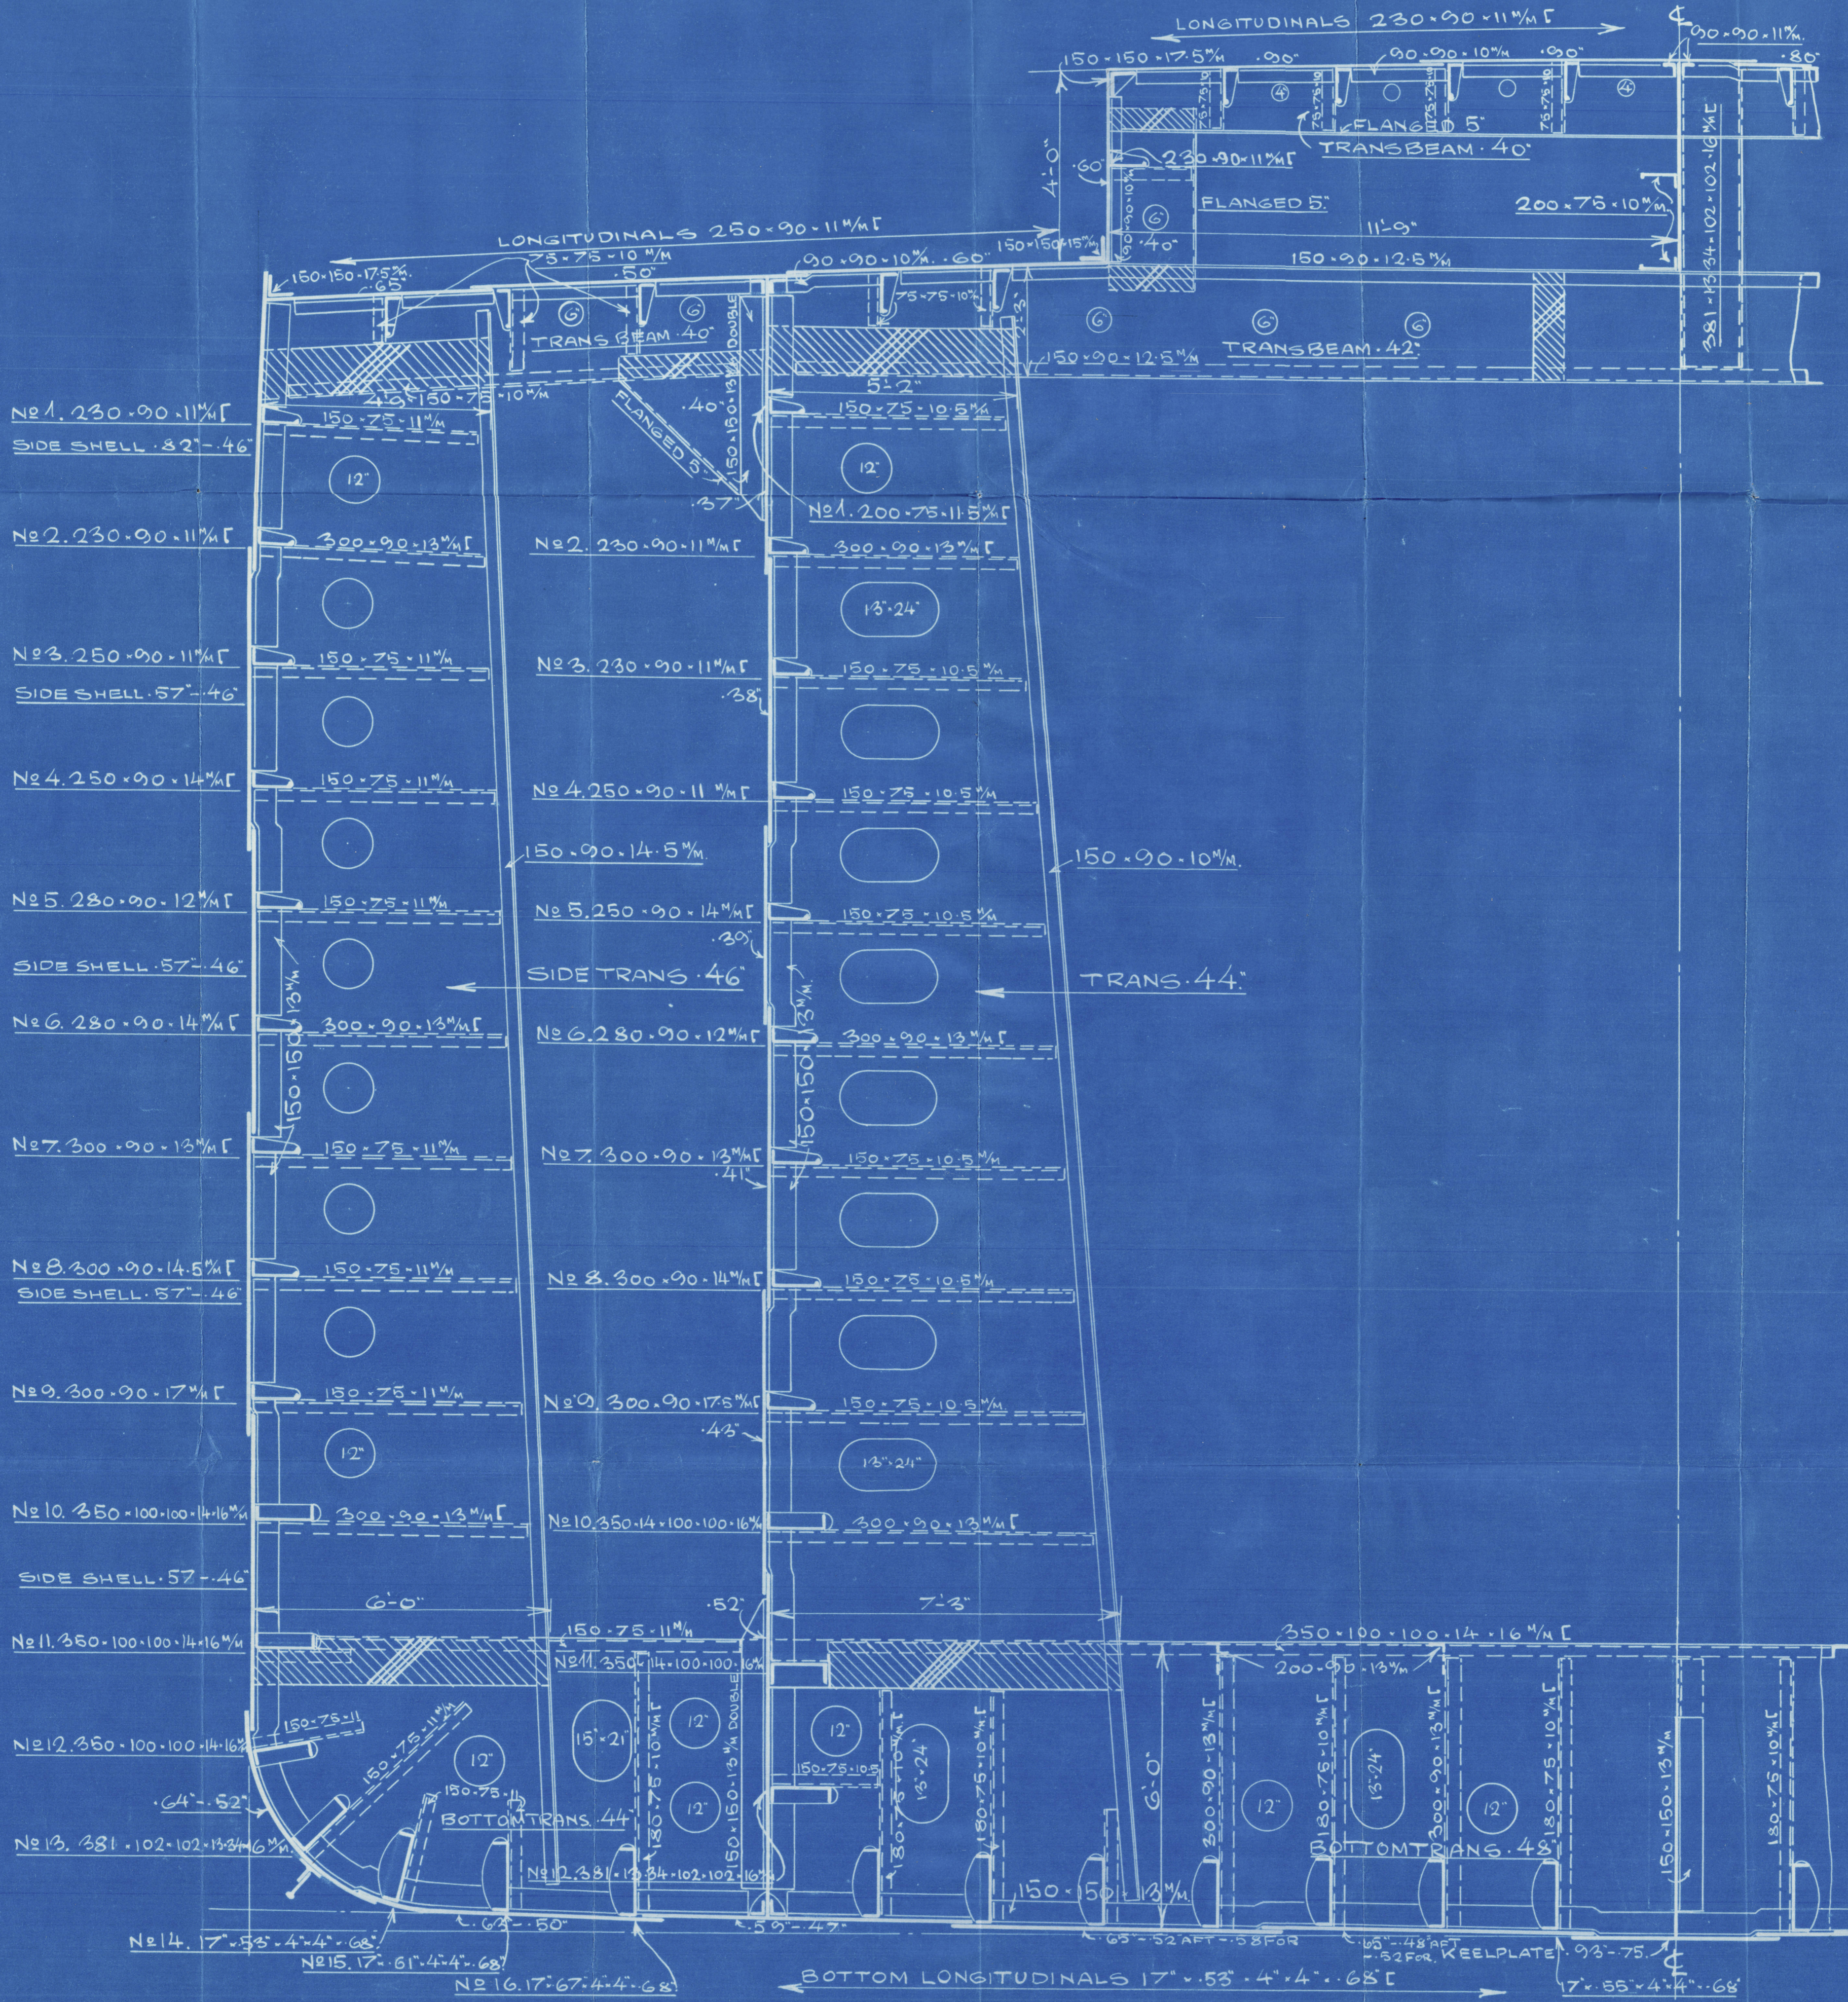

AKTIESELSKABET  
BURMEISTER & WAINZ  
MASKIN- & SKIBSBYGGERI

BYGNING NR. 204<sup>1/2</sup> 56 GARONNE  
TEGNING NR. 205  
TEGNET AF *for*  
KALKERET AF *ob*  
EPTEGSET AF  
DATO 9-3-31  
SKALA 1/2" = 1'-0"

MIDSHIP SECTION


MIDSHIP SECTION (AS BUILT)

M.TANKER "GARONNE"


YARD N<sup>o</sup> 594.

MESSRS BURMEISTER & WAIN,

---

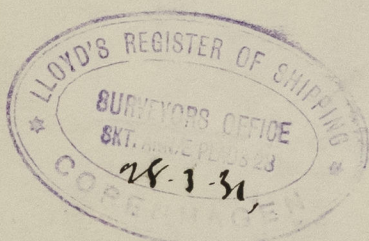

COPENHAGEN REPORT N<sup>o</sup> 8463.

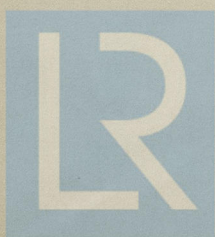

© 2020

Lloyd's Register  
Foundation

005353-005357-0132