


Midship Section.

Scale $\frac{1}{2}'' = 1 \text{ foot}$.

POOP 33'-6". BRIDGE 256'-6". FORECASTLE 33'-6".

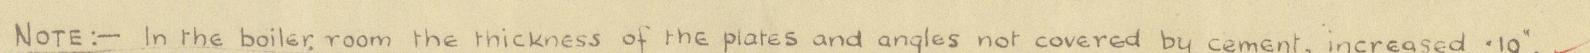

© 2020
Lloyd's
Founda

Mess^r. Bartram No. 270
Midship Section
As Built.

BHARATJAL
S/s. ^{EX} Harpenden

SUNDERLAND RPT. NO. 30455.

RETAIN



© 2020

Lloyd's Register
Foundation

005387-005396-0263