

No 3 S.S. "Rigi"

MIDSHIP SECTION

LLOYDS DIMS: LENGTH B.P. ON UPPER DECK 399'6", BREADTH 17'52"66", DEPTH 11'26"92"

TO CLASS 100 A1 LLOYDS. SHELTER DECK WITH FREEBOARD.


SCALE 1/2" = 1' FOOT.

NUMERALS

BREADTH M.O.	52.66
DEPTH	26.92
+ 5 FOR 8'6" TWEEN DECK	50
TRANSVERSE NUMBER	80.08
LENGTH B.P.	399.6
LONGITUDINAL NUMBER	31999
ERECTOR'S CASINGS ETC	3617
EQUIPMENT NUMBER	35616
LENGTH + DEPTH TO SHELTER DECK	11.28
	23.34

EQUIPMENT

2 BOWER ANCHORS EACH	63 CWT'S STOCKLESS
1 ANCHOR	542
1 STREAM	172
1 KEDGE	72
220 FATHOMS	2 1/2" STUD CHAIN CABLE
90	4 1/2" STEEL WIRE
120	5
90	5
90	5
20 90	2 1/2"
	EX STOCK
	TOWLINE
	HAWSER

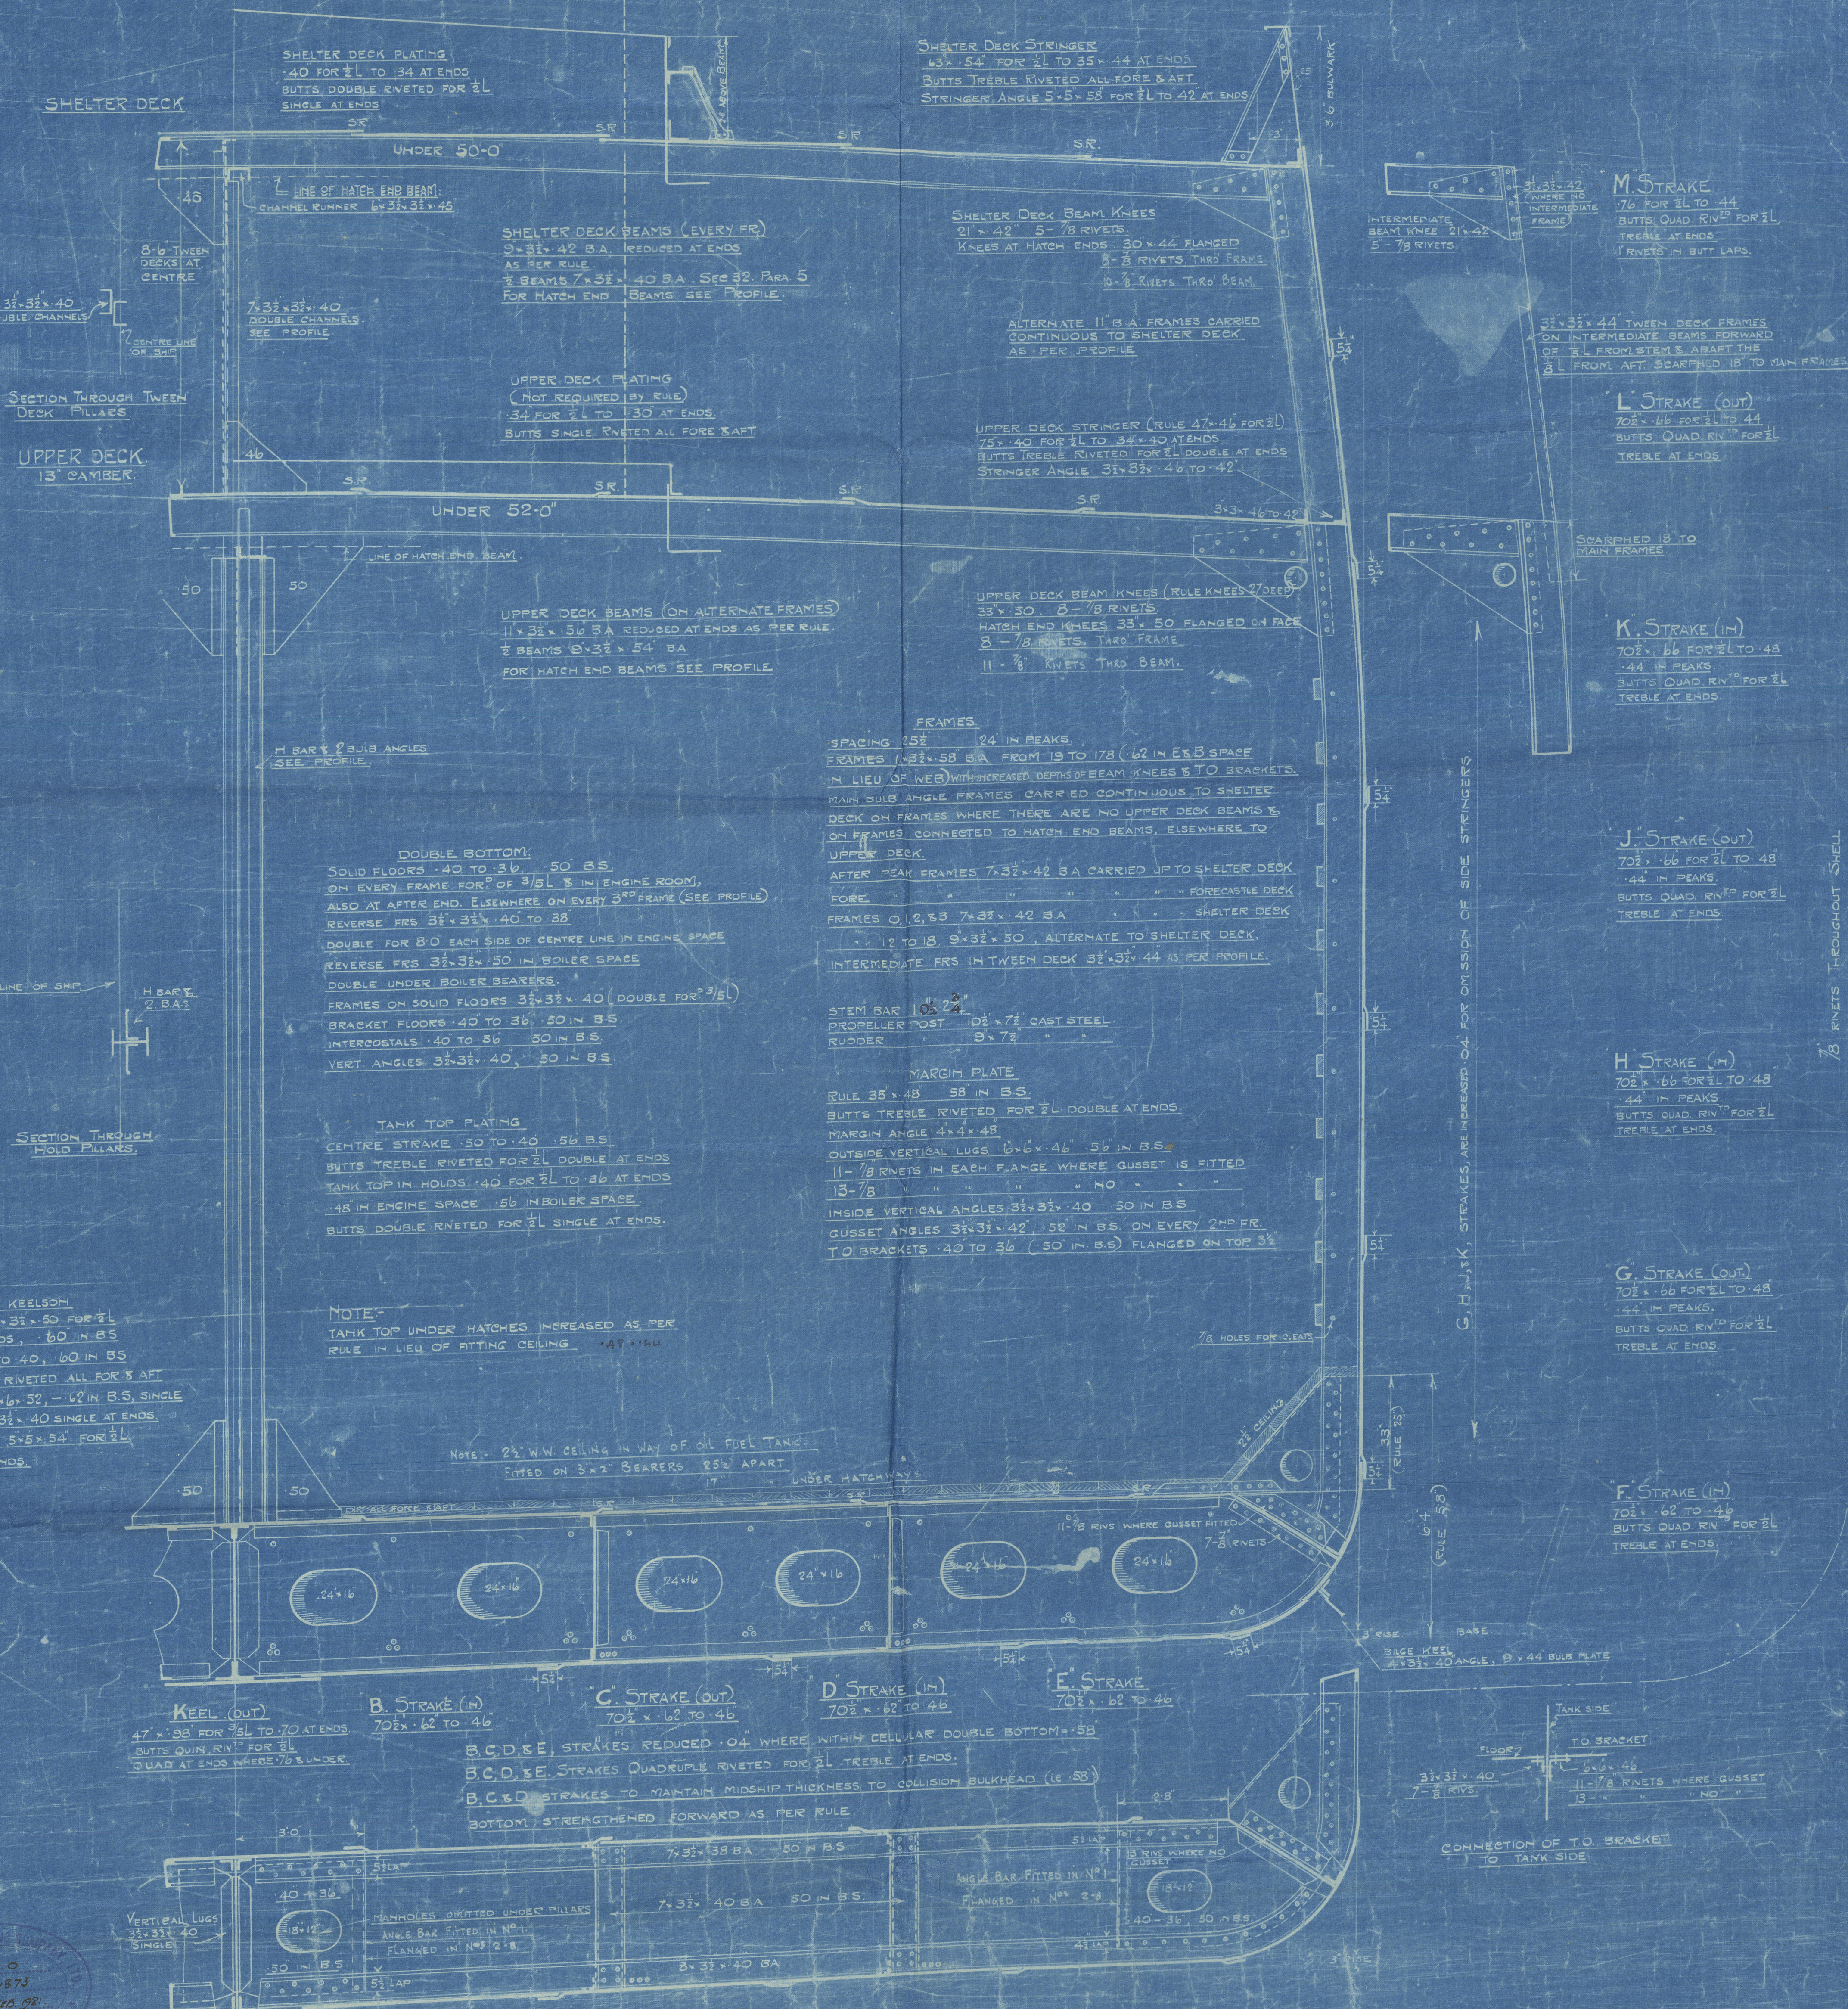

Mess^r Furness S. B 6^o 2

N^o 3

MIDSHIP SECTION

(AS BUILT)

S. S. "RIGI"

Nav. Rpt. No 1094^y



© 2021

Lloyd's Register

005726-005739-0184

Foundation