


SCALE 1/2" = 1 FOOT.

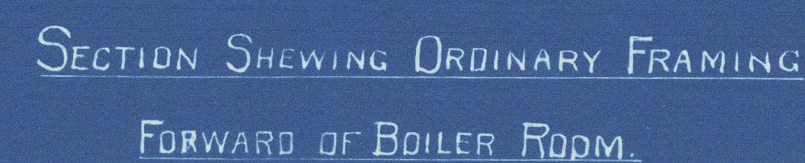

Workman Clark & Co


T.S.S. 242

Guidship Section
as built

T.S.S. Pata

Yard No 242

Belfast-report-no 6337.

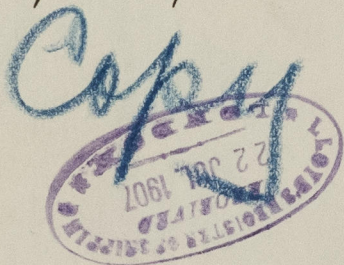

© 2020

Lloyd's Register
Foundation

006489-006504-0190