

FLEMING & FERGUSON LTD
SHIPBUILDERS & ENGINEERS
PHOENIX WORKS
PAISLEY

YARD No 550
SECTIONS
MOTOR FERRYBOAT.

DIMENSIONS :- 166'-0" x 36'-0" x 8'-3" BREADTH OVER SPONSONS 49'-4"

LLOYDS CLASS A "FOR SERVICE ON THE RIVER TAY."

SCALE :- 1/2 INCH = 1 FOOT.

EQUIPMENT.

ONE BOWER ANCHOR STOCKLESS 8 CWTs
60 FMS 1 5/8" DIA STUD LINK CHAIN

TWO COILS EACH 90 FMS. 5/4 CIRC. MANILLA ROPE
TWO COILS EACH 60 FMS. 5/4 CIRC. MANILLA ROPE
4 HEAVING LINES 20 FMS. EACH

LLOYDS NUMERALS

L x D =



L x (B + D) =

L/D = 20 d = 7.59

LOAD DRAFT 5'-1" S.W.

RIVETING

BUTTS OF KEEL PLATE STRAPPED & TREBLE RIVETED FOR 1/2 L TO DOUBLE AT ENDS
BUTTS OF SHEERSTRAKE LAPPED & TREBLE RIVETED FOR 1/2 L TO DOUBLE AT ENDS
BUTTS OF DECK STRINGER PLATE LAPPED & TREBLE RIVETED FOR 1/2 L TO DOUBLE RIVETED AT ENDS
BUTTS OF REMAINDER OF SHELL PLATING LAPPED & DOUBLE RIVETED THROUGHOUT
BUTTS OF DECK PLATING LAPPED & DOUBLE RIVETED FOR 1/2 L TO SINGLE RIVETED AT ENDS
SEAMS OF SHELL PLATING LAPPED & SINGLE RIVETED
SEAMS OF DECK PLATING LAPPED & SINGLE RIVETED

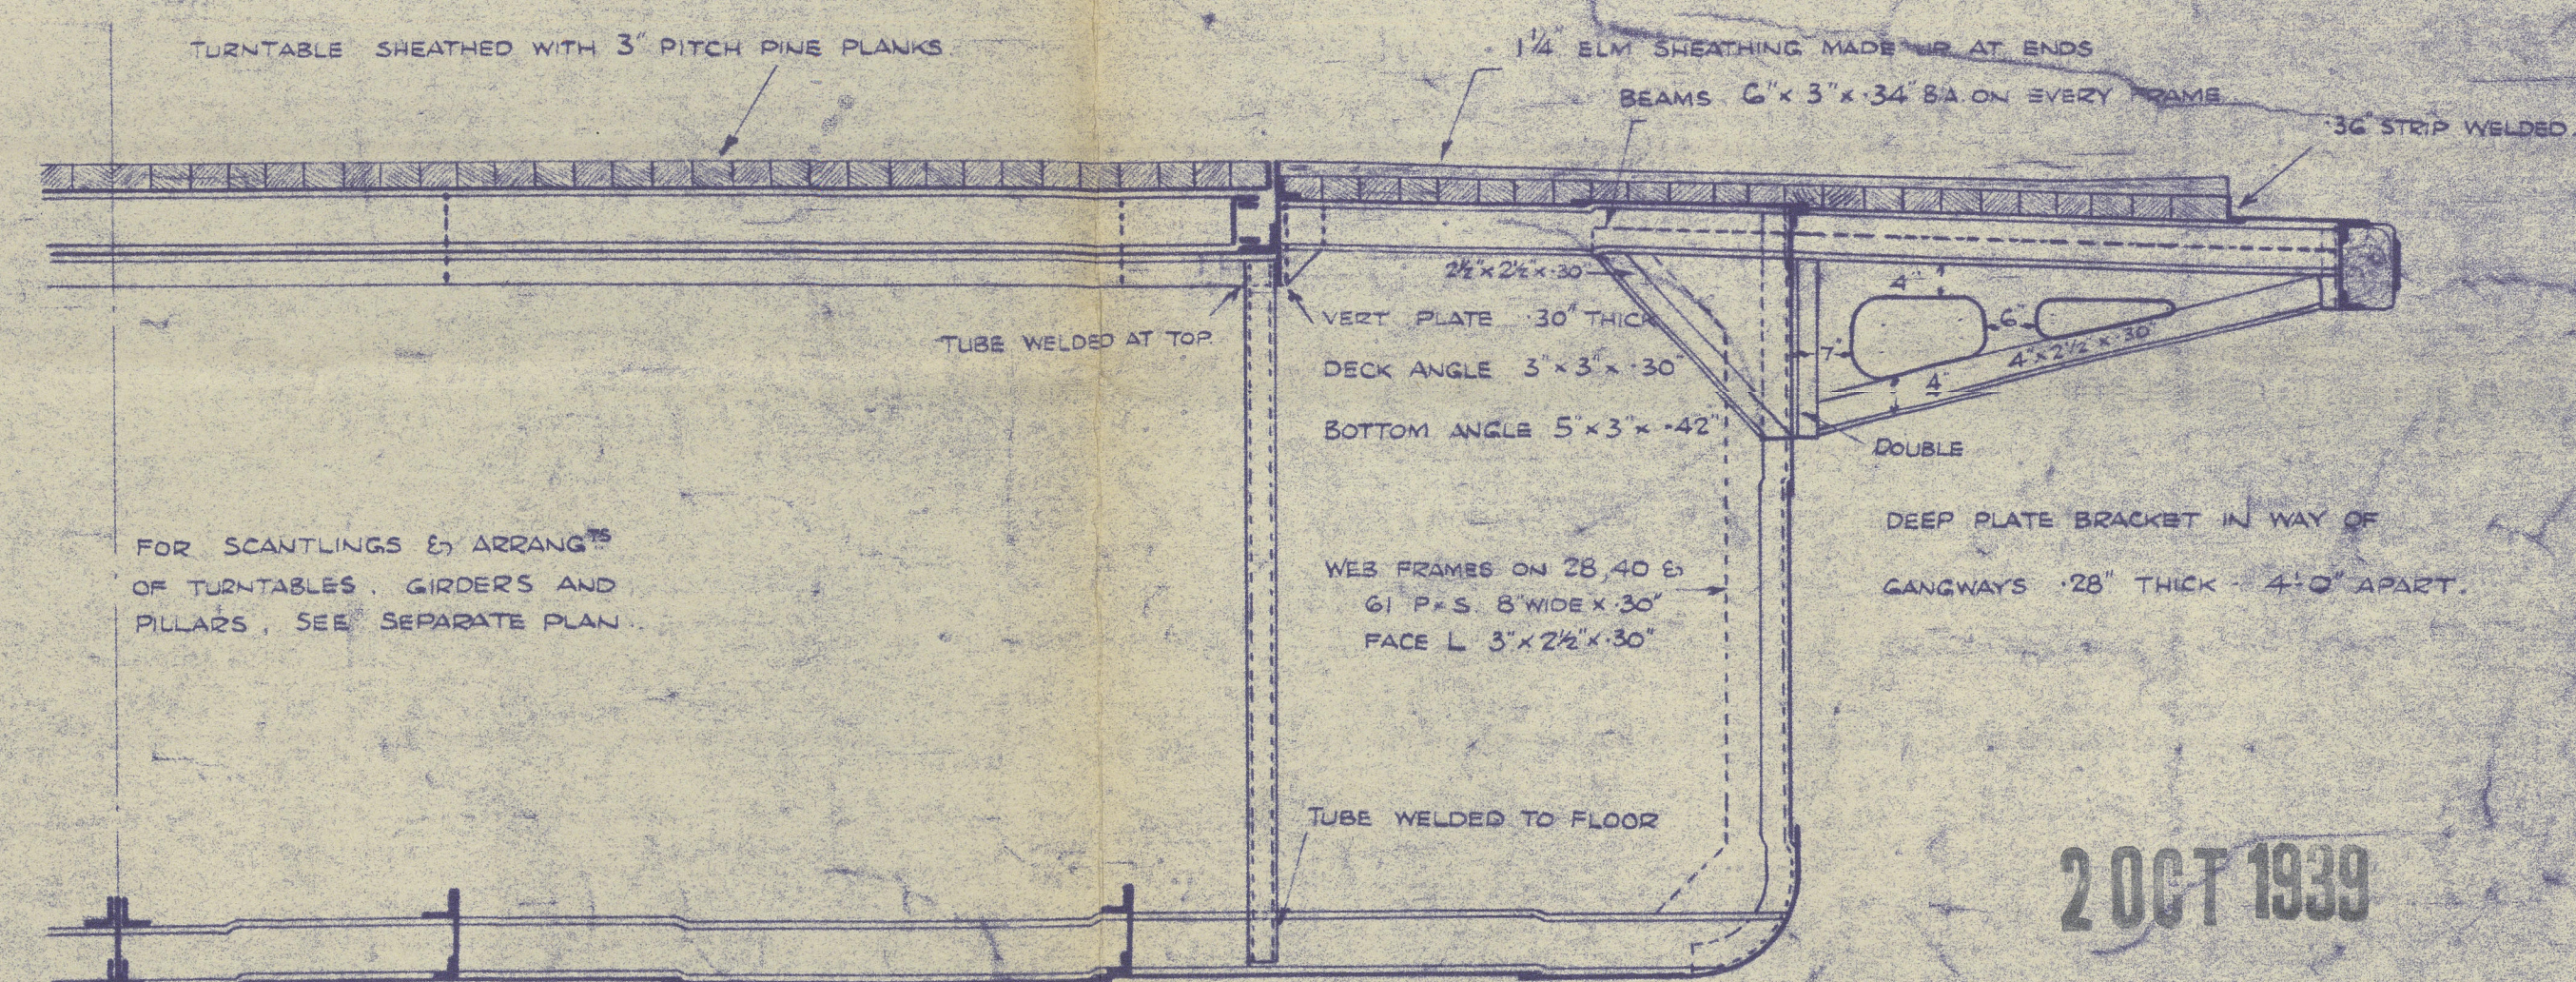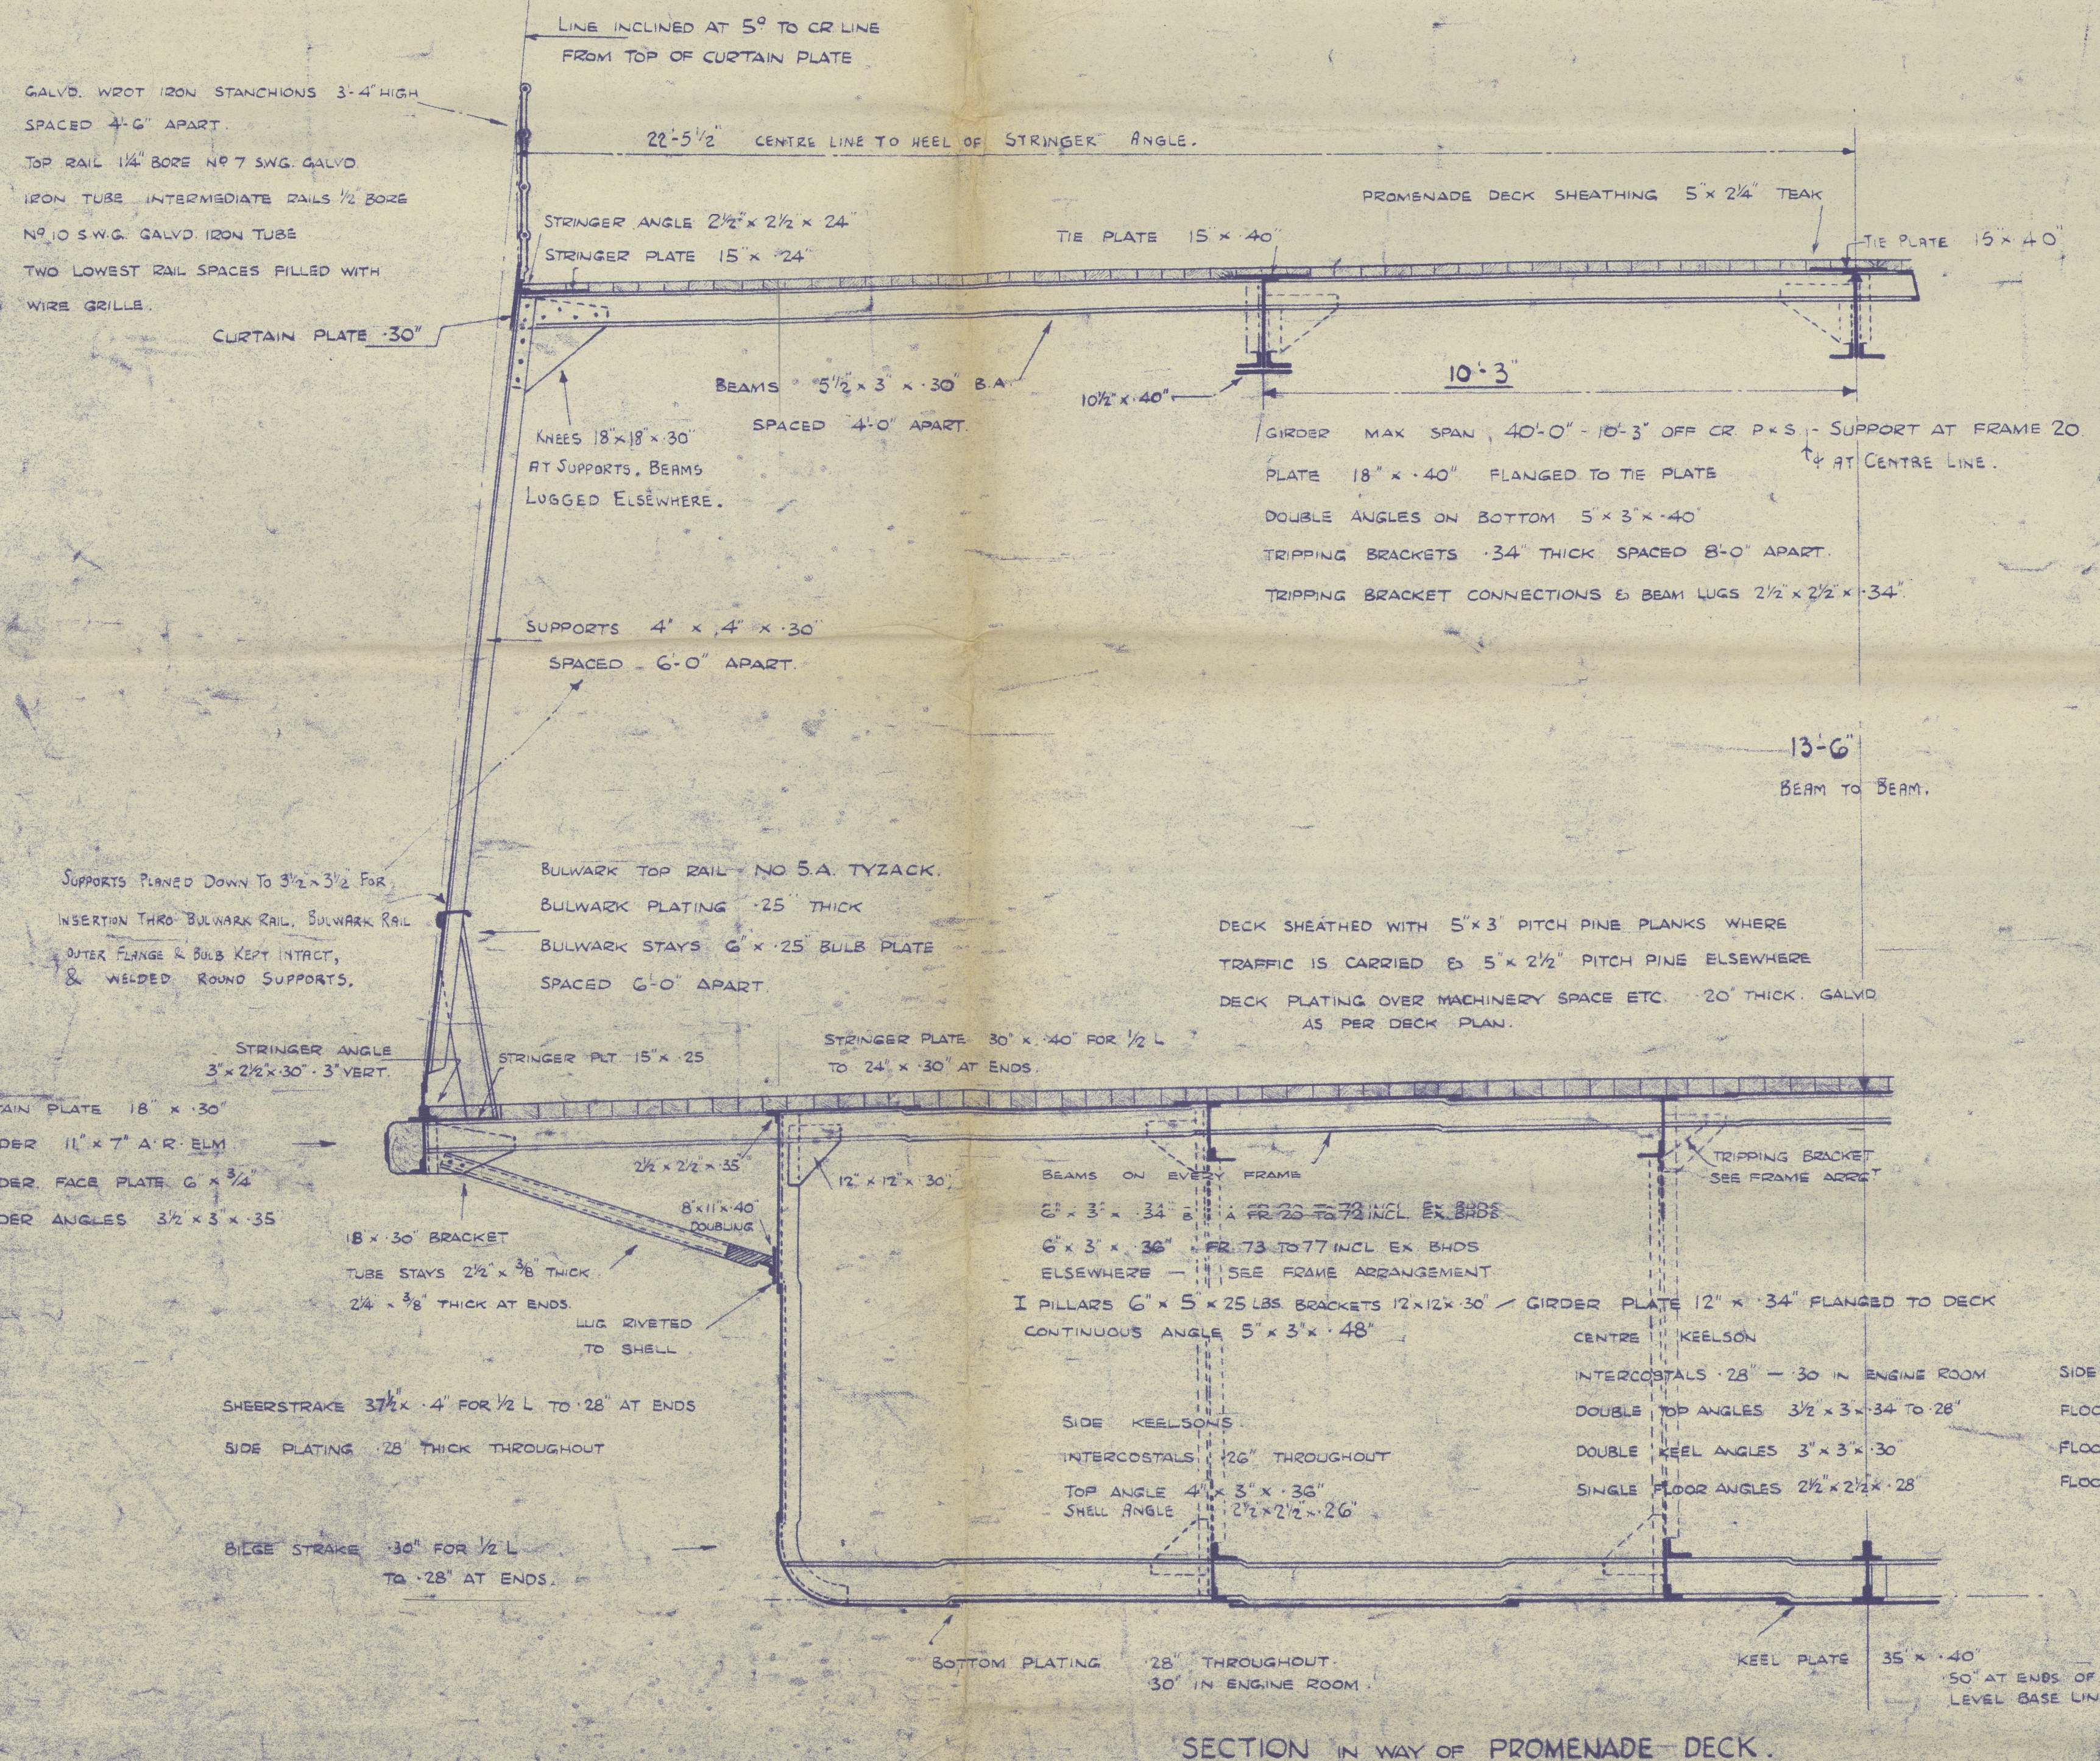

2 OCT 1939



550

21

Fleming & Ferguson Ltd

550

Midship Section
(as built)

Abercraig

GLASGOW REPORT No. 61681



© 2021

Lloyd's Register
Foundation

006797 - 006808 - 0243