

# SHIP No 171

## MIDSHIP TRANSVERSES. Nos 43, 55, 67, 79 & 91


SCALE :-  $\frac{3}{4}$ " = ONE FT

STARBOARD SIDE SHEWN. LOOKING AFT.

4 OFF. PORT SIDE.

4 OFF. STARBOARD SIDE.

1 OFF. PORT SIDE } AT FR. No 91, WITH  
1 OFF. STARBOARD SIDE } CORRECTIONS TO SUIT SHEER.

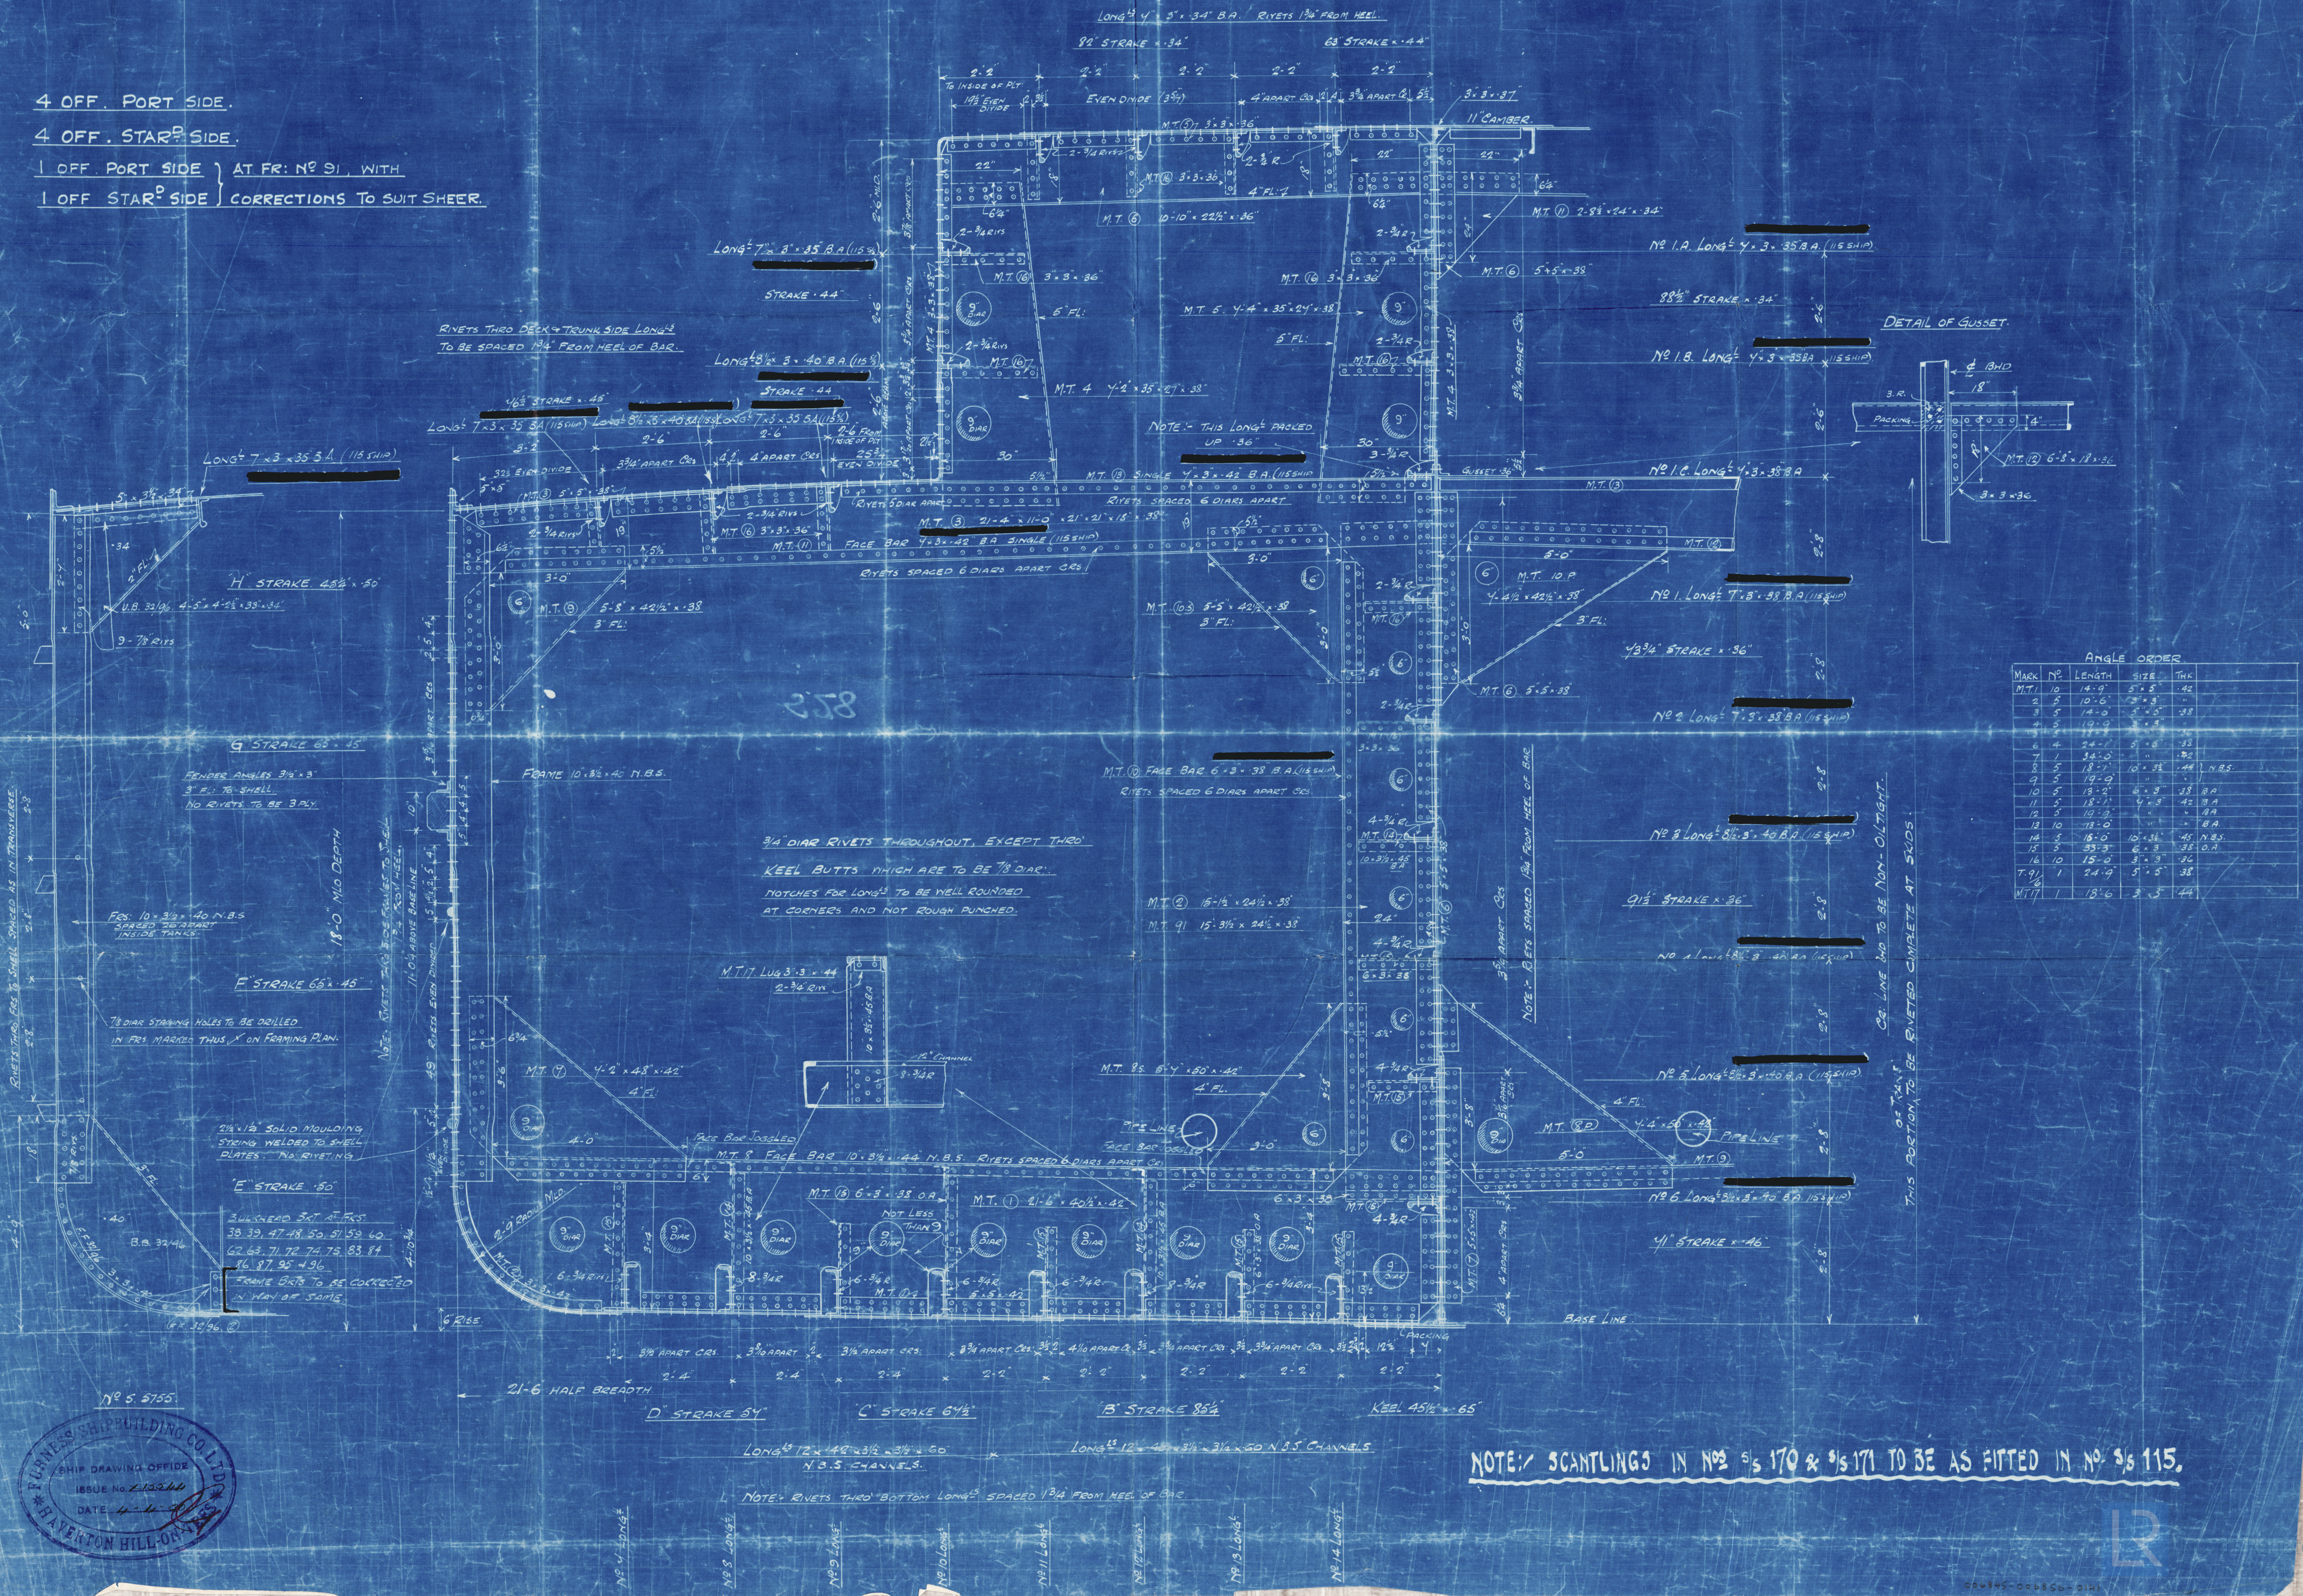



Messrs FURNESS S.B.C.

Nº 171

8/5 "SIMCOLITE"

MIDSHIP SECTION

AS BUILT

S.S. Simcolite

M.D.D. RPT. No. 14039

006845-006856-0141



© 2021

Lloyd's Register  
Foundation