

S.S. 171




OIL TANKER FOR THE GREAT LAKES.

PROFILE AND DECK PLANS.

DIMENSIONS: LENGTH B.P. 250'-0", BREADTH M-L 43'-0", DEPTH 18'-0"

SCALE 1/8" = 1 FOOT.

SHERWOOD COMBINATION SYSTEM.

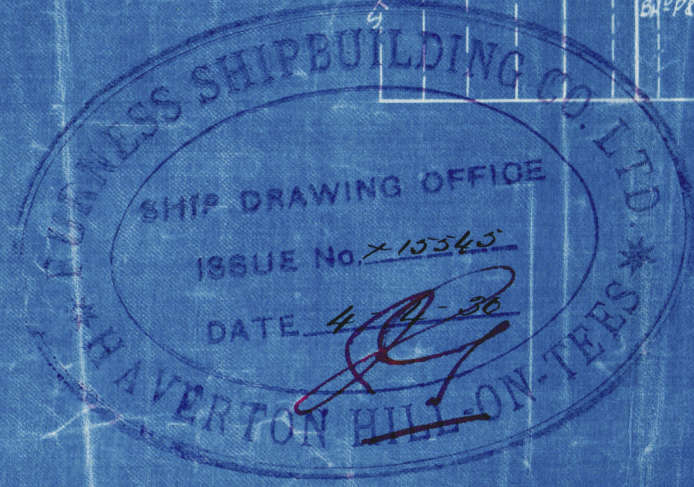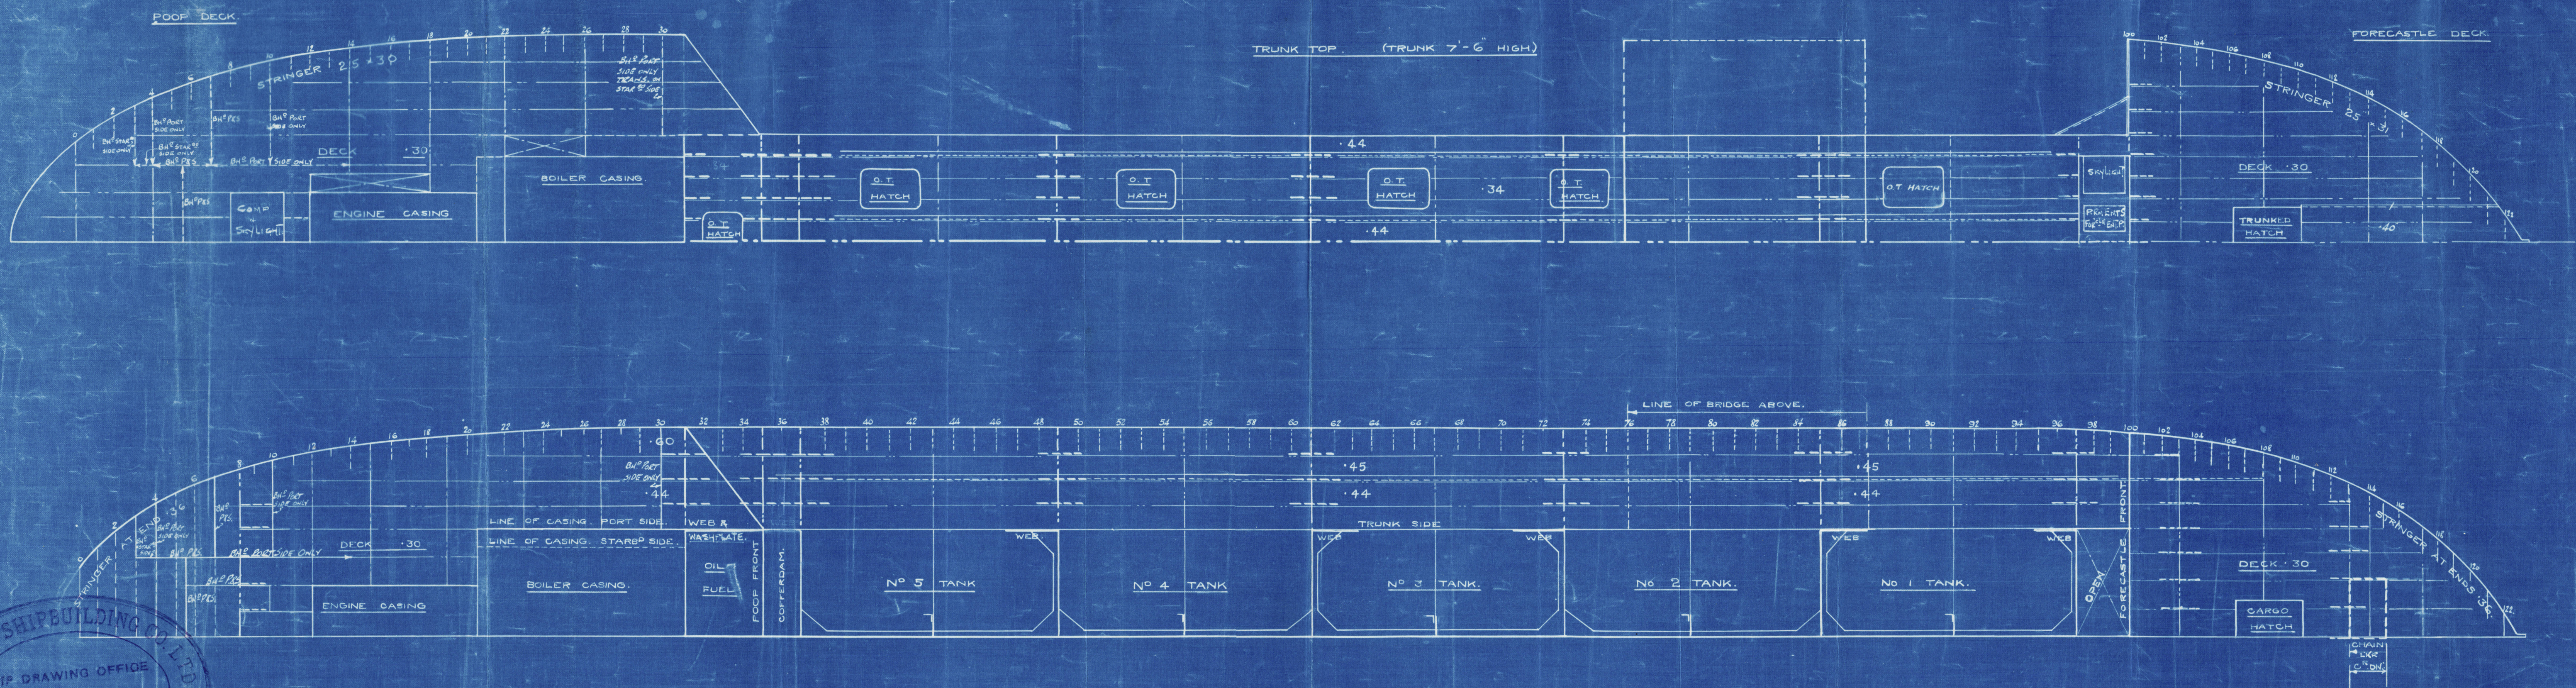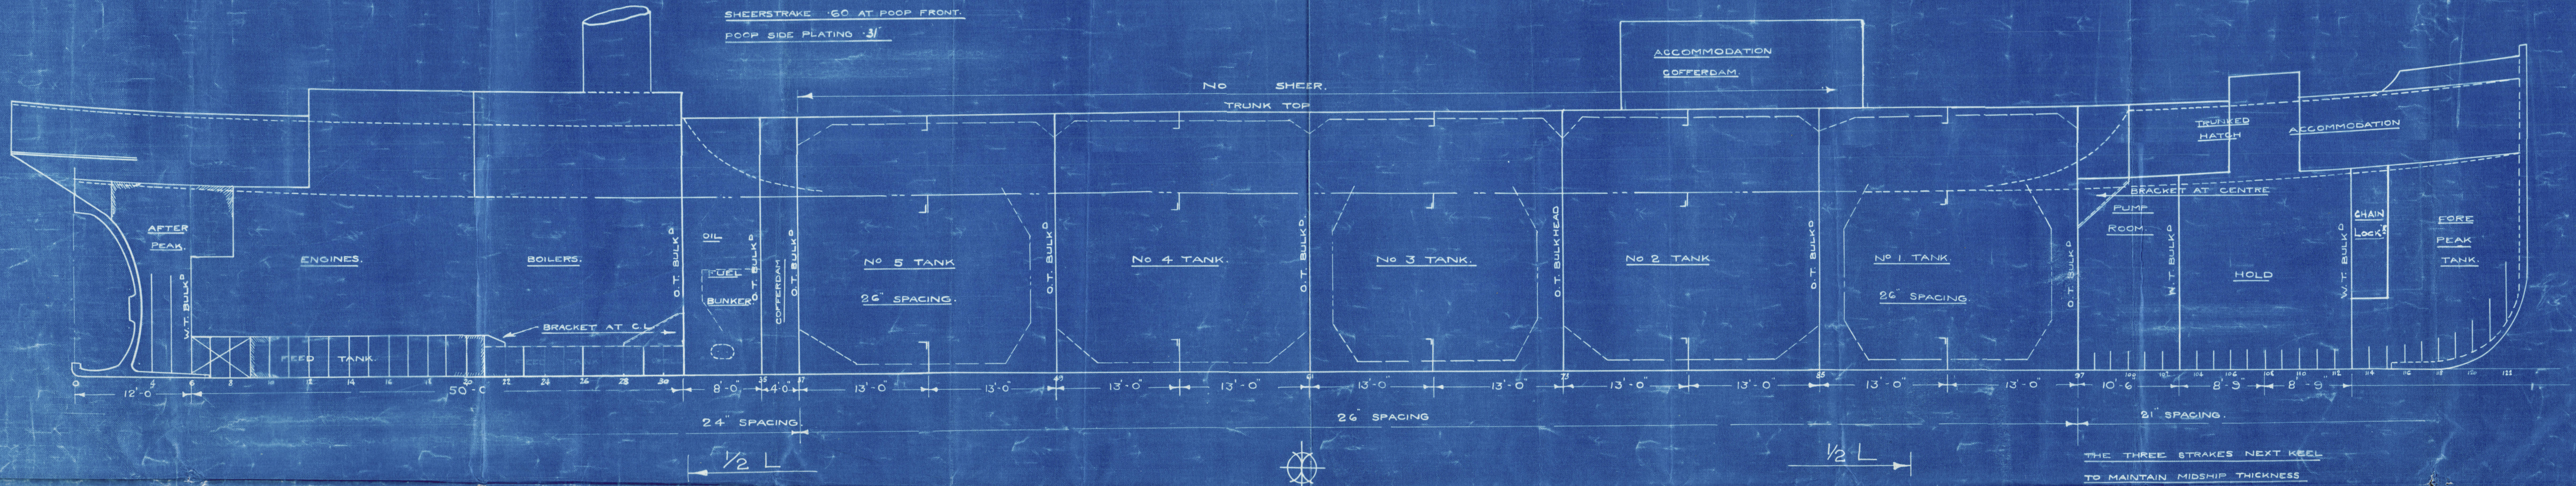

MESS^{RS} FURNESS S.B. CO.

Nº 171

S/S "SIMCOLITE"

PROFILE + DECK PLANS

AS BUILT

S.S. Simcolite
MDB. RPT. Nº 14039



© 2021

Lloyd's Register
Foundation

006845-006856-0142