
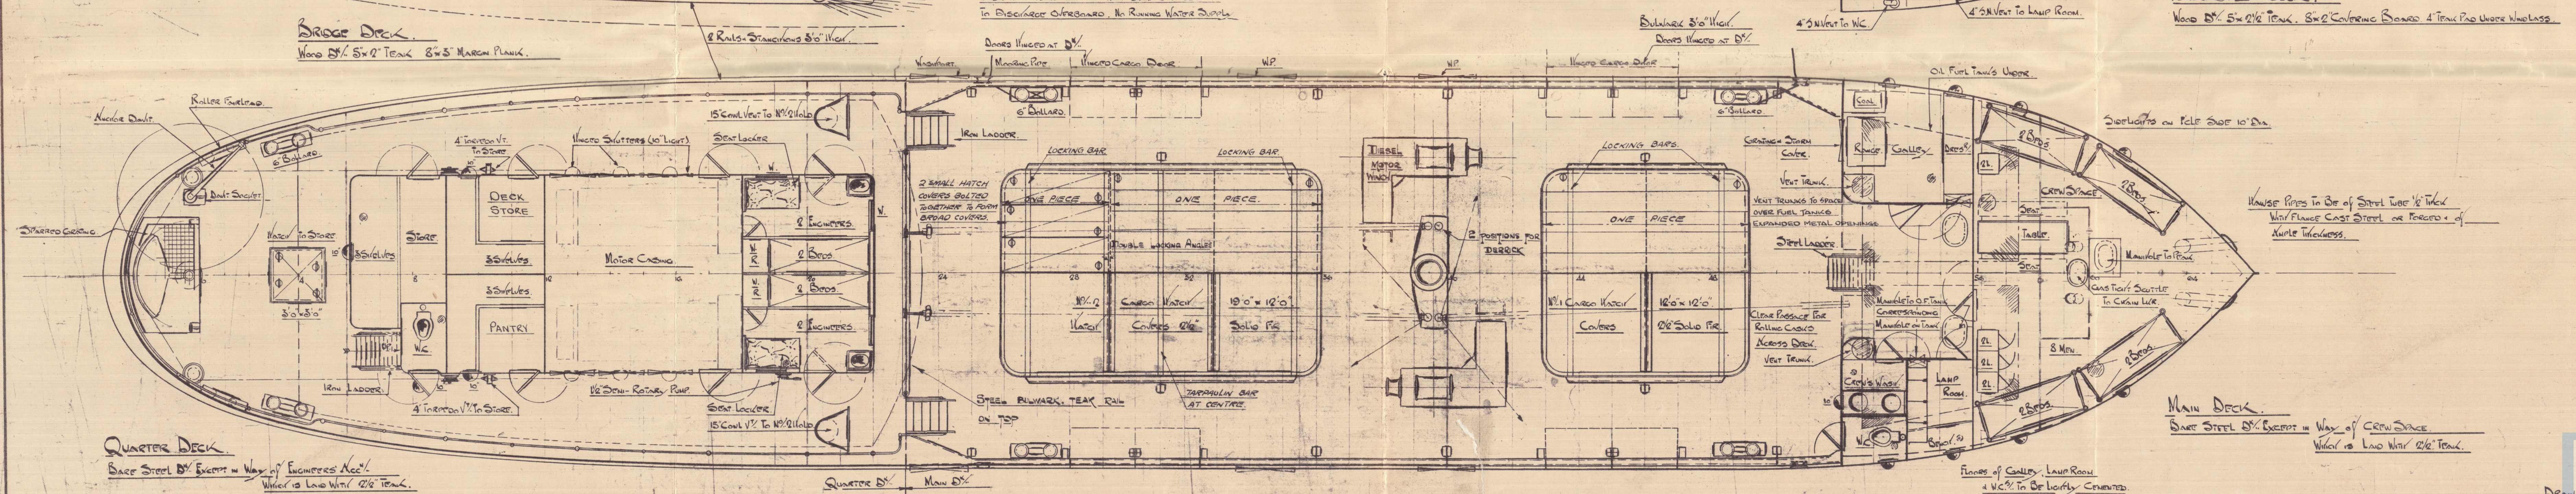
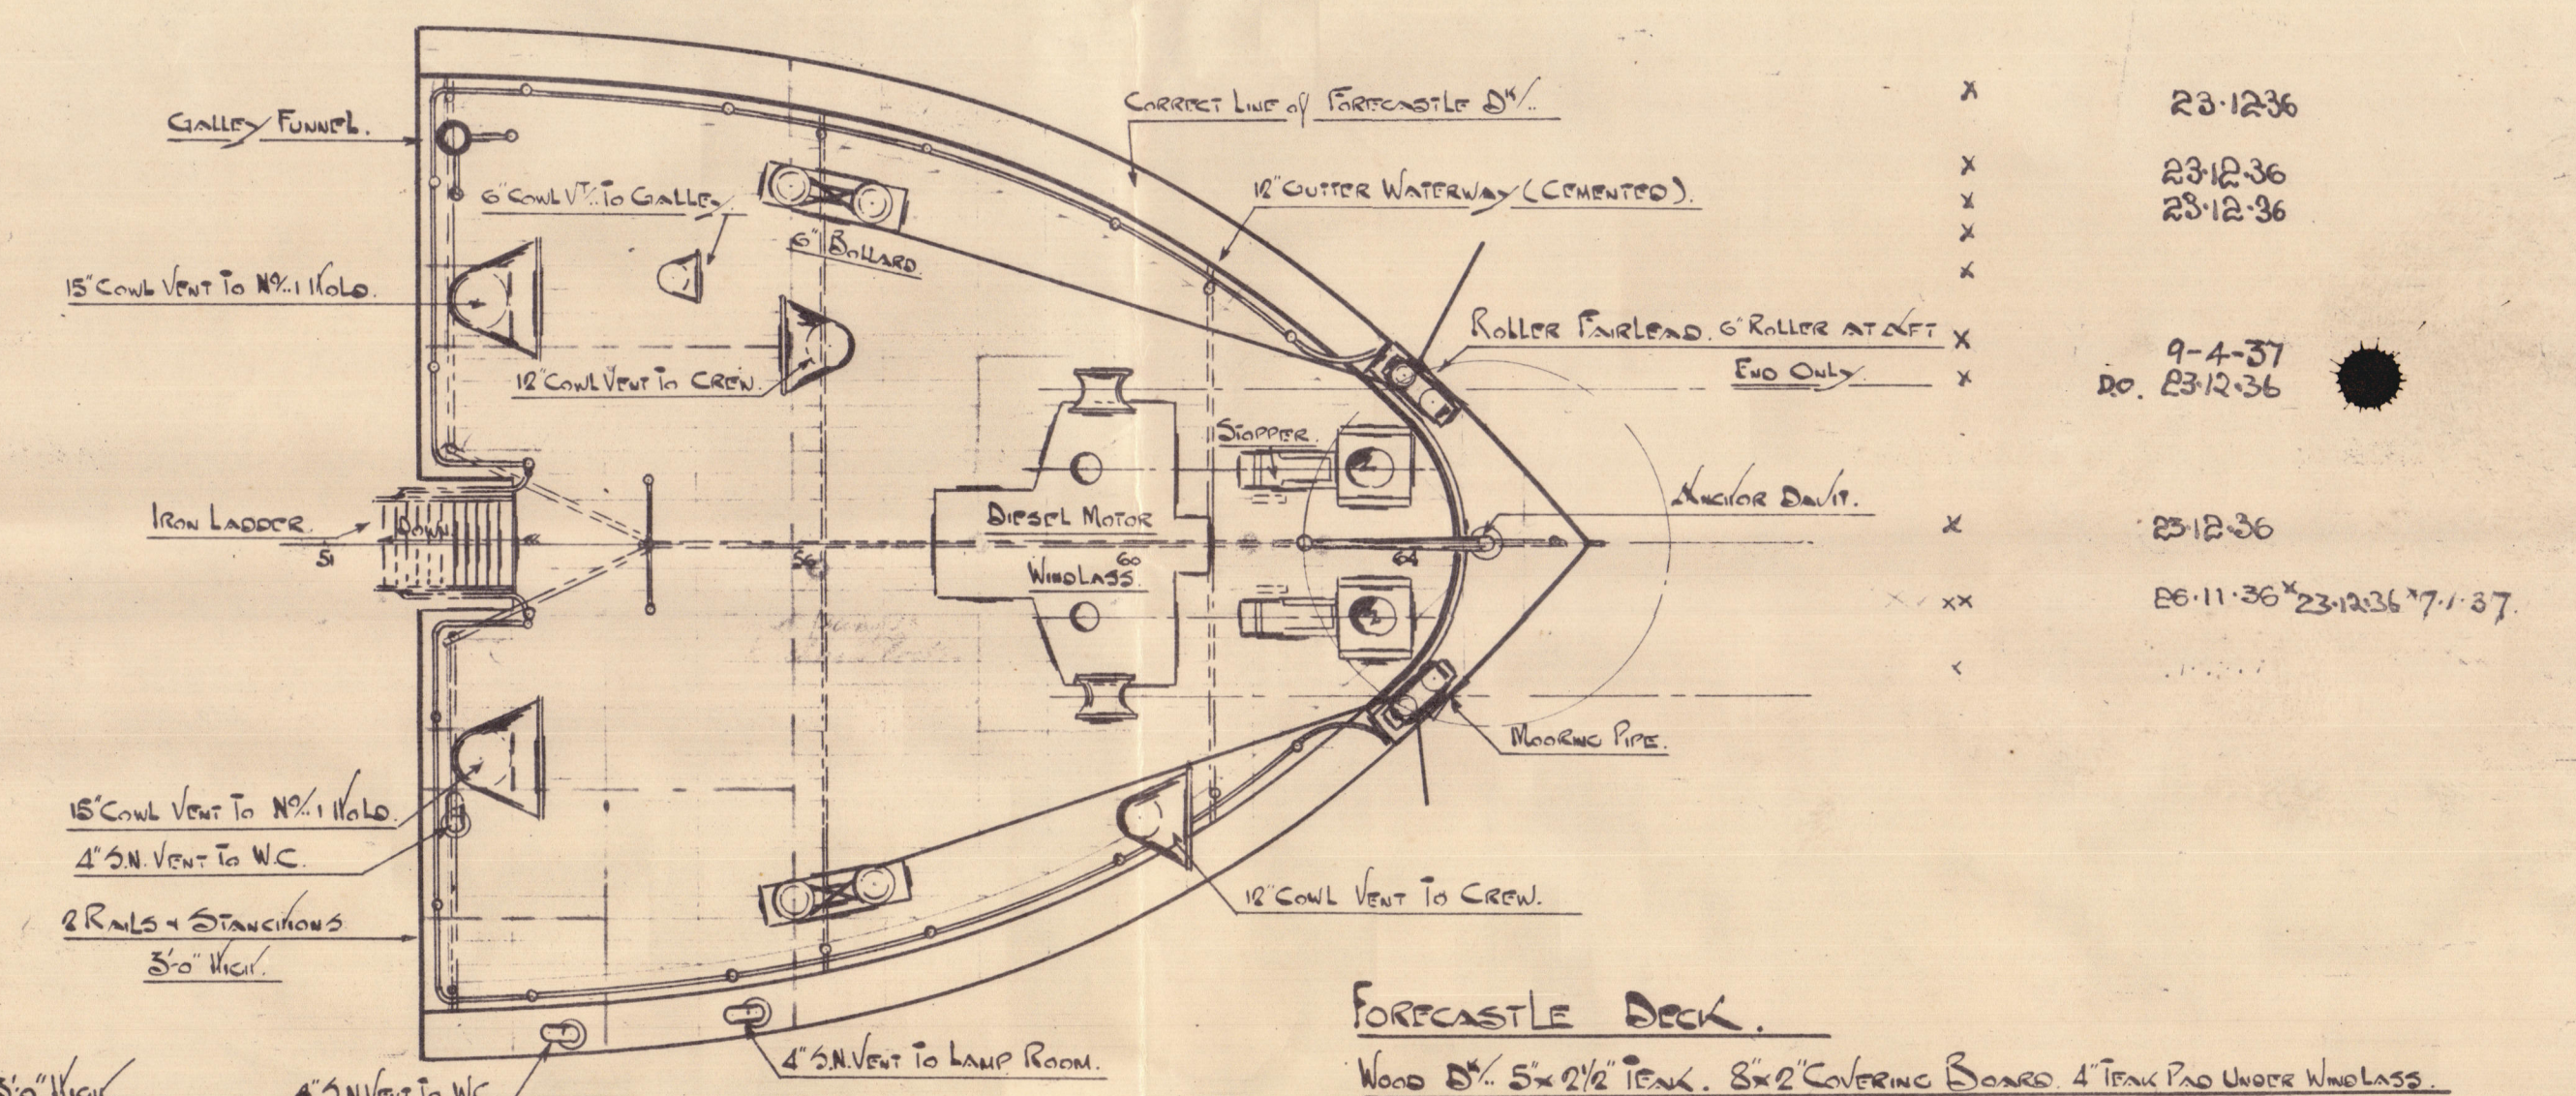
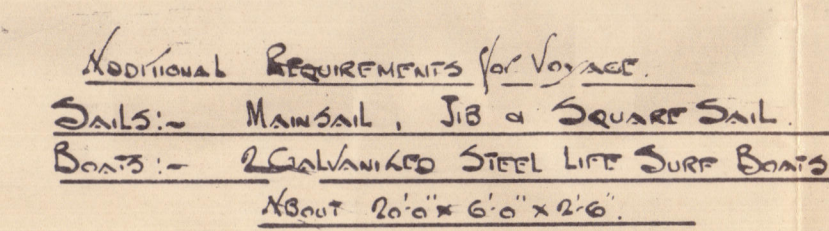


GENERAL ARRANGEMENT.

MOULDED DIMENSIONS:- 125'-0" x 24'-0" x 9'-6".

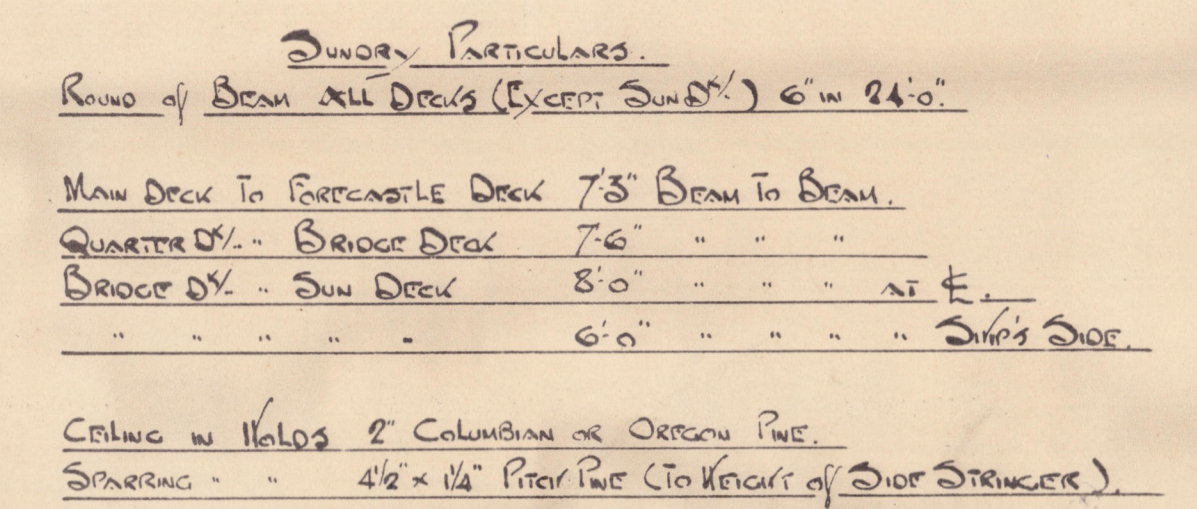

Henry Robb 2^d
N^o 242

General Arrangement
as built

Lith Plat. N^o 19587

M.V. "A.A. COWAN"



© 2021

Lloyd's Register
Foundation

006877-006888-0174