




S.S. No. 779
 OUTLINE PLAN SHOWING BULKHEADS ETC.
 SCALE 1/6" = 1 FT.

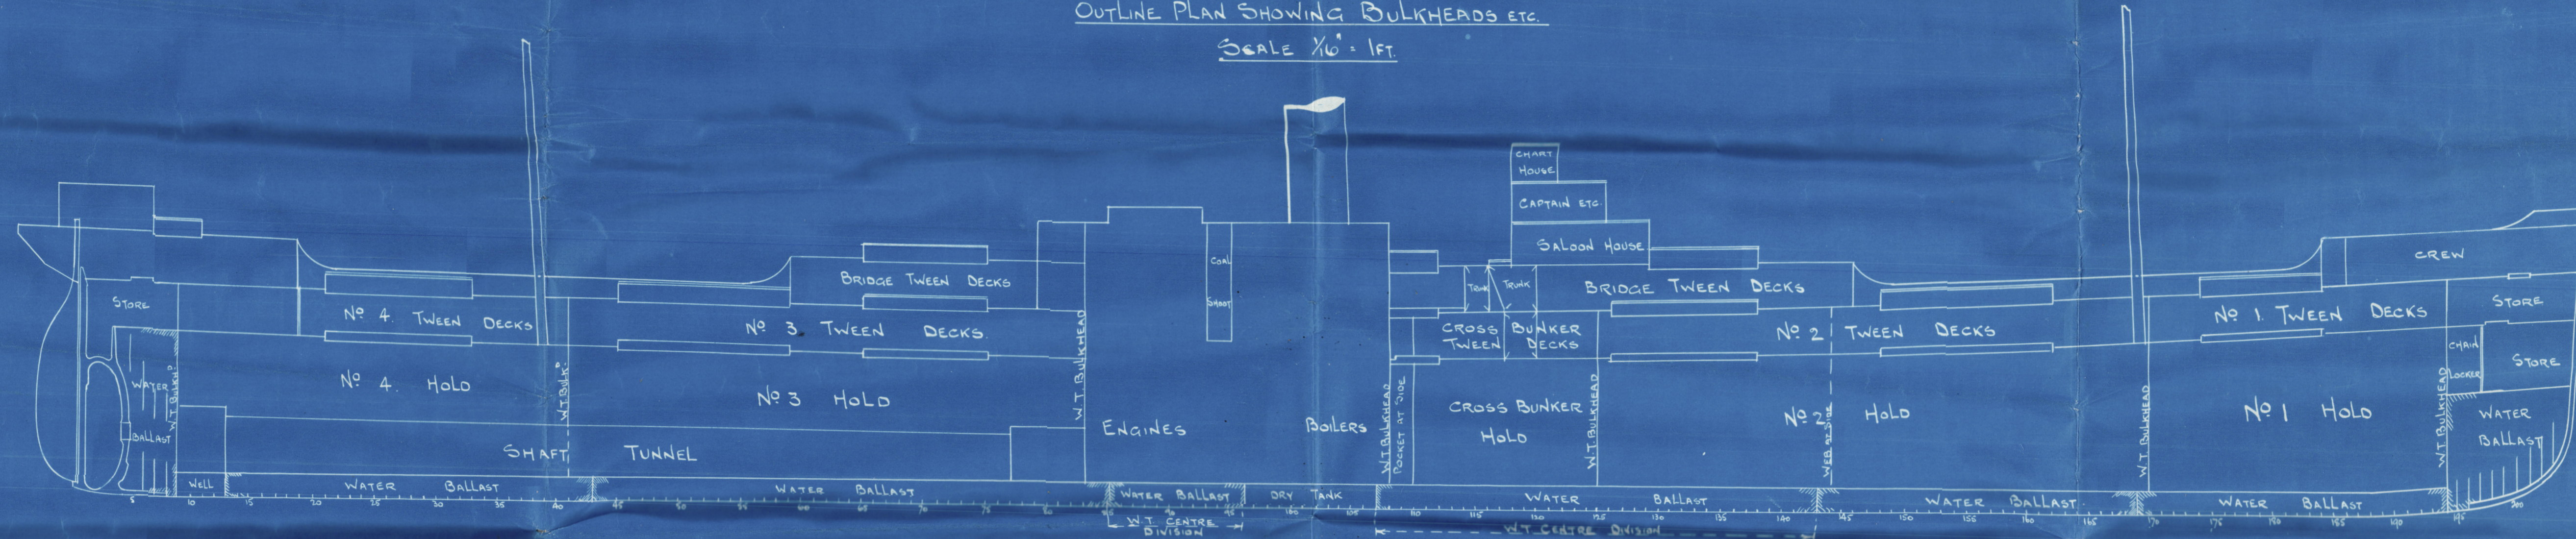


POOP DECK

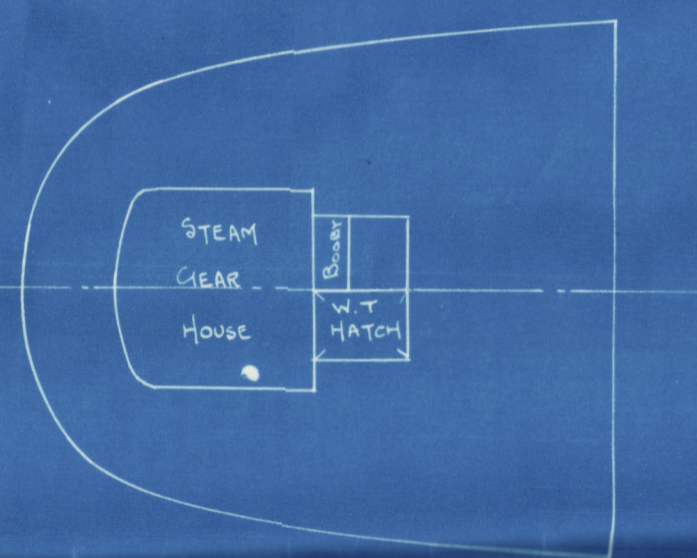


BRIDGE DECK

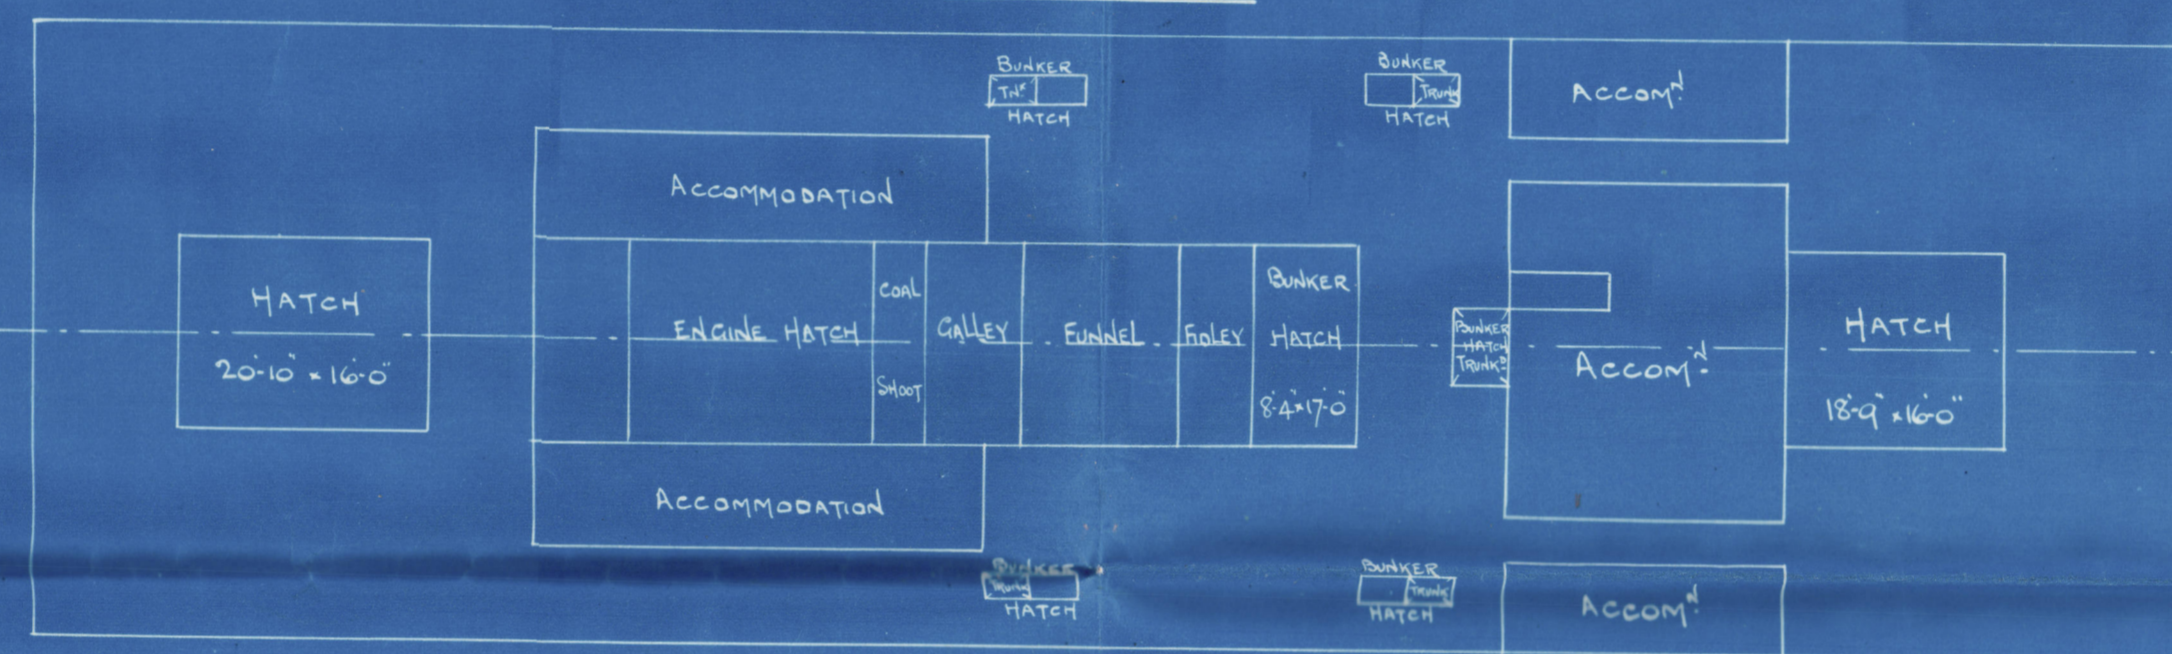



FORECASTLE DECK

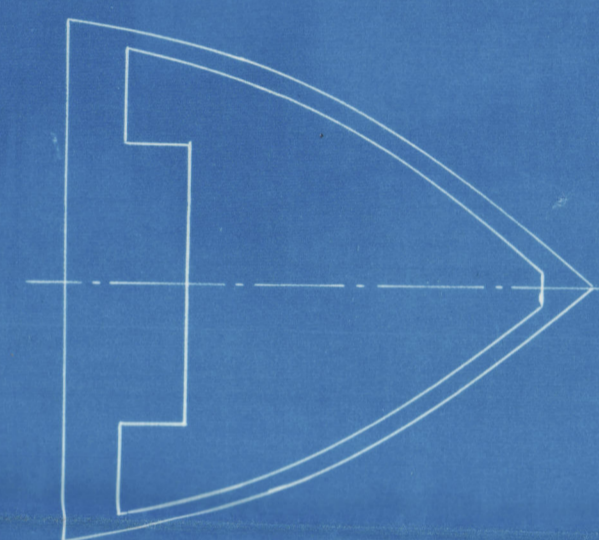

UPPER DECK

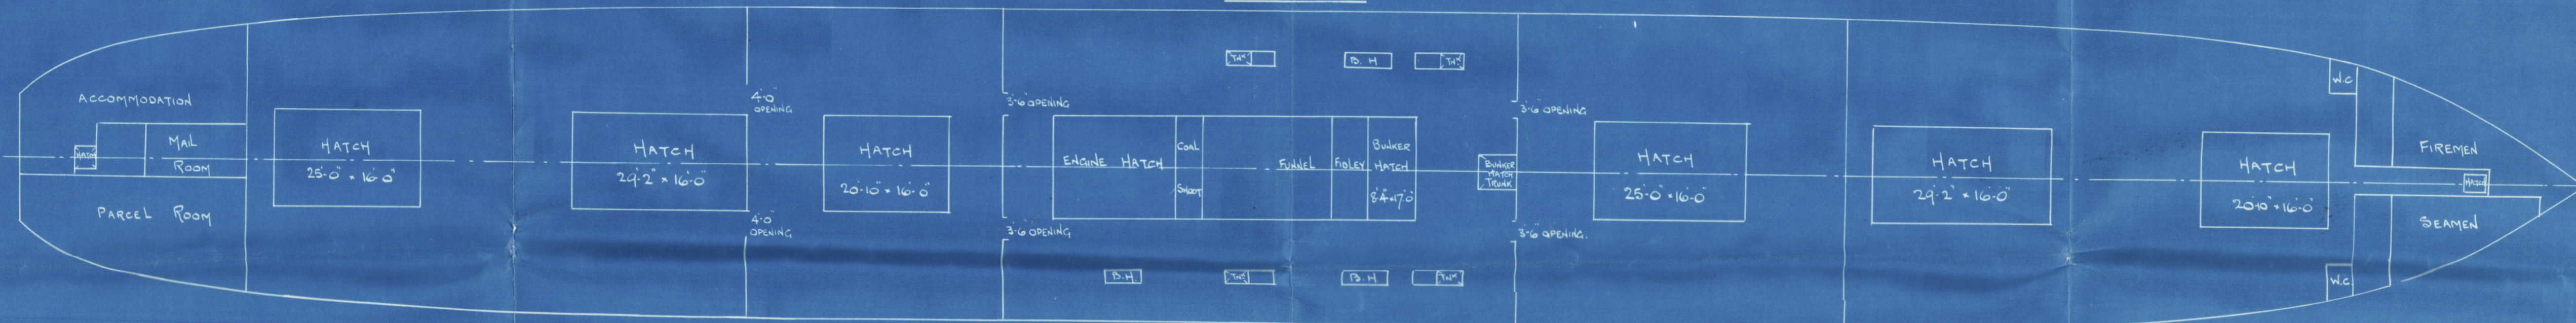

MAIN DECK

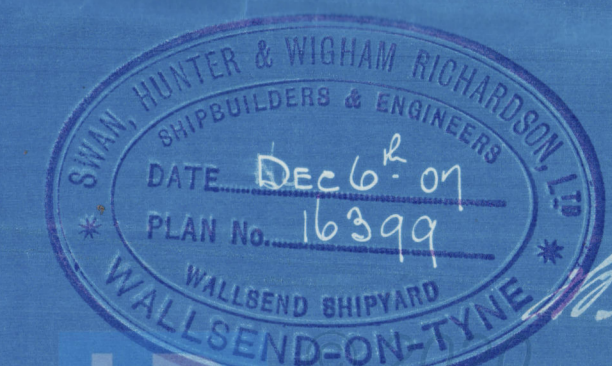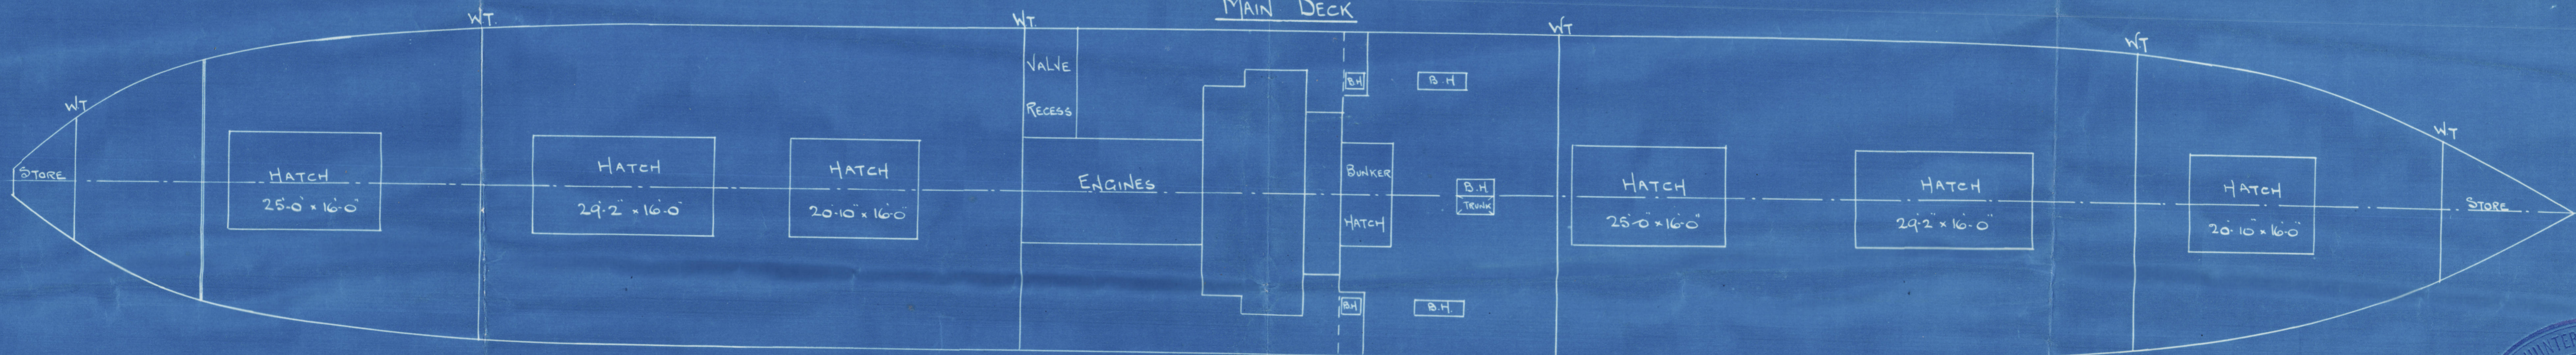

Lloyd's Register Foundation

007412-007421-0081

Profile &
deck plans

no 779

"Yanelon"

~~Now "CITY OF BATAVIA"~~

(as built)




S/S "RIO TEUCO"

ex.
I.P. "Yanelon"

Newcastle Report

Nº 53953.

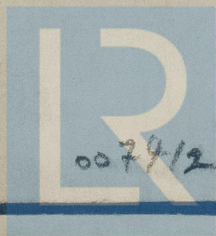

© 2020

Lloyd's Register
Foundation

007912 - 007421 - 0081