

MIDSHIP SECTION

No 1202

TWIN-SCREW STEAM TUG TO CLASS 100. A.I. LLOYDS FOR TOWING SERVICES

NUMERALS

L x D ----- 1365
L x (B+D) ----- 4147
D ----- 13
L/D ----- 8.07

EQUIPMENT


1 ANCHOR 6½ CWTs -- STOCKLESS
1 " 6 " " "
90 FMS 1" STUD LINK CABLE
60 " 6" HAWSER
60 " 4½" WARP.

RIVETING

BUTTS OF SHEERSTRAKE AND GARBOARD STRAPPED
AND DOUBLE RIVETTED ALL FORE AND AFT
BUTTS OF BULWARK STRAPPED AND SINGLE RIVETTED
BUTTS OF SHELL PLATING OVERLAPPED AND DOUBLE
RIVETTED ALL FORE AND AFT.
BUTTS OF DECK STRINGER PLATE OVERLAPPED AND
DOUBLE RIVETTED ALL FORE AND AFT.
BUTTS OF DECK PLATING OVERLAPPED AND DOUBLE
RIVETTED FOR ½ LENGTH -- SINGLE RIVETTED AT ENDS

BOTTOM SEAM OF SHEERSTRAKE AND TOP SEAM OF
GARBOARD DOUBLE RIVETTED ALL FORE AND AFT.
REMAINDER OF SHELL PLATING SEAMS, INCLUDING TOP
EDGE OF SHEERSTRAKE, SINGLE RIVETTED

¾" DIA. RIVETS, EXCEPT IN KEEL, STEM, STERNPOST,
BOILER BEARERS, CASINGS & DECKHOUSE
7/8" DIA. RIVETS IN BOILER BEARERS
1" DIA. RIVETS IN KEEL, STEM AND STERNPOST
5/8" DIA. RIVETS IN CASINGS AND DECKHOUSE
IRON RIVETS THROUGHOUT.

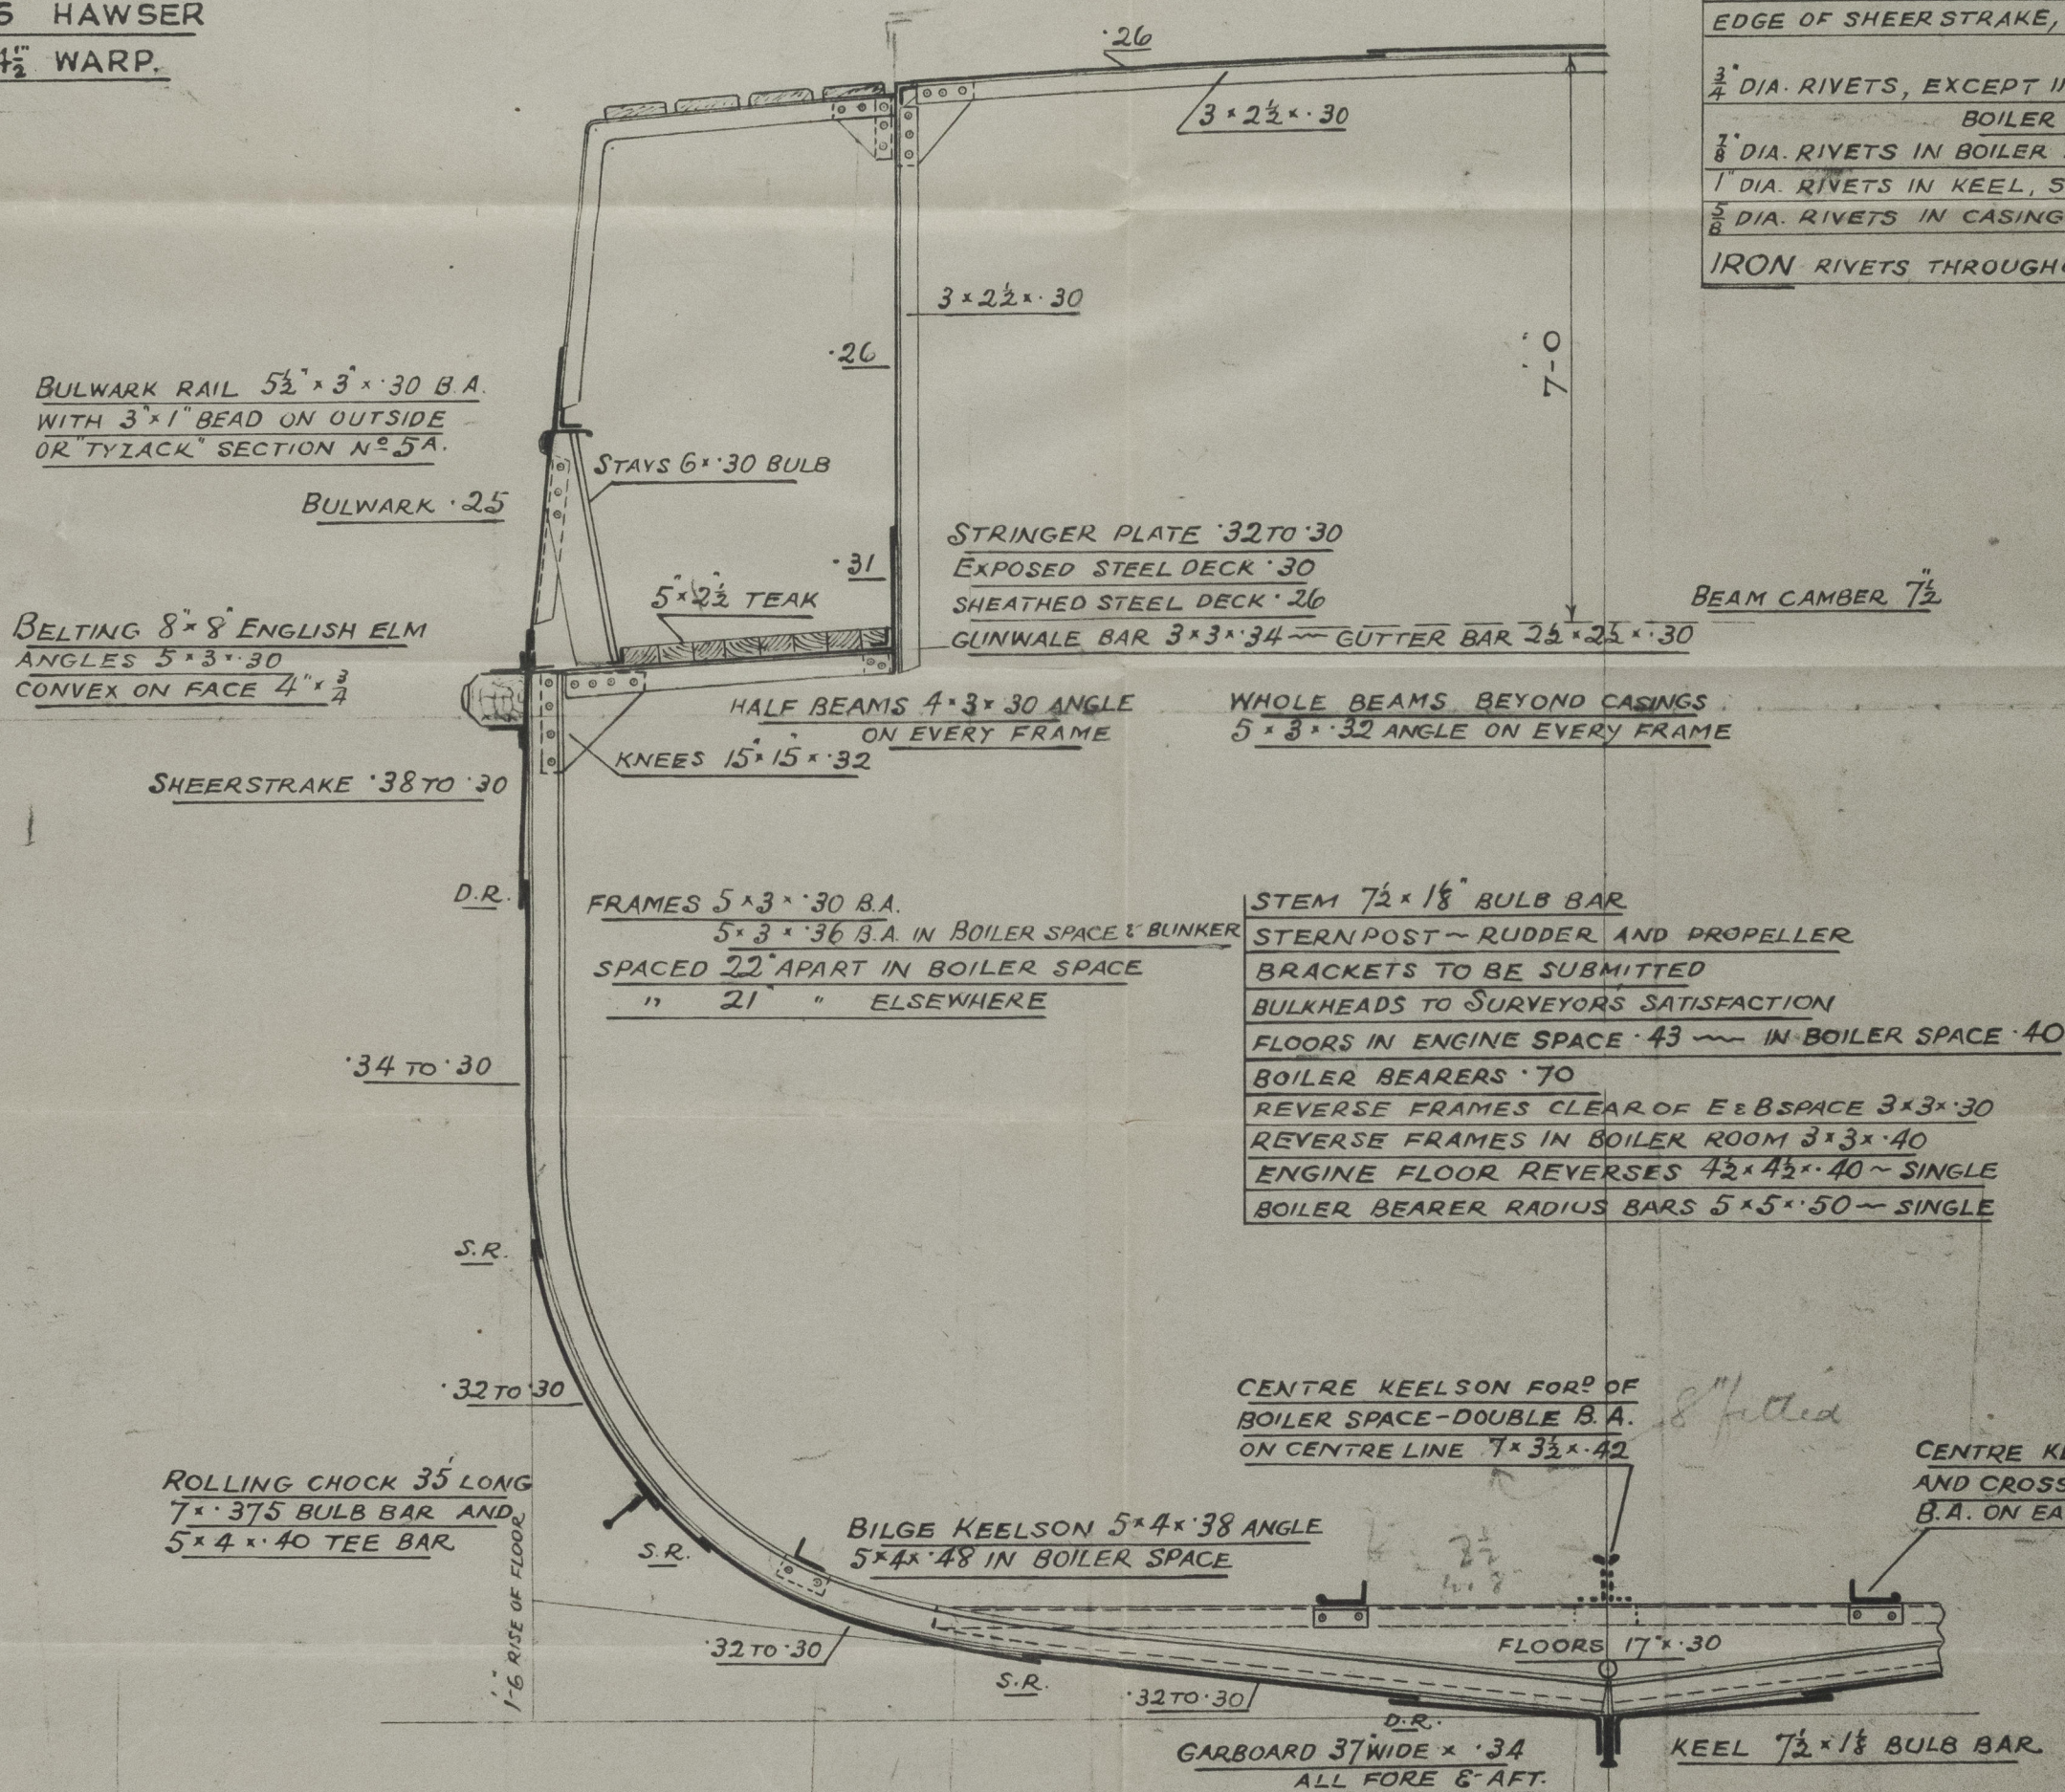

DIMENSIONS 105'-0" B.P. x 26'-6" MLD. x 13'-0" MLD.

SCALE ½ IN. = 1 FT.



© 2020
Lloyd's Register
Foundation

HULL

Cochrane Sash

1202

Midship Section
(as built)

S.S. *Kerne*

HULL REPORT No. 50277

© 2020

Lloyd's Register
Foundation

007647-007657-0164