

SS. CARGO MOTOR SHIP "KATSURAGI-MARU"
MIDSHIP SECTION
SCALE 1/4" = 1'-0"

TYPE OF THE SHIP: STEEL DECK WITH TONNAGE OPENING
CLASS: TOSHIMASU'S 1ST CLASS 1ST WITH FREEBOARD OF 11'-0"

N.B.: STANDARD & BULK HEADS TO BE OF THE
STANDARD SECTION AREA BEHIND THE
STANDARD SECTION AREA BEHIND THE
STANDARD SECTION AREA BEHIND THE

PRINCIPAL DIMENSIONS
LENGTH 111'-0"
BREADTH 40'-0"
DEPTH 40'-0" (TO SHUTTER DECK)

SCANTLING NUMERALS

DEPTH	111'-0"	40'-0"
LONGITUDINAL NUMERALS	111'-0"	40'-0"
TRANSVERSE NUMERALS	111'-0"	40'-0"
PROJECTION (TO SHUTTER DECK)	111'-0"	40'-0"
PLATING DEPTH IN HOLD	111'-0"	40'-0"
WALL THICKNESS OF TANK SIDE BRACKET	111'-0"	40'-0"
(A) FOR HOLD FRAMES	111'-0"	40'-0"
(B) IN ENGINE ROOM	111'-0"	40'-0"

EQUIPMENT NUMBERS

1. STEAM	111'-0"	40'-0"
2. STEAM	111'-0"	40'-0"
3. STEAM	111'-0"	40'-0"
4. STEAM	111'-0"	40'-0"
5. STEAM	111'-0"	40'-0"
6. STEAM	111'-0"	40'-0"
7. STEAM	111'-0"	40'-0"
8. STEAM	111'-0"	40'-0"
9. STEAM	111'-0"	40'-0"
10. STEAM	111'-0"	40'-0"

PLATING & COATING
STEEL CURVED PLATES OF STEEL PER PLAN
STEEL FRAMES AS PER DETAIL PLAN
WOODER DOUBLE PLATE TYPE AS PER DETAIL PLAN

EQUIPMENTS
1. STEAM
2. STEAM
3. STEAM
4. STEAM
5. STEAM
6. STEAM
7. STEAM
8. STEAM
9. STEAM
10. STEAM

SHELL PLATING

PLATE	NO.	SIZE	REMARKS
PLATE 1	1	111'-0" x 40'-0"	STEEL PLATE
PLATE 2	2	111'-0" x 40'-0"	STEEL PLATE
PLATE 3	3	111'-0" x 40'-0"	STEEL PLATE
PLATE 4	4	111'-0" x 40'-0"	STEEL PLATE
PLATE 5	5	111'-0" x 40'-0"	STEEL PLATE
PLATE 6	6	111'-0" x 40'-0"	STEEL PLATE
PLATE 7	7	111'-0" x 40'-0"	STEEL PLATE
PLATE 8	8	111'-0" x 40'-0"	STEEL PLATE
PLATE 9	9	111'-0" x 40'-0"	STEEL PLATE
PLATE 10	10	111'-0" x 40'-0"	STEEL PLATE

DECKS

DECK	NO.	SIZE	REMARKS
DECK 1	1	111'-0" x 40'-0"	STEEL DECK
DECK 2	2	111'-0" x 40'-0"	STEEL DECK
DECK 3	3	111'-0" x 40'-0"	STEEL DECK
DECK 4	4	111'-0" x 40'-0"	STEEL DECK
DECK 5	5	111'-0" x 40'-0"	STEEL DECK
DECK 6	6	111'-0" x 40'-0"	STEEL DECK
DECK 7	7	111'-0" x 40'-0"	STEEL DECK
DECK 8	8	111'-0" x 40'-0"	STEEL DECK
DECK 9	9	111'-0" x 40'-0"	STEEL DECK
DECK 10	10	111'-0" x 40'-0"	STEEL DECK

PANTING ARRANGEMENT
FORWARD OF COLLISION BND

STRONGER	111'-0"	40'-0"
STRONGER	111'-0"	40'-0"
BEAMS

BEAM	NO.	SIZE	REMARKS
BEAM 1	1	111'-0" x 40'-0"	STEEL BEAM
BEAM 2	2	111'-0" x 40'-0"	STEEL BEAM
BEAM 3	3	111'-0" x 40'-0"	STEEL BEAM
BEAM 4	4	111'-0" x 40'-0"	STEEL BEAM
BEAM 5	5	111'-0" x 40'-0"	STEEL BEAM
BEAM 6	6	111'-0" x 40'-0"	STEEL BEAM
BEAM 7	7	111'-0" x 40'-0"	STEEL BEAM
BEAM 8	8	111'-0" x 40'-0"	STEEL BEAM
BEAM 9	9	111'-0" x 40'-0"	STEEL BEAM
BEAM 10	10	111'-0" x 40'-0"	STEEL BEAM

DOUBLE BOTTOM


PLATE	NO.	SIZE	REMARKS
PLATE 1	1	111'-0" x 40'-0"	STEEL PLATE
PLATE 2	2	111'-0" x 40'-0"	STEEL PLATE
PLATE 3	3	111'-0" x 40'-0"	STEEL PLATE
PLATE 4	4	111'-0" x 40'-0"	STEEL PLATE
PLATE 5	5	111'-0" x 40'-0"	STEEL PLATE
PLATE 6	6	111'-0" x 40'-0"	STEEL PLATE
PLATE 7	7	111'-0" x 40'-0"	STEEL PLATE
PLATE 8	8	111'-0" x 40'-0"	STEEL PLATE
PLATE 9	9	111'-0" x 40'-0"	STEEL PLATE
PLATE 10	10	111'-0" x 40'-0"	STEEL PLATE

STRONGER

STRONGER	NO.	SIZE	REMARKS
STRONGER 1	1	111'-0" x 40'-0"	STEEL STRONGER
STRONGER 2	2	111'-0" x 40'-0"	STEEL STRONGER
STRONGER 3	3	111'-0" x 40'-0"	STEEL STRONGER
STRONGER 4	4	111'-0" x 40'-0"	STEEL STRONGER
STRONGER 5	5	111'-0" x 40'-0"	STEEL STRONGER
STRONGER 6	6	111'-0" x 40'-0"	STEEL STRONGER
STRONGER 7	7	111'-0" x 40'-0"	STEEL STRONGER
STRONGER 8	8	111'-0" x 40'-0"	STEEL STRONGER
STRONGER 9	9	111'-0" x 40'-0"	STEEL STRONGER
STRONGER 10	10	111'-0" x 40'-0"	STEEL STRONGER

STRONGER

STRONGER	NO.	SIZE	REMARKS
STRONGER 1	1	111'-0" x 40'-0"	STEEL STRONGER
STRONGER 2	2	111'-0" x 40'-0"	STEEL STRONGER
STRONGER 3	3	111'-0" x 40'-0"	STEEL STRONGER
STRONGER 4	4	111'-0" x 40'-0"	STEEL STRONGER
STRONGER 5	5	111'-0" x 40'-0"	STEEL STRONGER
STRONGER 6	6	111'-0" x 40'-0"	STEEL STRONGER
STRONGER 7	7	111'-0" x 40'-0"	STEEL STRONGER
STRONGER 8	8	111'-0" x 40'-0"	STEEL STRONGER
STRONGER 9	9	111'-0" x 40'-0"	STEEL STRONGER
STRONGER 10	10	111'-0" x 40'-0"	STEEL STRONGER

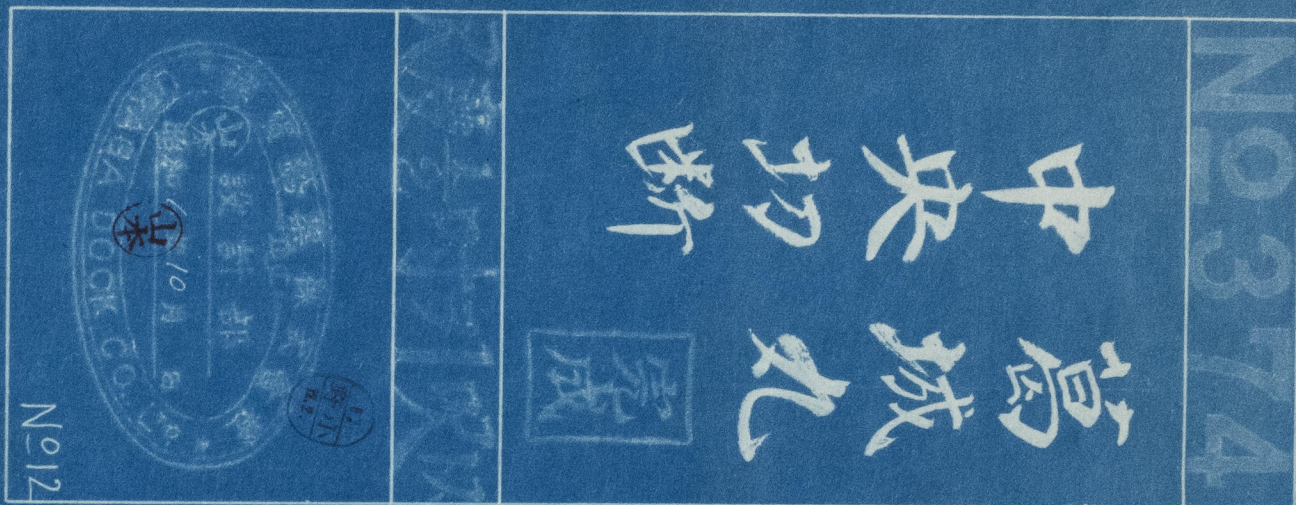

"Katsuragi Maru"

*Midship Section
(as built)*



© 2020

Lloyd's Register
Foundation

007658-007667-0244