


SCALE: - $\frac{1}{2}$ " = 1 FOOT.

ONE	"	32 1/2	"	"
ONE STREAM	"	10	"	EX. STOCK.
ONE KEDGE	"	5	"	" "
240 FATHOMS.	1 13/16"	STUD CHAIN CABLE.		
75	"	4 1/4"	STEEL WIRE FOR STREAM AND	
100 20	"	4	"	TOWLINE.
2 @ 90	"	7"	HEMP HAWSERS	
2 @ 90	"	6"	"	"

TRANSVERSE NO. 66.83
LONGITUDINAL NO 19380.7
d. 19.92.

DEPTH TO LENGTH. UPPER DK. 12.61.
" " " BRIDGE " 9.55.

EQUIPMENT NO. 20419.79.

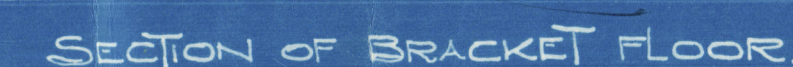

Geo. Brown & Co.

N^o 136.

Midships Section
as built.

J. S. Lenneman
Genl Report N^o 17977.



© 2020

Lloyd's Register
Foundation

007947-007957-0130