


SCALE $\frac{1}{8}" = 1 \text{ FOOT}$

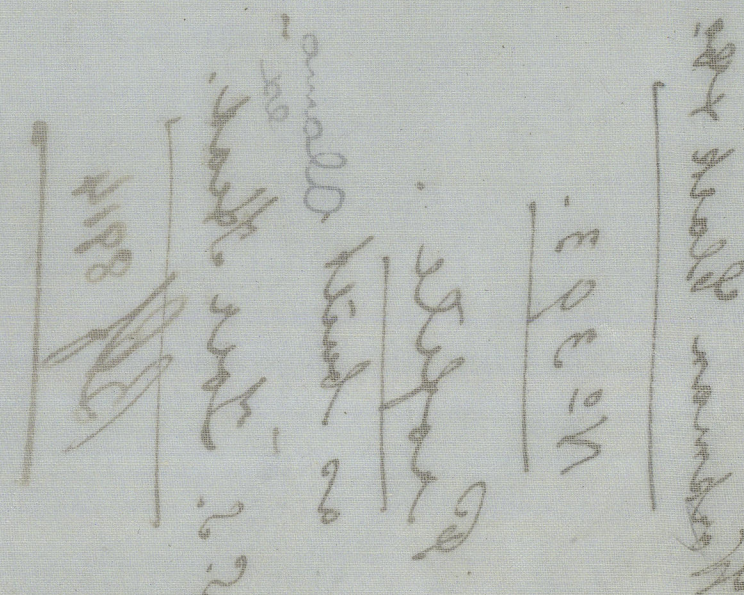

Workman Clark & Co

No 393.

Profile.

as built ^{ex}Alamo

S. S. Torr Heat.

Blk 8914



© 2020

Lloyd's Register
Foundation