

Longitudinal Section
of "Daylight"
No. 1322


Longitudinal Section
of "Daylight"
No. 1322

Longitudinal Section showing Keelsons.

"Daylight." *as built*

No. 490


Scale $\frac{1}{8}$ inch = 1 foot.

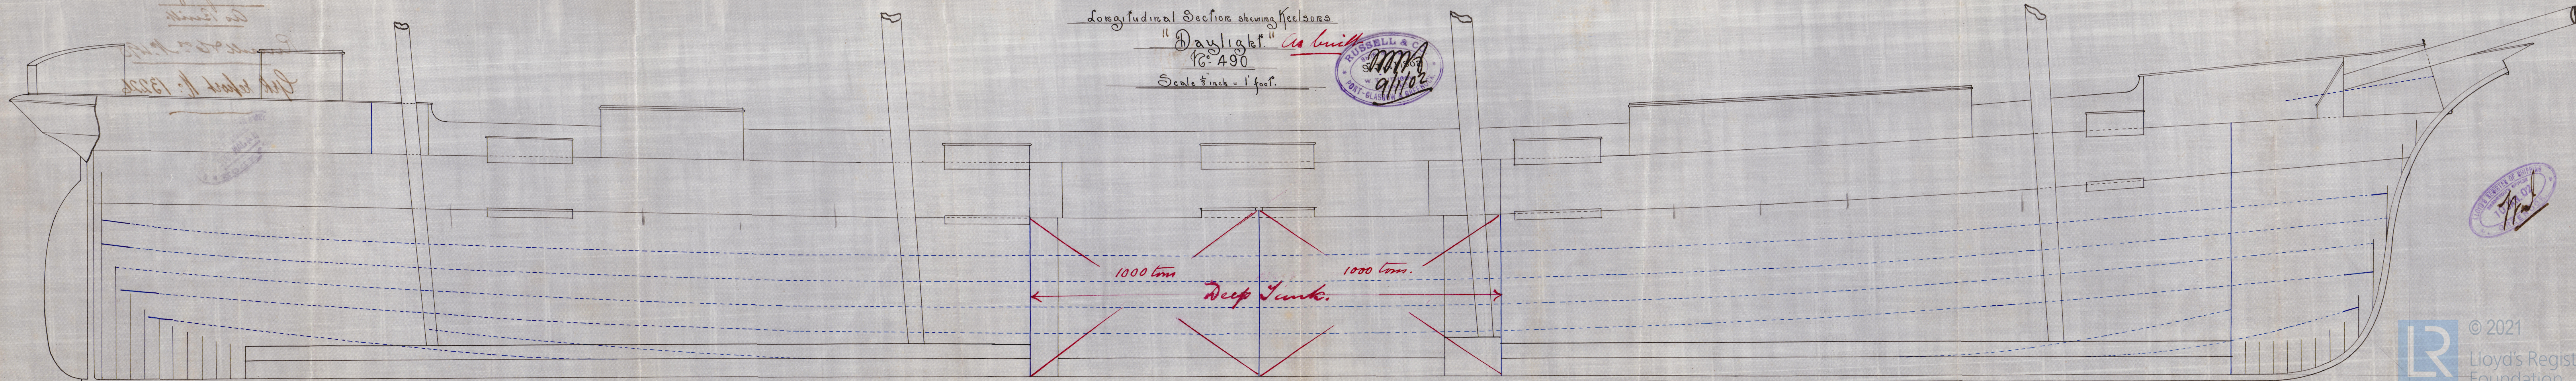

Longitudinal Section
Bt. "Daylight"
As Built.

Russell & Co. No. 498

Ctr. report No. 13226

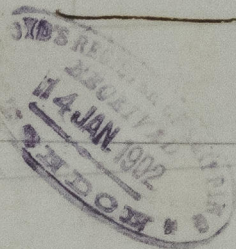

© 2021

Lloyd's Register
Foundation

008186-08200-0266