


Nº 347-8

Length B.P. 390'-0" - Breadth M^{ld} 53'-9" - Depth M^{ld} 32'-0"
0° 389'-6" on LVL.

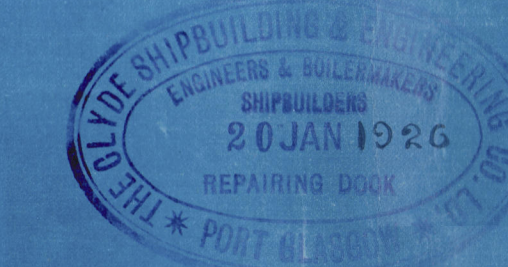

NOTE: STIFFENERS ON W.T. BHS IN WAY
OF DECK GIRDERS TO BE OF INCREASED SIZE
& BRACKETED. SCANTLINGS TO BE
CONSIDERED WITH PLAN OF GIRDERS.

COLLISION BND.
PLAN TO BE
SUBMITTED.
SPACED 24" APART.
FLANGES 3/4" (15-16)

The Cyder S.B. Co. Ltd

S. S. PERLON.

N^o 347.

Profile & Bth plans.

as Built.

Grav. Ref. No 18506.

2



© 2021

Lloyd's Register
Foundation