

# MOTORCOASTER OF 425 M.TONS D.W.

MOTOR SHIP FOR THE CLASS 100A 1 +  
LLOYD'S REG. OF SHIPPING  
THE SCANTLINGS BEING SUITABLE FOR A SUMMER MOULDED DRAFT OF ABOUT 2.88

## PRINCIPAL DIMENSIONS:

LENGHT BETWEEN PERPENDICULARS	49.00 M.
BREADTH MOULDED	9.40 "
DEPTH MOULDED TO MAIN DECK	2.95 "
DEPTH MOULDED TO SHELTER DECK	5.05 "
DROUGHT (FULL LOAD)	2.88 "

ALL FRAME SPACINGS 550%

## EQUIPMENT NUMBER 750, TABLE 53, LETTER J.


- EQUIPMENT LIST:  
3-735 KILO BOWER ANCHORS, TEST LOAD 16290 KILOS  
1-215 -- STREAM ANCHOR (EXCEPTED STOCK) TEST LOAD 6690 KILOS  
385 METRES OF 30% STUD LINKED ANCHOR CHAIN, TEST LOAD 25520 KILOS  
110 -- 75% CIRC. STREAM STEEL WIRE CABLE BREAKING LOAD 18900 KIL  
135 -- 70% -- TOWLINE -- 15450 --  
165 -- 152% -- HAWSER MANILLA ROPE -- 9100 --  
OR 165 -- 57% -- STEEL WIRE CABLE -- 11000 --

## PLATING CONNECTIONS:

DECKS AND TANKTOP: ALL SEAMS AND ENDLAPS WELDED  
SHEEL PLATING: ALL ENDLAPS WELDED  
ALL SEAMS RIVETED

## WELDING:

- 6/75 = CHAIN INTERMITTENT  
6/180 = STAGGERED  
6/180 = DOUBLE CONTINUOUS FILLED WELDS  
6/75 = THE SIDES OF FILLETS  
ITEM  
ITEM

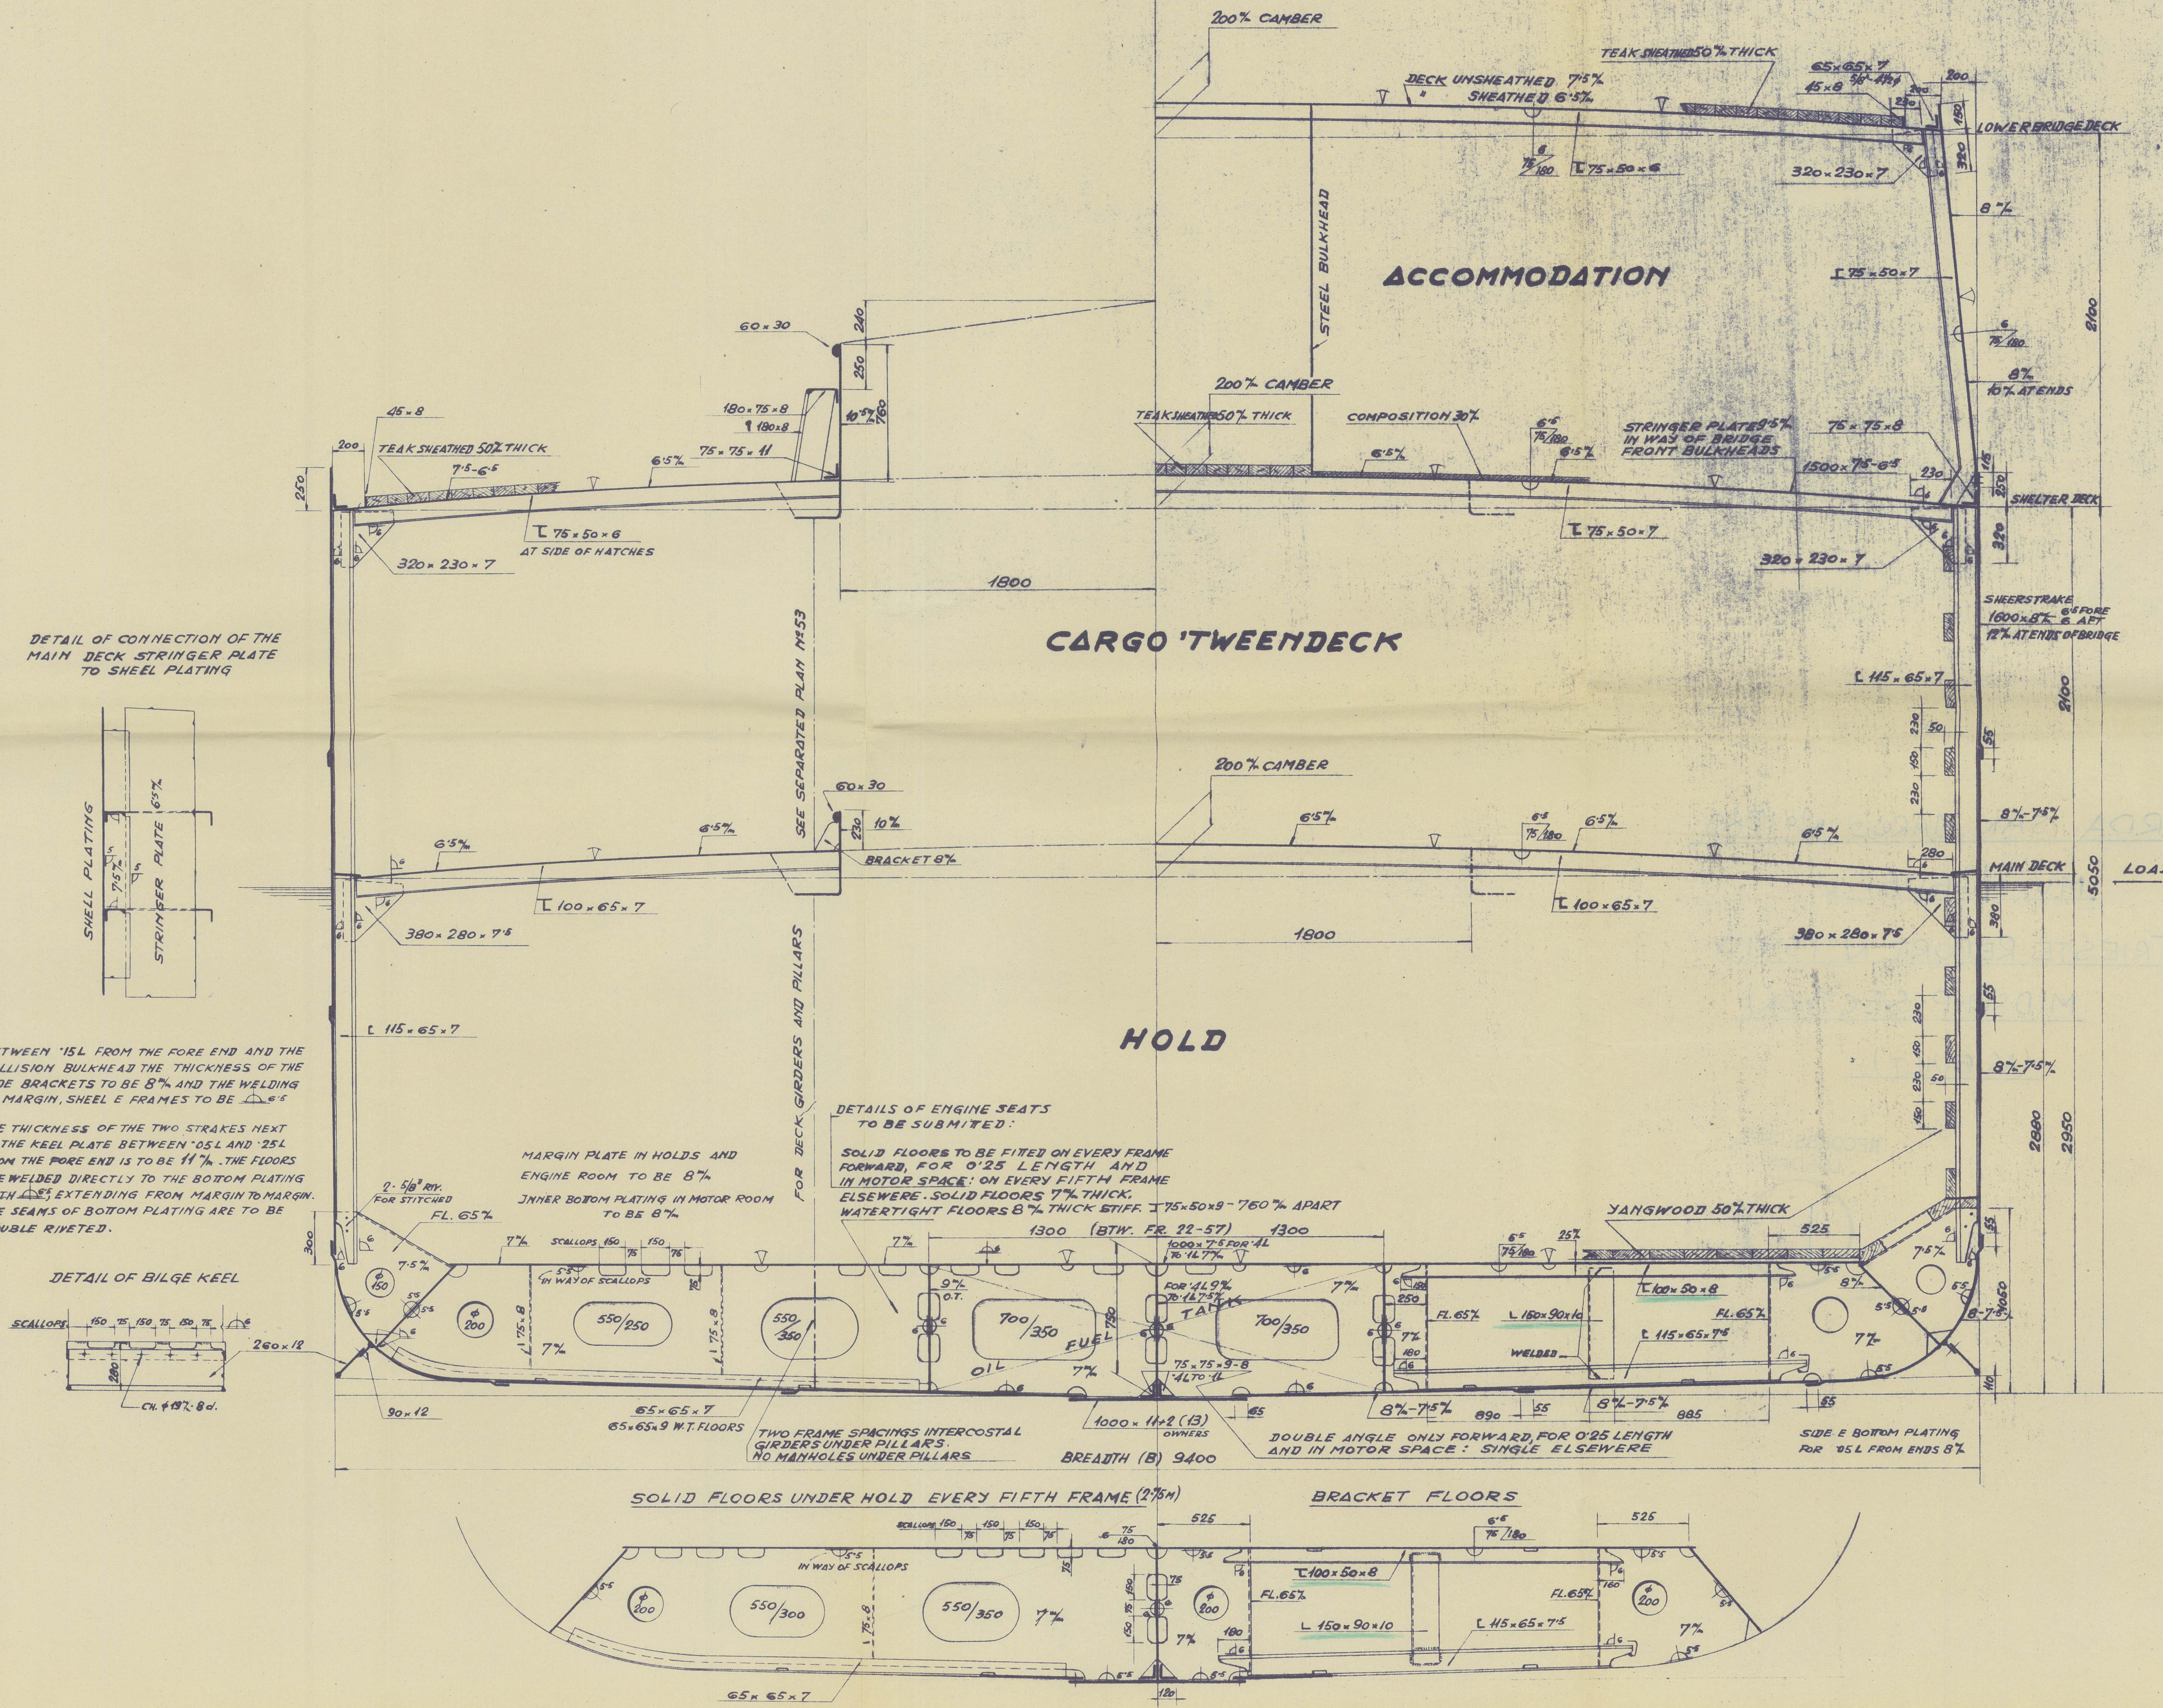

APPROVED FROM LLOYD'S REGISTER OF SHIPPING - GENOVA 21-4-1952.

CANTIERI RIUNITI DELL'ADRIATICO CANTIERE SAN MARCO TRIESTE		
<p>1:20</p> <p><b>MIDSHIP SECTION</b></p> <p>51</p>		
<p>1781-85</p>		<p>Lloyd's Register Foundation</p>

008587-008596-0093



15. 12.  
4 9  
19. 21

C.R.D.A. SAN MARCO N° 1785


MV. "NUBURI" \*

TRIESTE REPORT N° 13910

MIDSHIP SECTION

(AS BUILT)

RECORDS DEPT.  
LONDON

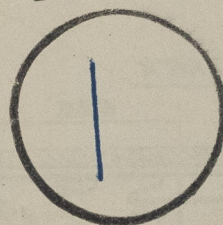

© 2021

Lloyd's Register  
Foundation

008587-008596-0093