


S.S. "BOTHNIA"

PROFILE & DECK PLAN.

292' 0" L.B.P. x 45' 0" B.P. ST. x 23' 6" DEPTH Y.D.

SCALE 3" = 1 FOOT.

SCANTLING OF HATCHES, BULGHEADS, ETC.
HAS BEEN SUBMITTED.

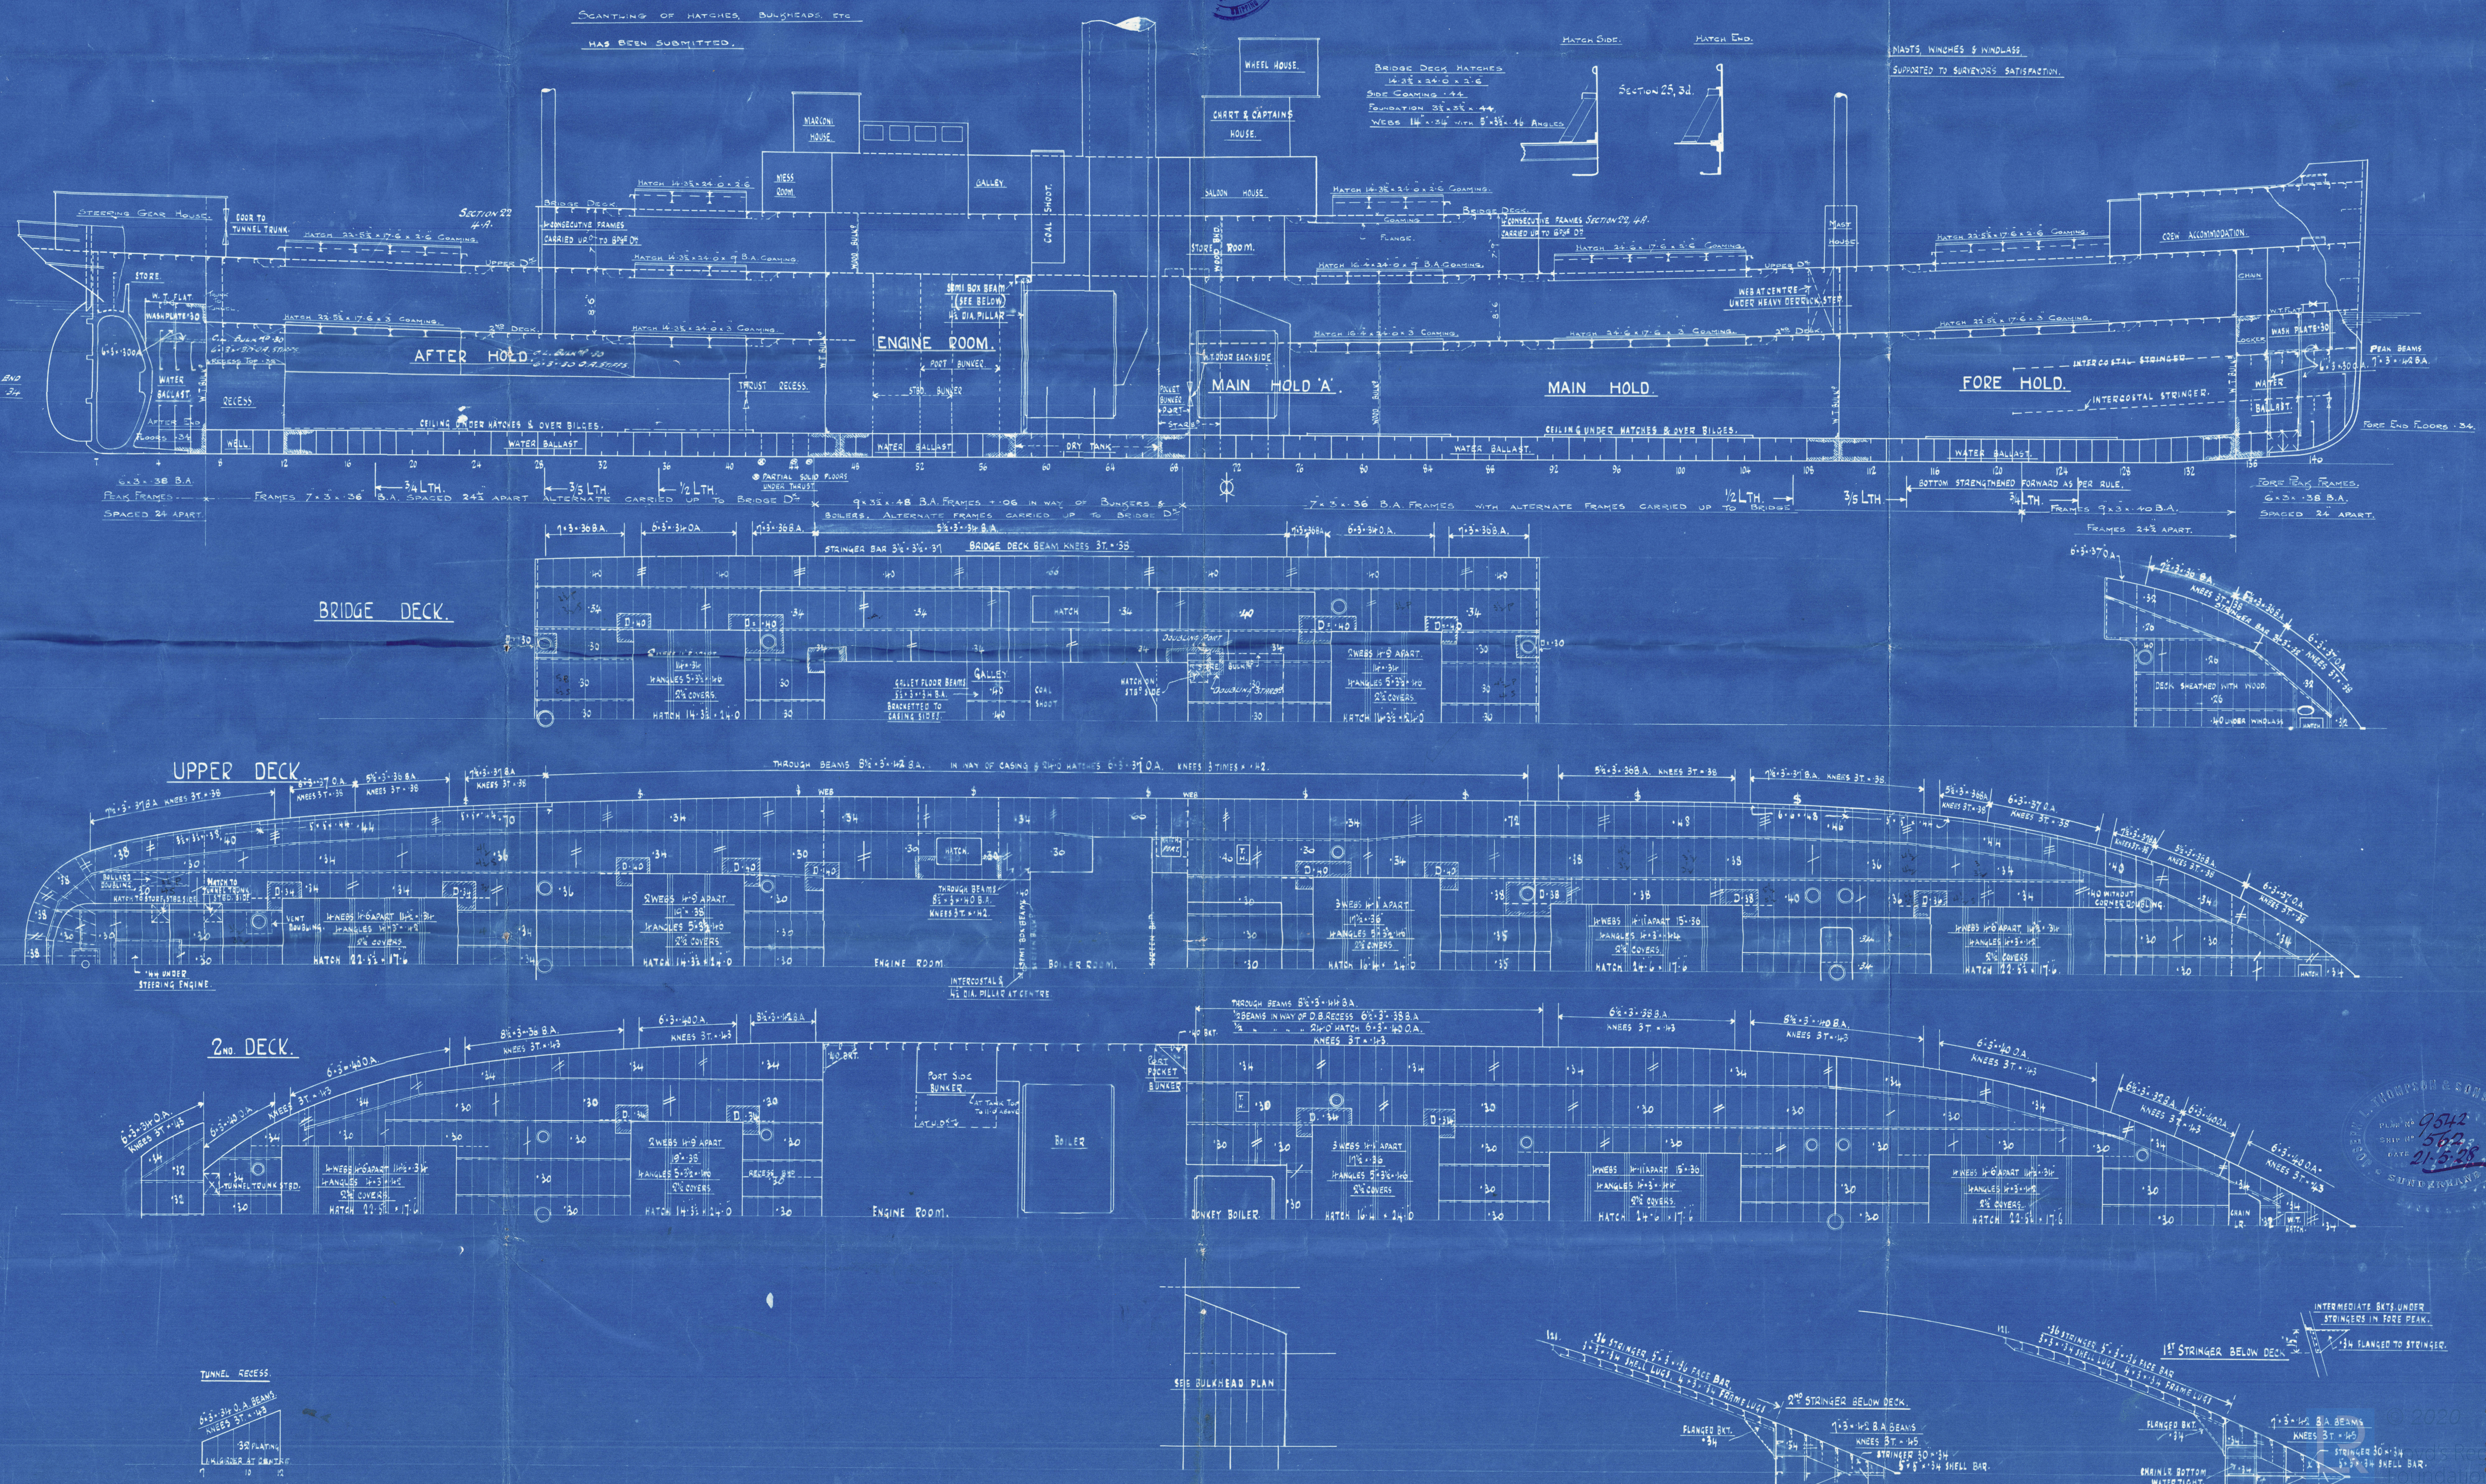

9542
562
21.8.28
SHEPHERD & SONS, LTD.
SHED BIRMINGHAM

© 2020

SUNDERLAND.

JOS. L. THOMPSON & SONS, LD.

S. S. No. 562

S. S. "BOTHNIA"

PROFILE & DECKS.
(AS BUILT).

SUNDERLAND RPT. NO. 29735



008597-008607-0032



© 2020

Lloyd's Register
Foundation