

J.P. WEBB. "AS FITTED"
YARD No. ~~397~~ 408.
HULL SECTIONS.

SCALE : 1/2" = 1'-0"

DIMENSIONS : 195'-0" B.P. x 36'-0" x 17'-0" MLD.

APPROVED BY LLOYDS 22-12-49

RIVETING.
BUTTS OF SHEERSTAKE STRAPPED AND T.R. FOR 4 L. & 3 D.R. AT ENDS
BUTTS OF KEEL PLATE WELDED OR T.R. ALL FORE AND AFT
REMAINDER OF SHELL BUTTS LAPPED AND D.R. ALL FORE & AFT
BUTTS OF DECK STRINGER PLATE LAPPED AND D.R. TR. IN WAY OF HOPPER
BUTTS OF DECK PLATING LAPPED AND D.R. TO SR.
SHELL SEAMS ALL D.R.
DECK PLATING SEAMS ALL SR.
BUTTS OF HOPPER PLATING LAPPED AND D.R.
SEAMS OF HOPPER PLATING LAPPED AND SR.

TO CLASS LLOYDS 100 A1. "HOPPER BARGE."

$L \times (B+D)$	=	0335
FORECASTLE 24x7x75	=	26
DECKHOUSE 55x75x50	=	213
BOAT DECK SALOON 105x775x50	=	41
EQUIPMENT NUMERAL	=	10715

EQUIPMENT


- 3 - BOWER ANCHORS; 2 @ 23 1/2' ONTS STOCKLESS AND ONE @ 20' ONTS STOCKLESS (OWNERS REQUIRE)
- 1 - STREAM ANCHOR 6 ONTS EX STOCK
- 210 - FATHOMS 1 1/8" WROTH IRON STD LNK CHAIN CABLE
- IN 15 FATHOM LENGTHS COMPLETE WITH END AND JOINTS SHACKLES
- 60 - FATHOMS 3/4" CIRC. STEEL WIRE ROPE ON REEL FOR STREAM ANCHOR
- 90 - FATHOMS 3/4" CIRC. STEEL WIRE TONLINE ON REEL
- 90 - FATHOMS 6" CIRC. HAWSER
- 90 - FATHOMS 5" CIRC. WARP
- 1 - COIL 12 THREAD HEAVING LINE

NUMERALS


L = 195.00, B = 36.00, D = 17.00.

d = 14.75 (SUMMER MOULDED DRAFT)


STEM = 6" x 1 5/8" : STERNPOST 5 1/2" x 4 1/2"

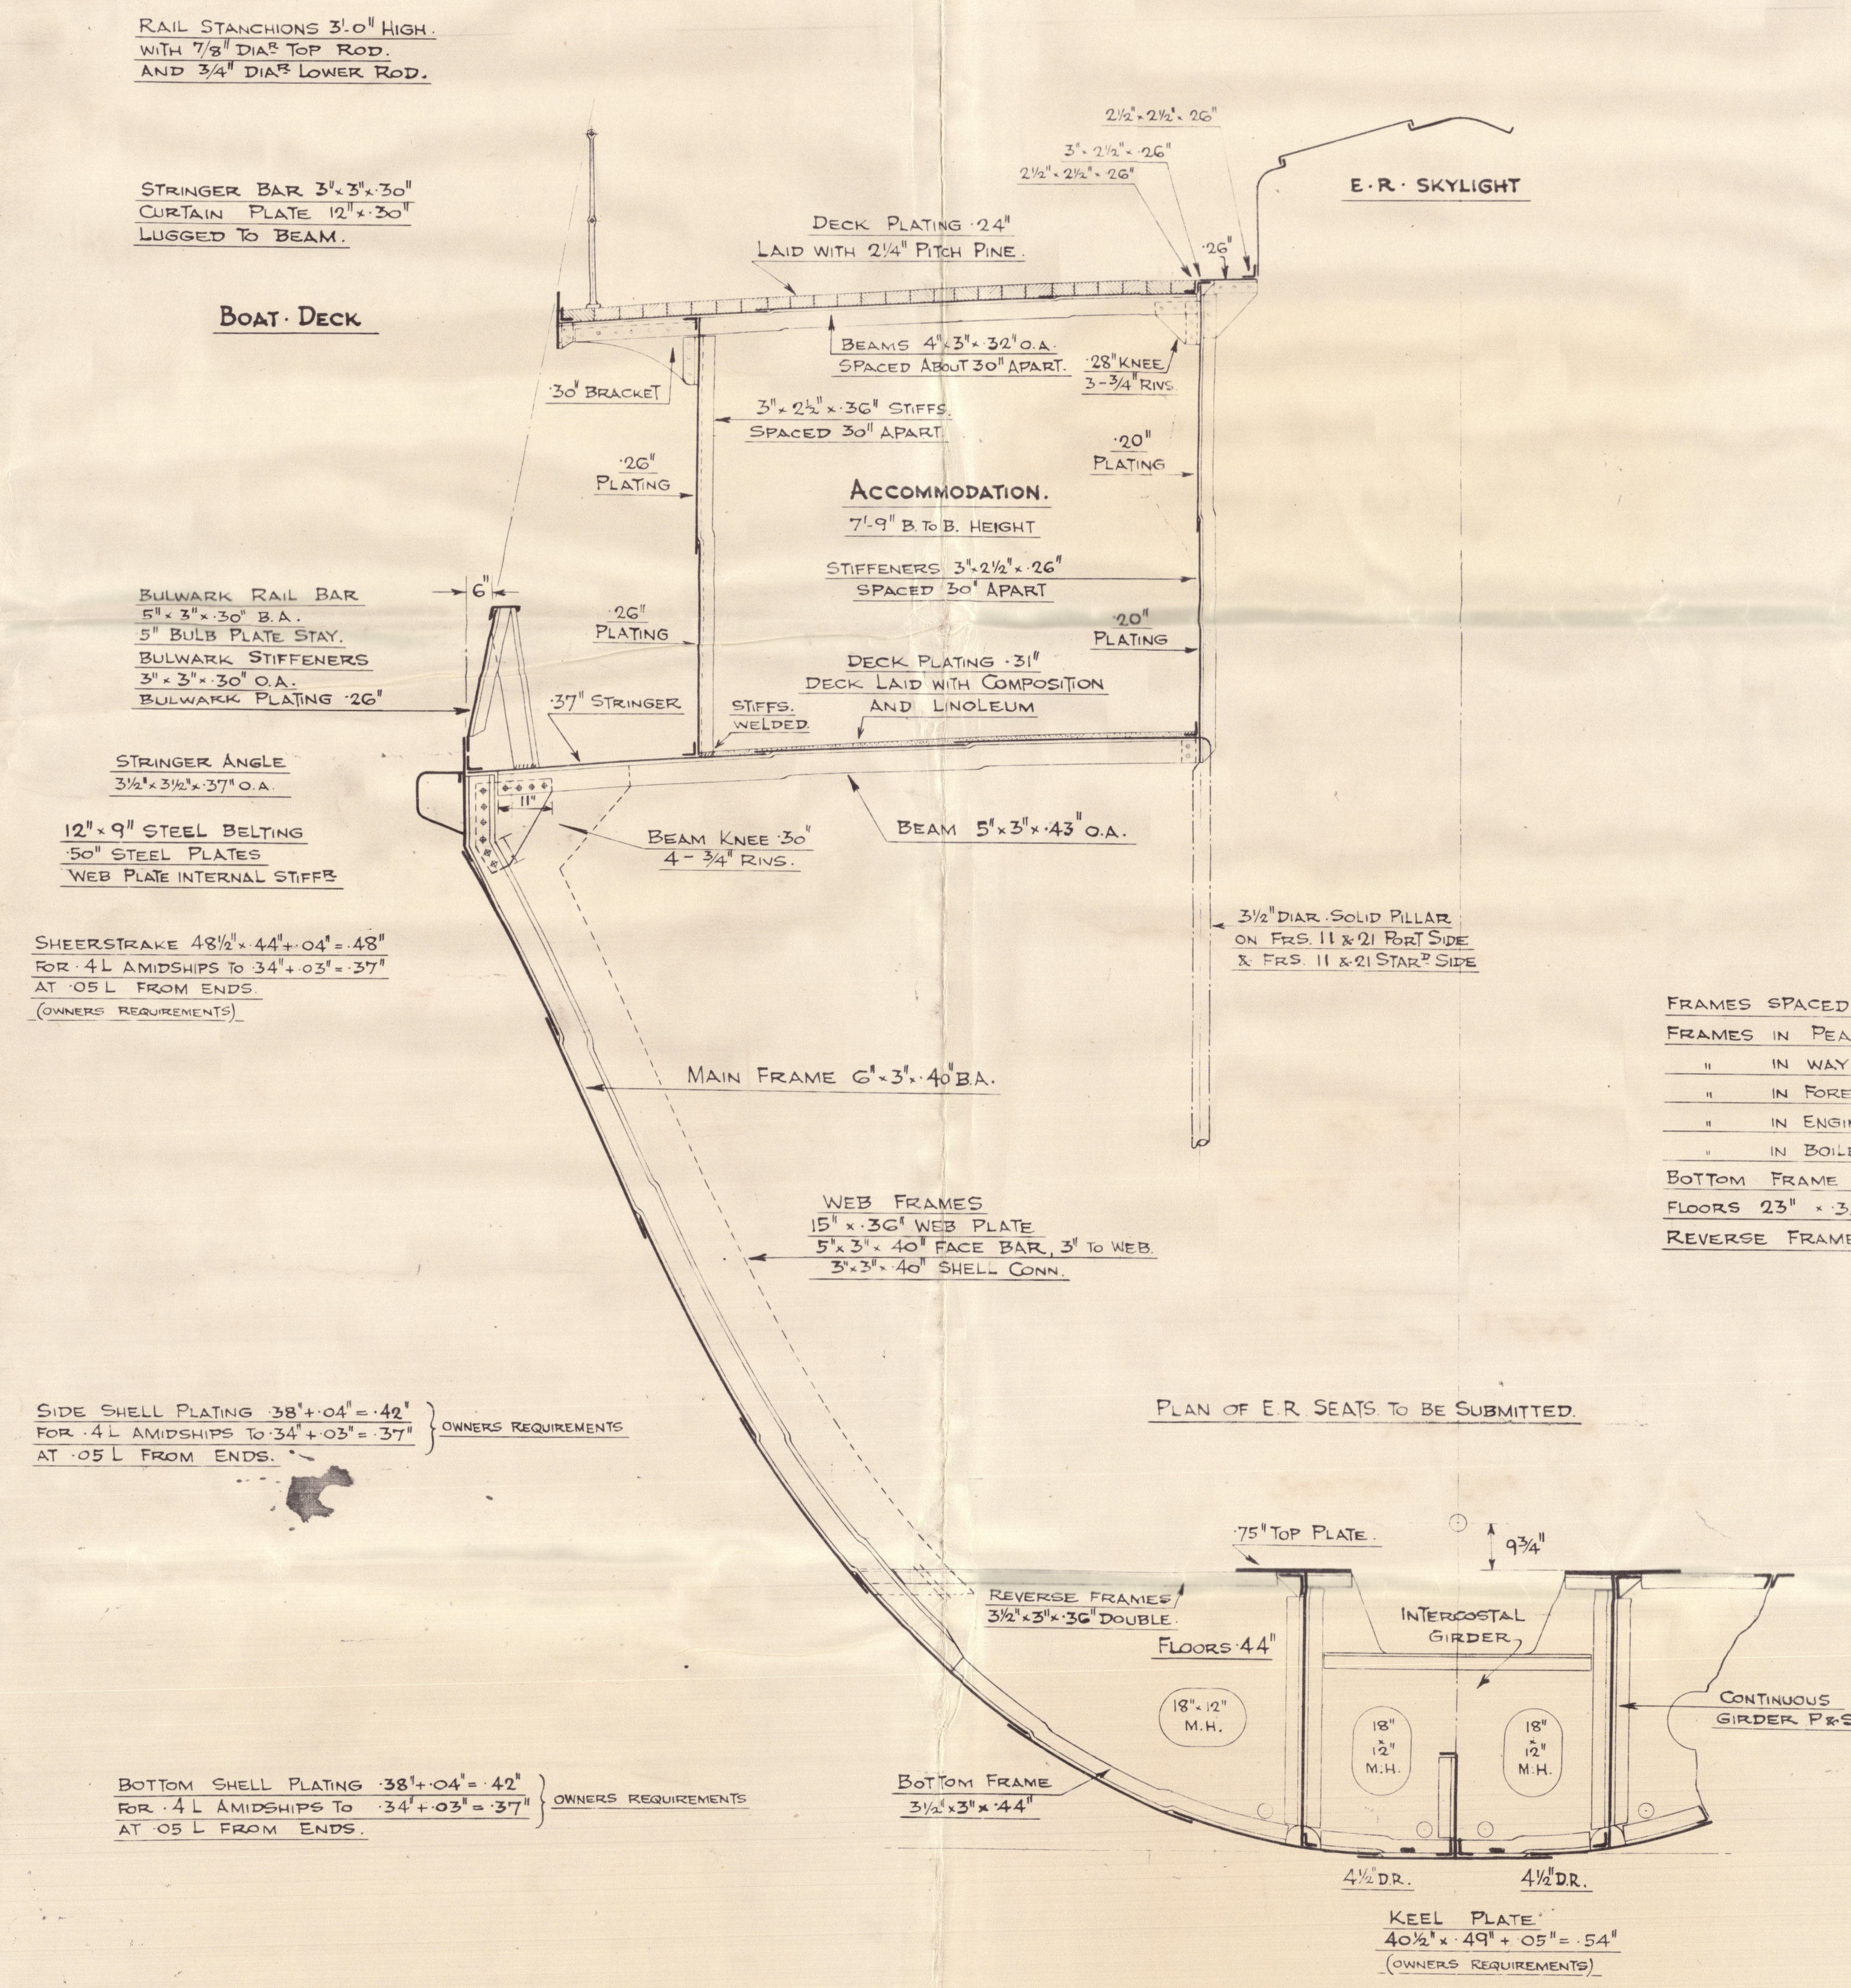

SECTION THRO' ENGINE ROOM.

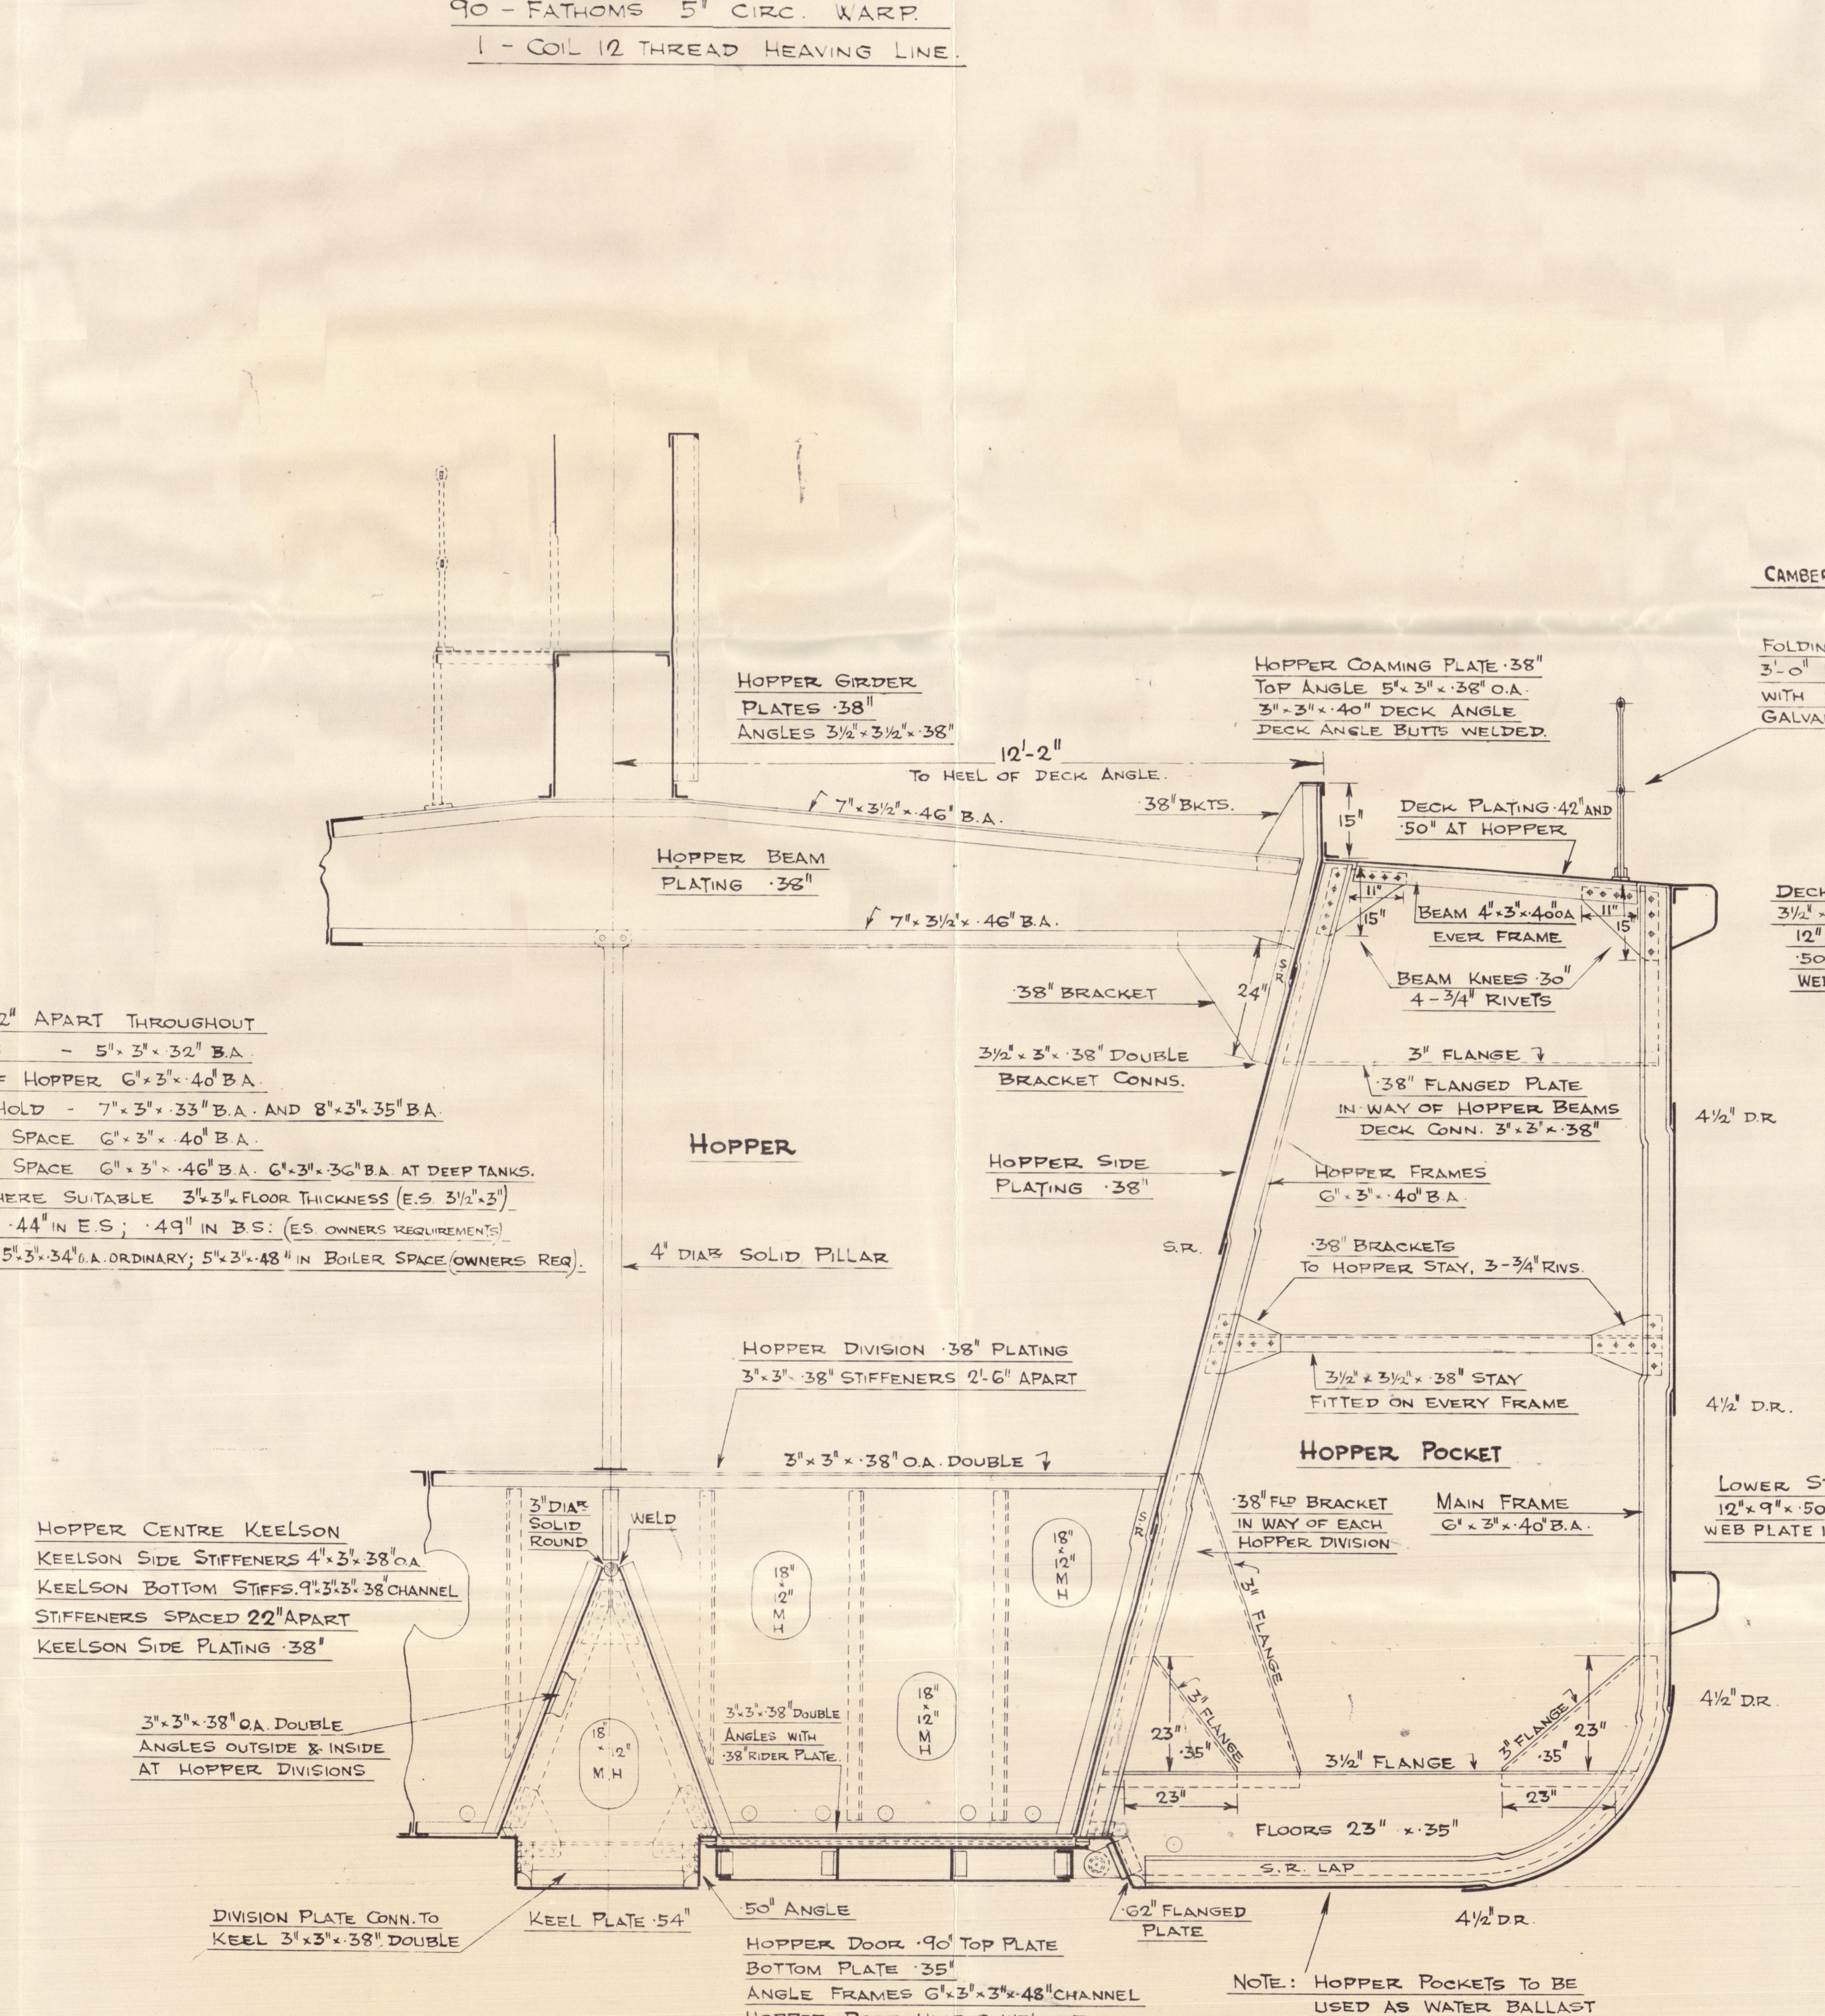

SECTION THRO' HOPPER.

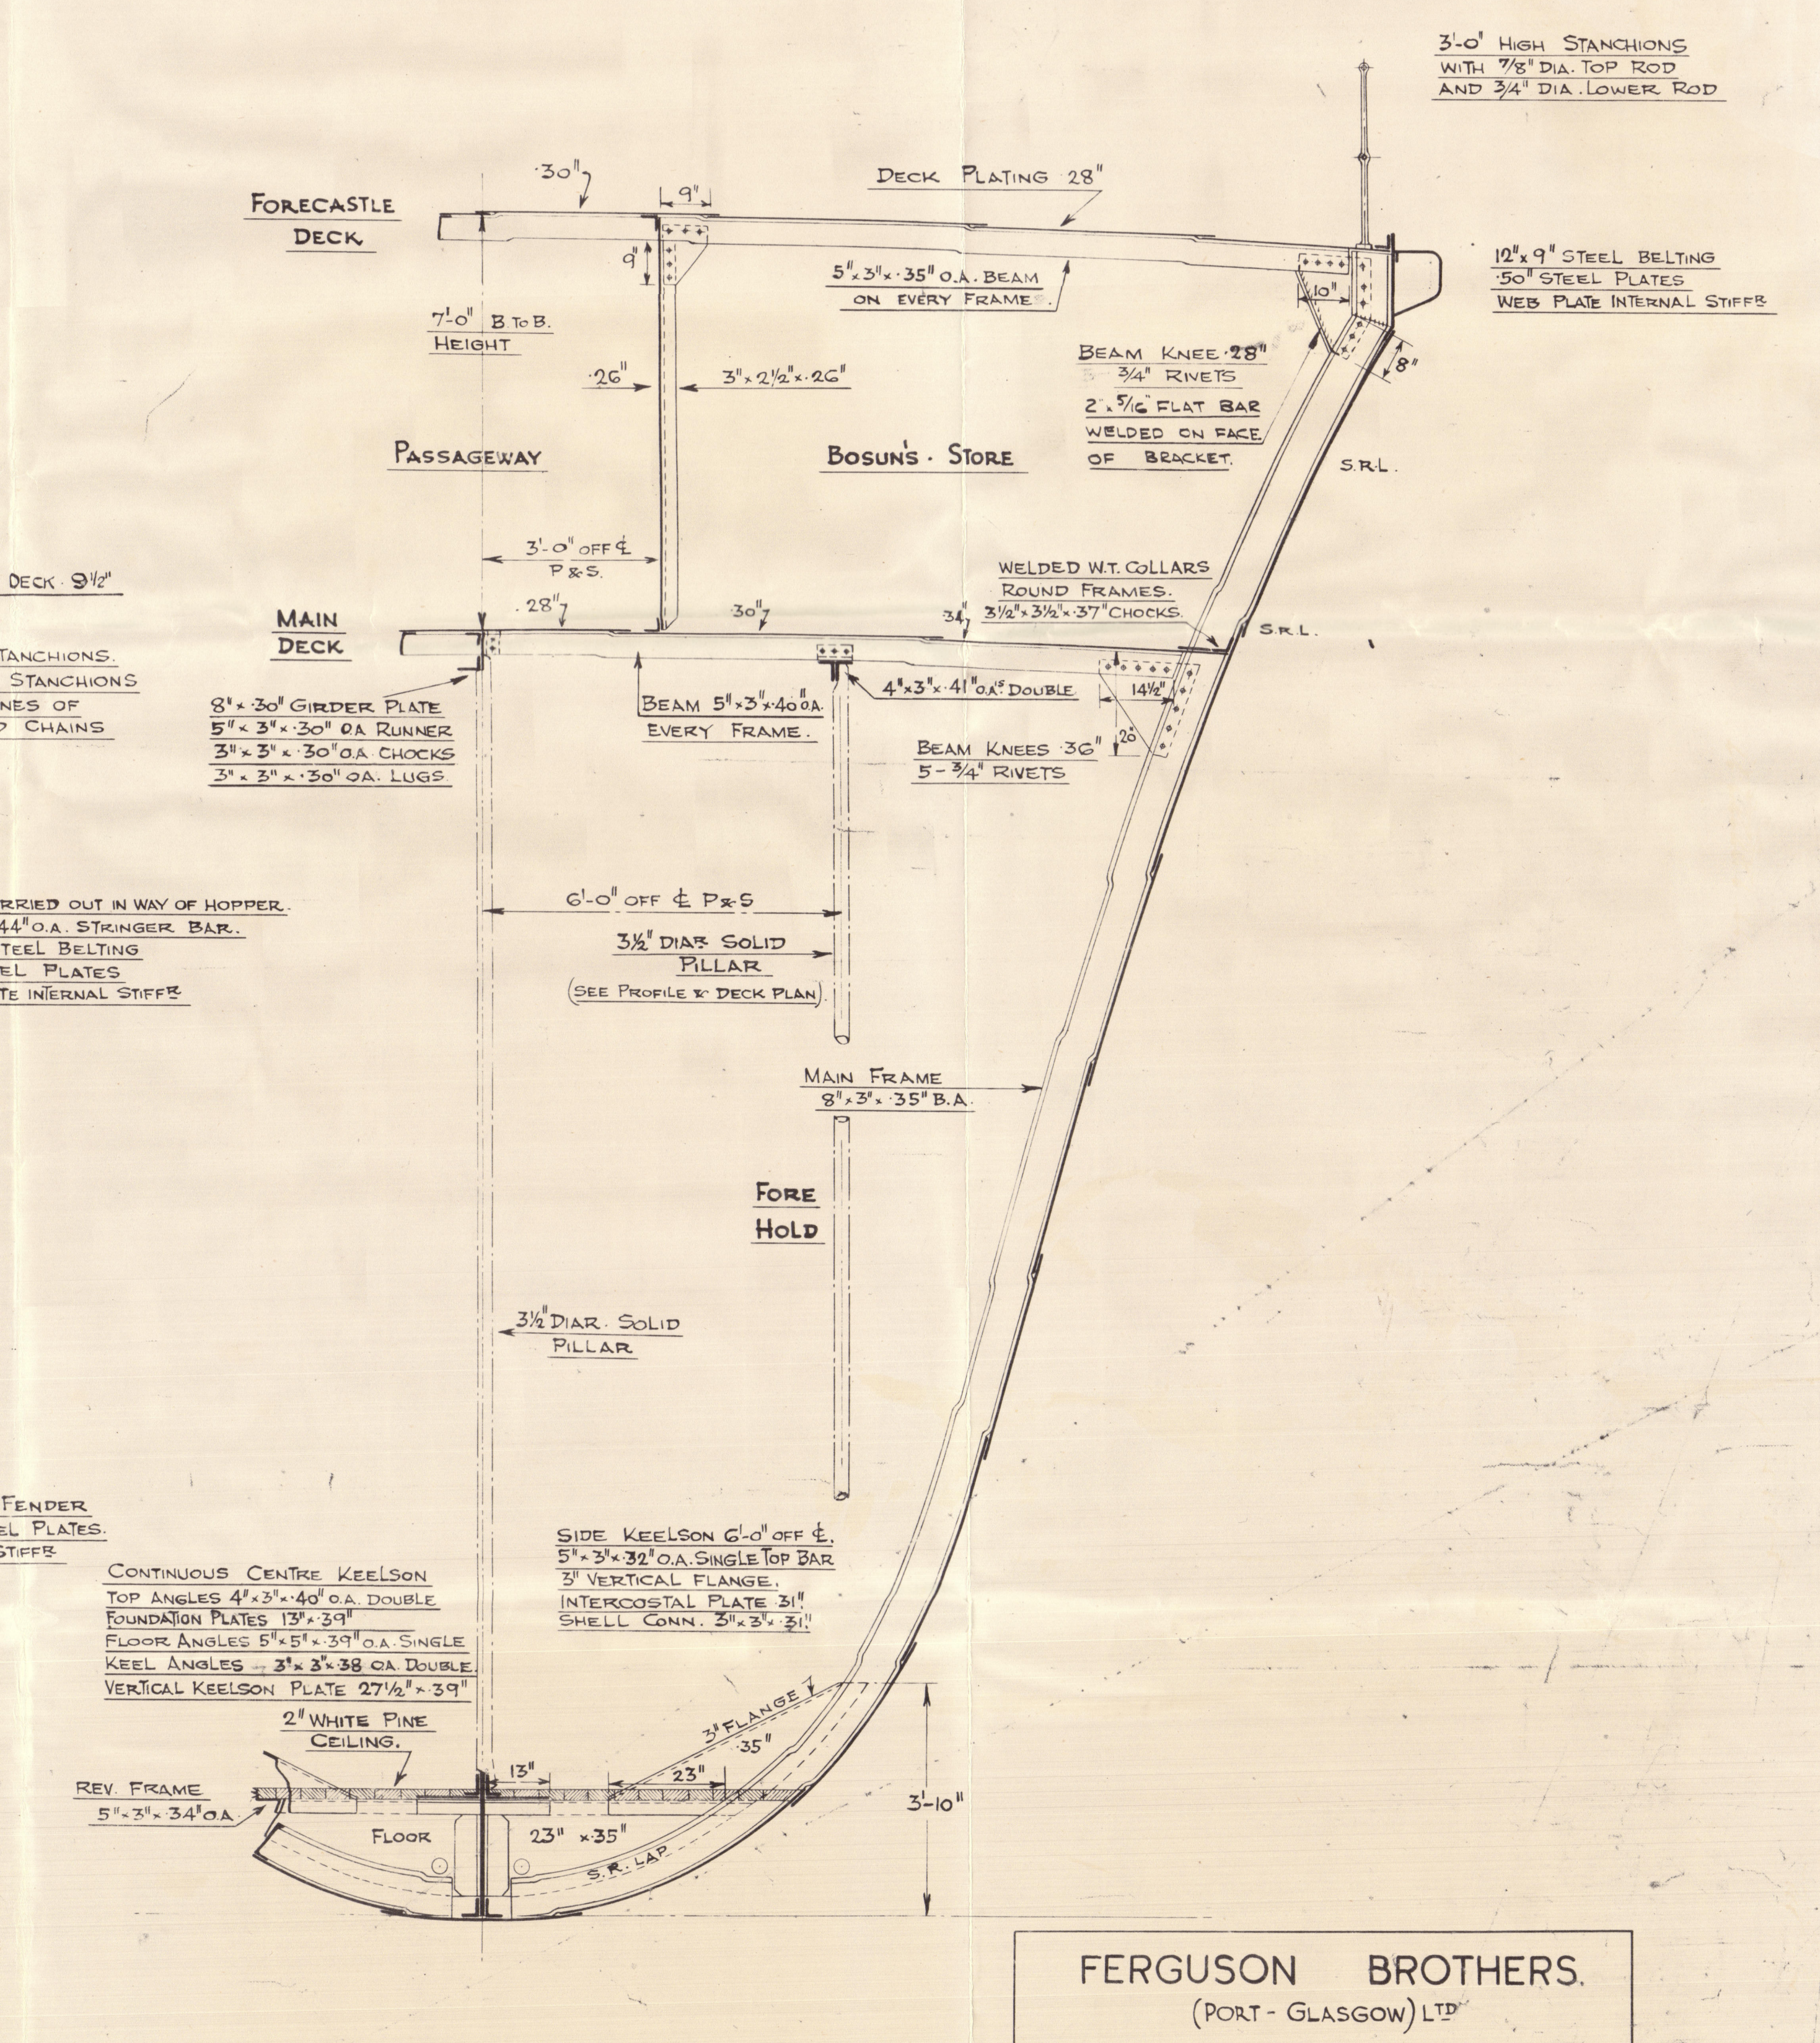

SECTION THRO' FORE HOLD.

FERGUSON BROTHERS.
(PORT - GLASGOW) LTD.
SHIPBUILDERS & ENGINEERS.
DRAWN BY: [Signature] DATE: 5-12-49 CHECKED BY: [Signature]
DRAWING NO. 11 / 397
Lloyd's Register Foundation

FERGUSON BROS. (P.G.) LTD

YARD N° 408

"J. P. NEBB" ★

HULL SECTIONS

AS BUILT

Greenock J. E. Report N° 25268

RECORDS DEPT.
LONDON.



© 2020

Lloyd's Register
Foundation

008720-008727-0023