


SCALE 1:200

[illegible]

DAILY TRAVEL		73.3	6.7	2.50	26.65
JANUARY TRIP		77.0	1.2	2.50	26.65
DAILY TRAVEL		63.3	2.3	2.5	16.88
JANUARY TRIP		66.0	3.8	2.5	16.88
TOTAL		78	3.2	4.7	
DISTRIBUTION TRAIL	(D)	68.71	2.0	16.69	4.89
	(B)	2.0		16.54	4.89
FEED WATER TRAIL	(F)	47.71	6	16.94	5.78
FEED W/ RETURN TRAIL	(R)	39.81	1	2.25	6.78
		1		2.26	6.78
W/ W/ W/ W/ TRAIL	(C)	61.43	6	16.68	16.31
W/ W/ W/ W/ TRAIL	(C)	6		16.68	11.31
W/ W/ W/ W/ TRAIL	(C)	49.84	6	17.44	9.46
		6			

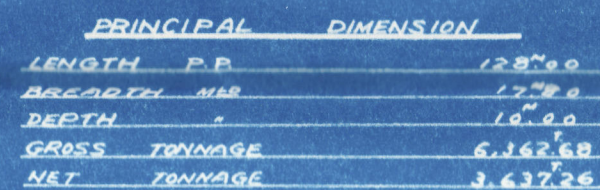

团内番号

068773-008777-000

008773-008777-0001

Yka F.E. Apt no. 667

COPY FOR
LONDON OFFICE

RECORDS DEPT
LONDON

16

Hikosan Maru ★
Capacity Plan (as built)



© 2021

008773-008777-0001
Lloyd's Register
Foundation