


M.S. № 67.
249'-9" X 40'-8" X 19'-4".
CLASSED AT LLOYDS ± 100 A 1.
SCALE 1:20. MAT: STEEL

EQUIPMENT.

✓ 2 BOWERS	33	C.WTS. EACH	STOCKLESS.
✓ 1 " "	28	"	"
✓ 1 STREAM ANCHOR	8 1/2	C.WTS. EXCL. STOCK.	
✓ 1 KEDGE	4 1/2	"	"
✓ 240 FTMS. STUB CHAIN CABLE	1 1/16	DIAMETER	
✓ 1 STEEL WIRE	4"	CIRC	75 FMS. LONG.
✓ 1 " "	3 1/2	"	90 " "
✓ 2 HEMP HAWSERS	6"	CIRC.	30 " "
✓ 2 " "	5	"	90 " "

LONGITUDINAL NUMBER = L x (B + D) = 14.985	✓
TRANSVERSE " " = B + D = 60.	✓
PROPORTION LENGTH TO DEPTH = 12.92	✓
d FOR FRAMING = 16'-5"	✓

EQUIPMENT - NUMBER.	
LONGITUDINAL №	= 14.985
3/4 x 23 x 8' FOR FORE CASTLE	= 138
3/4 x 56.75 x 8' BRIDGE	= 340
3/4 x 23 x 8' POOP	= 138
1/2 x 18 x 7.25' SALOON	= 65
EQUIPMENT NUMBER	= 15.666

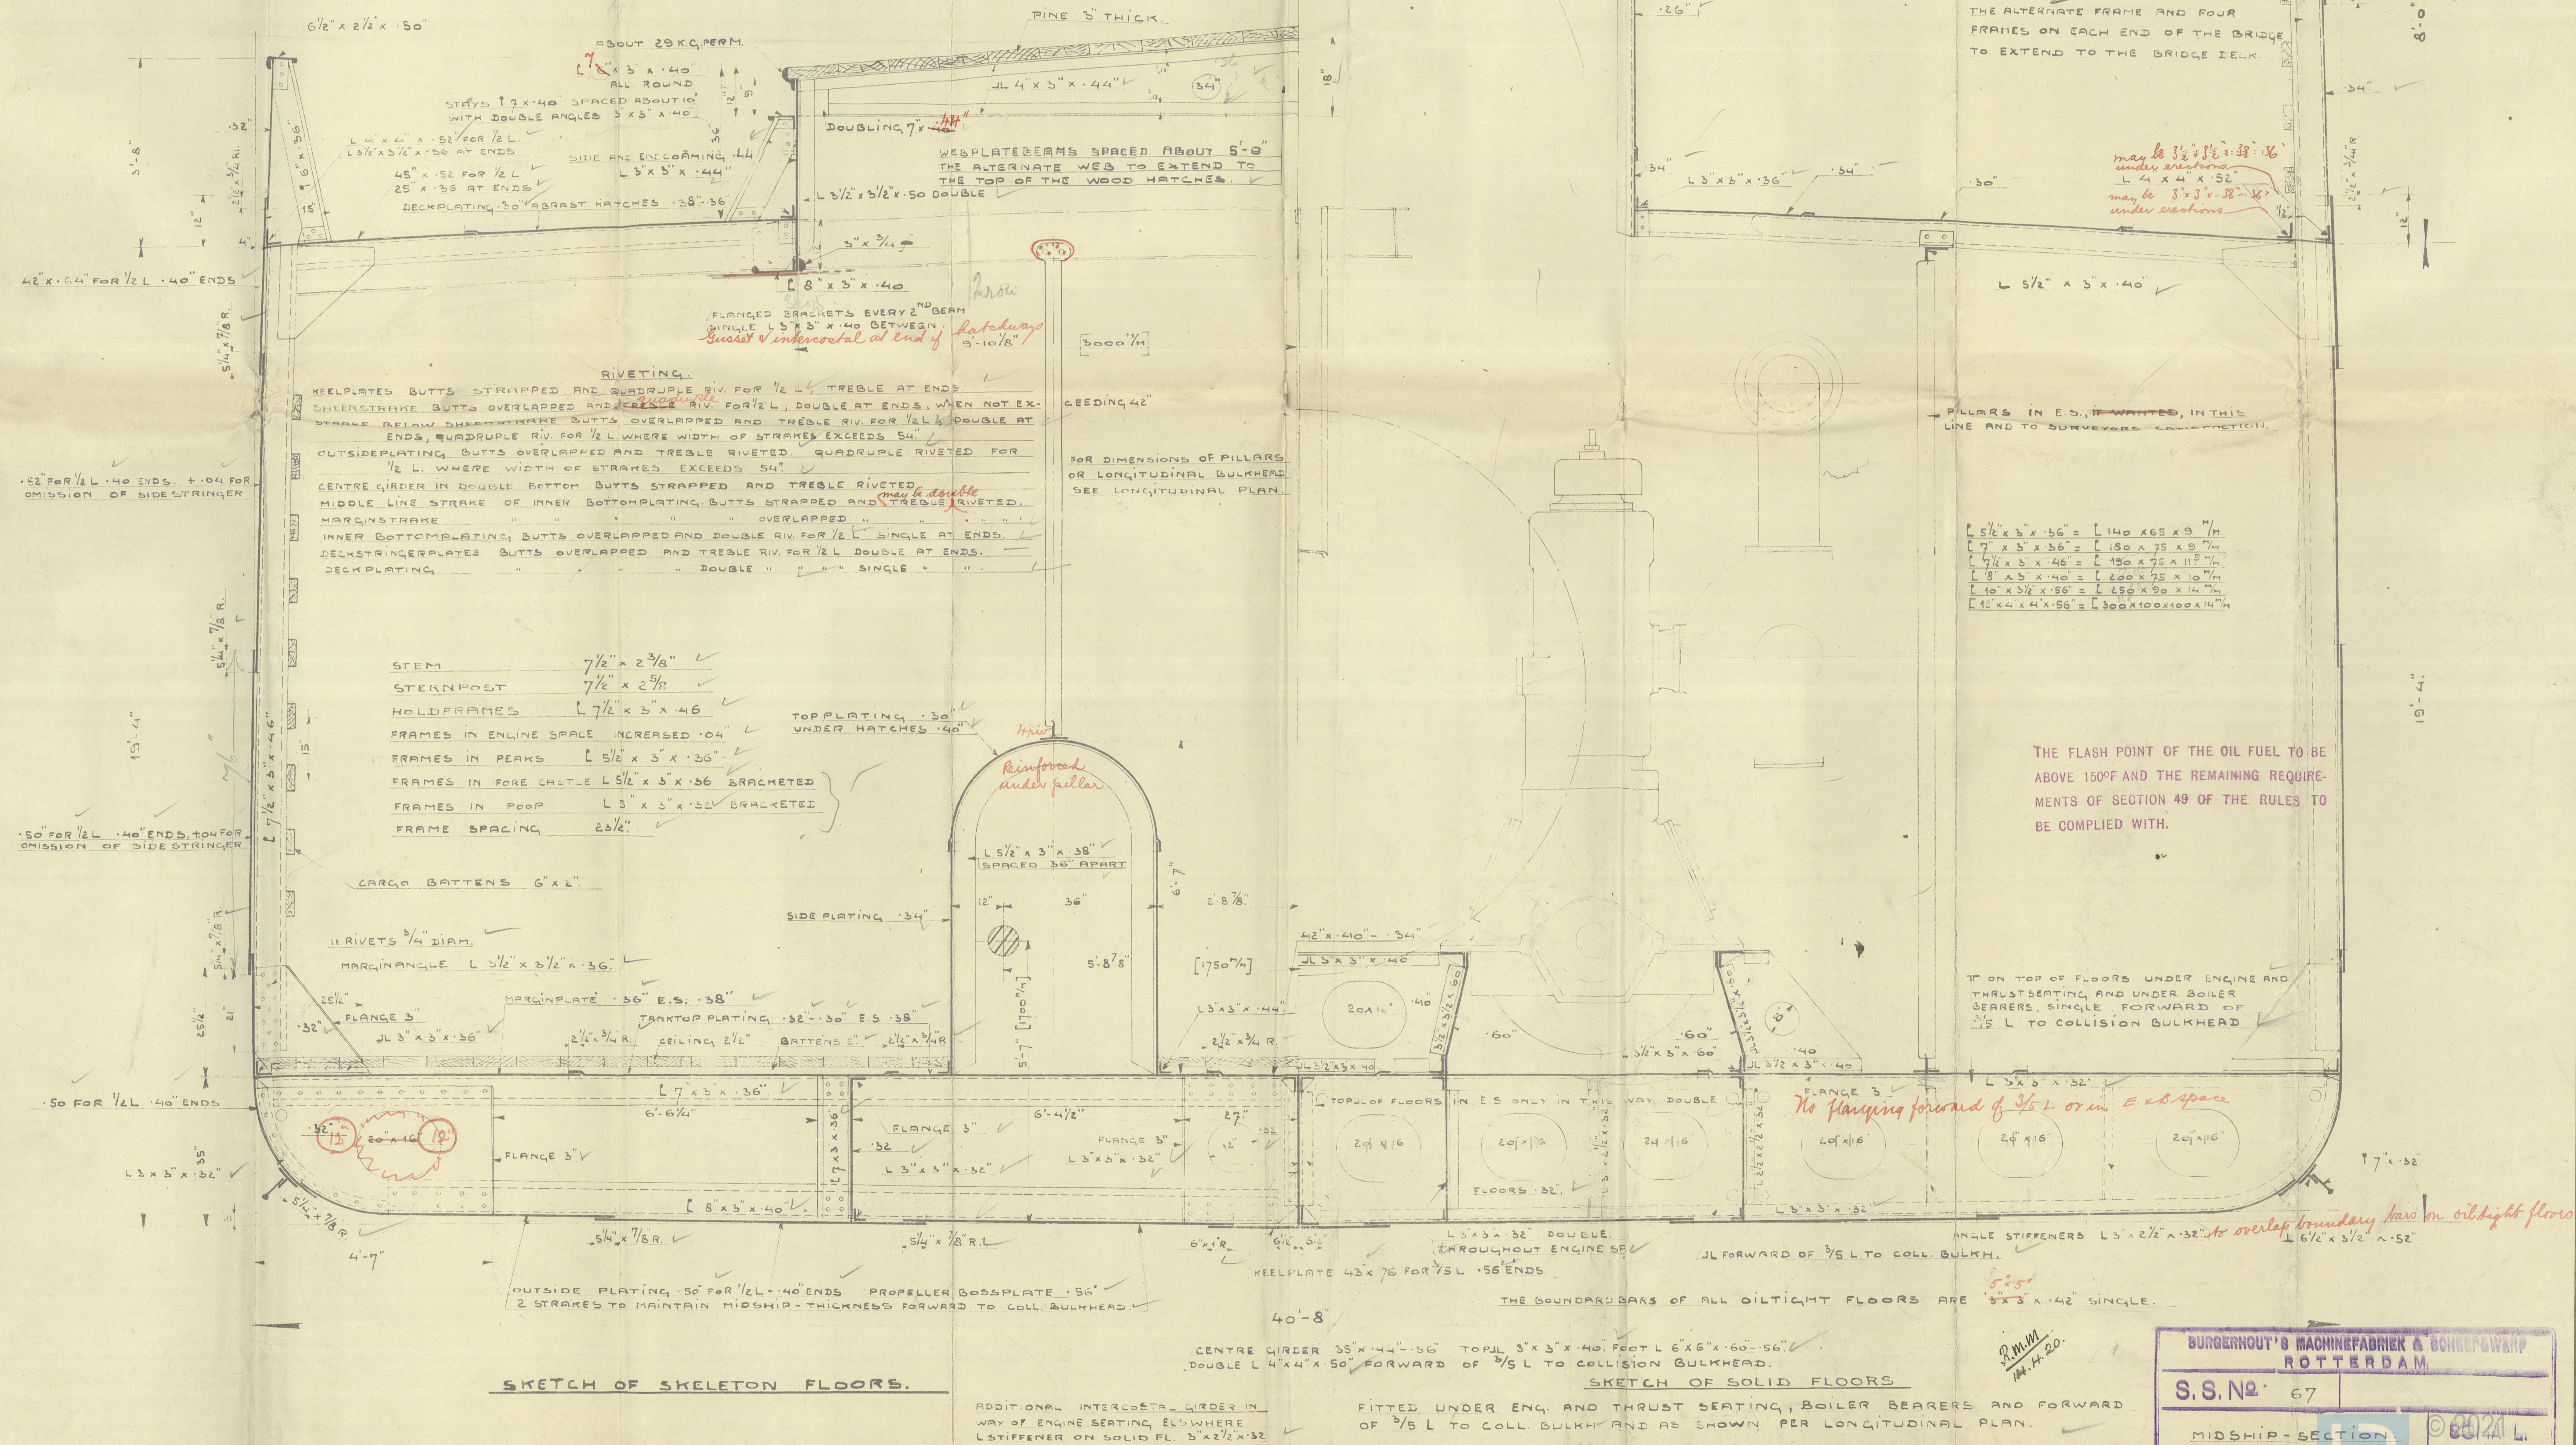

Kurzenbont's

67

~~Section~~

Section

~~Gen. Box 3157.~~

L. Dordrecht.

Roll 12555.



© 2021

Lloyd's Register
Foundation

008804 - 008811 - 0219