
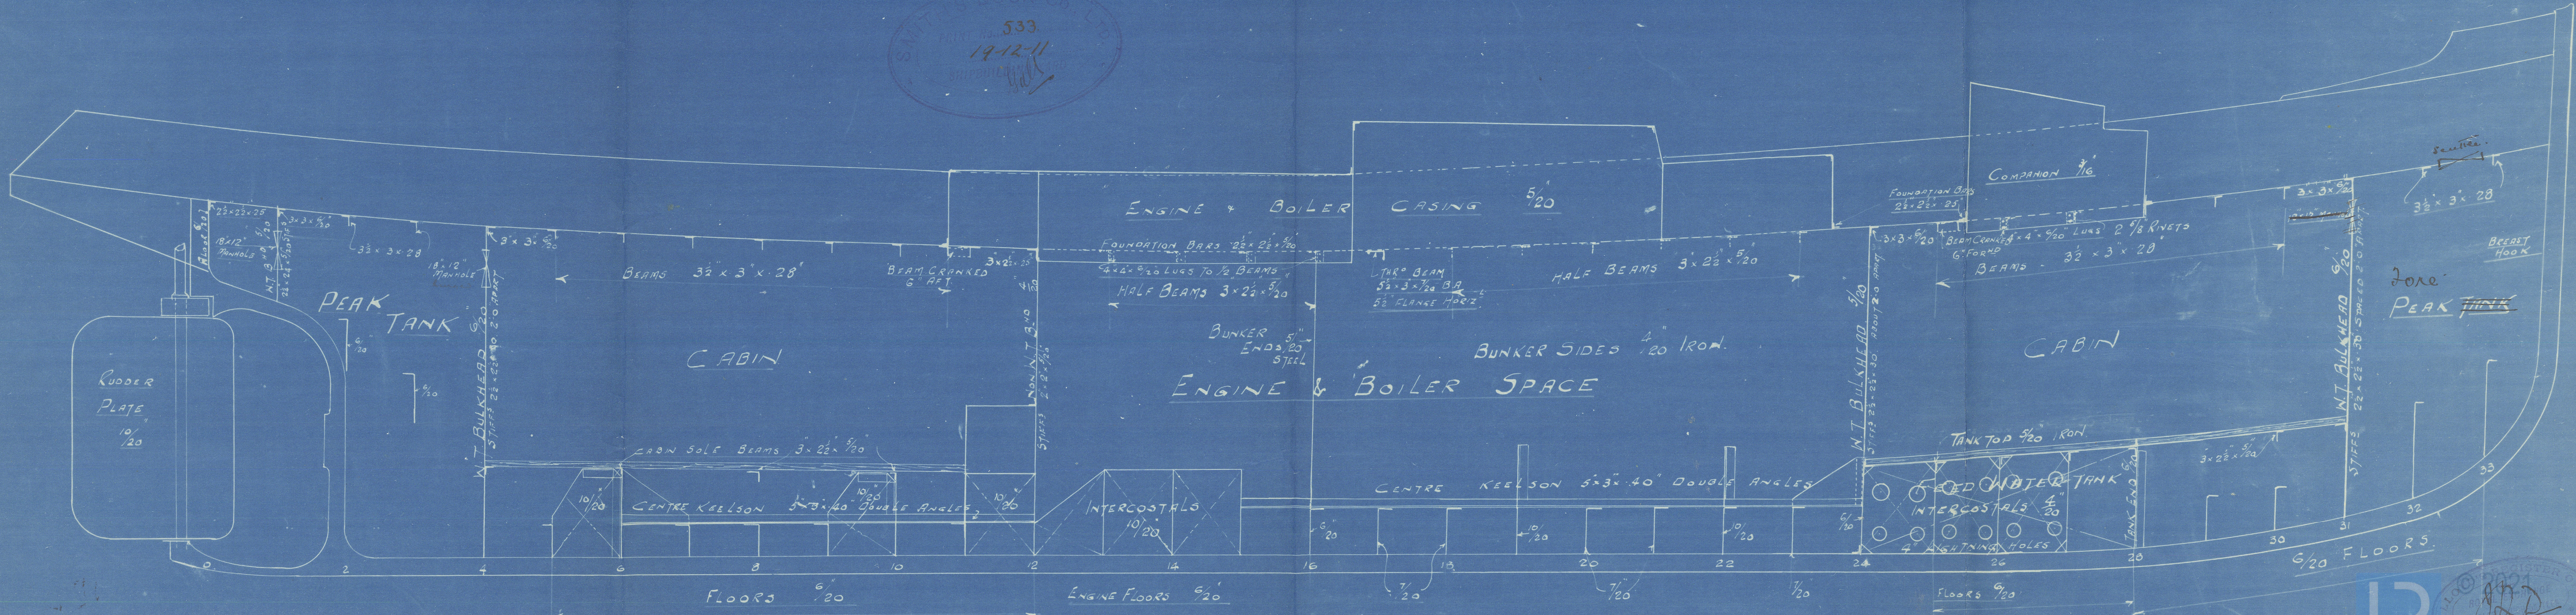


ELEVATION OF A STEEL SCREW TUG
N° 499

DIMENSIONS - 60'-0" B.P. x 14'-0" M^{LD} x 7'-10" M^{LD}

CLASSED 100A1 LLOYDS FOR TOWING PURPOSES

SCALE 1/2" = 1 FOOT

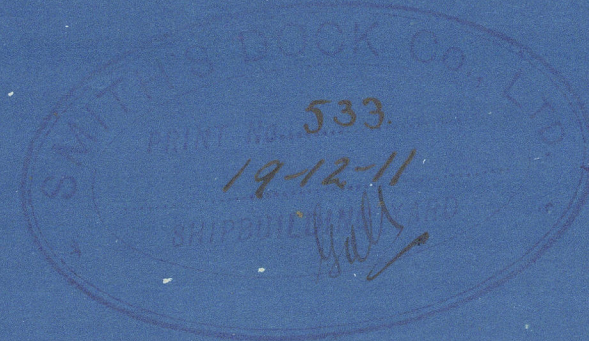

Dear Smith Dock 602

No 499

Elevation

(as built)

S. S. Smith Dock 603.

Draw. 20. 7/76.



© 2021

Lloyd's Register
Foundation

008839-008846-0034