

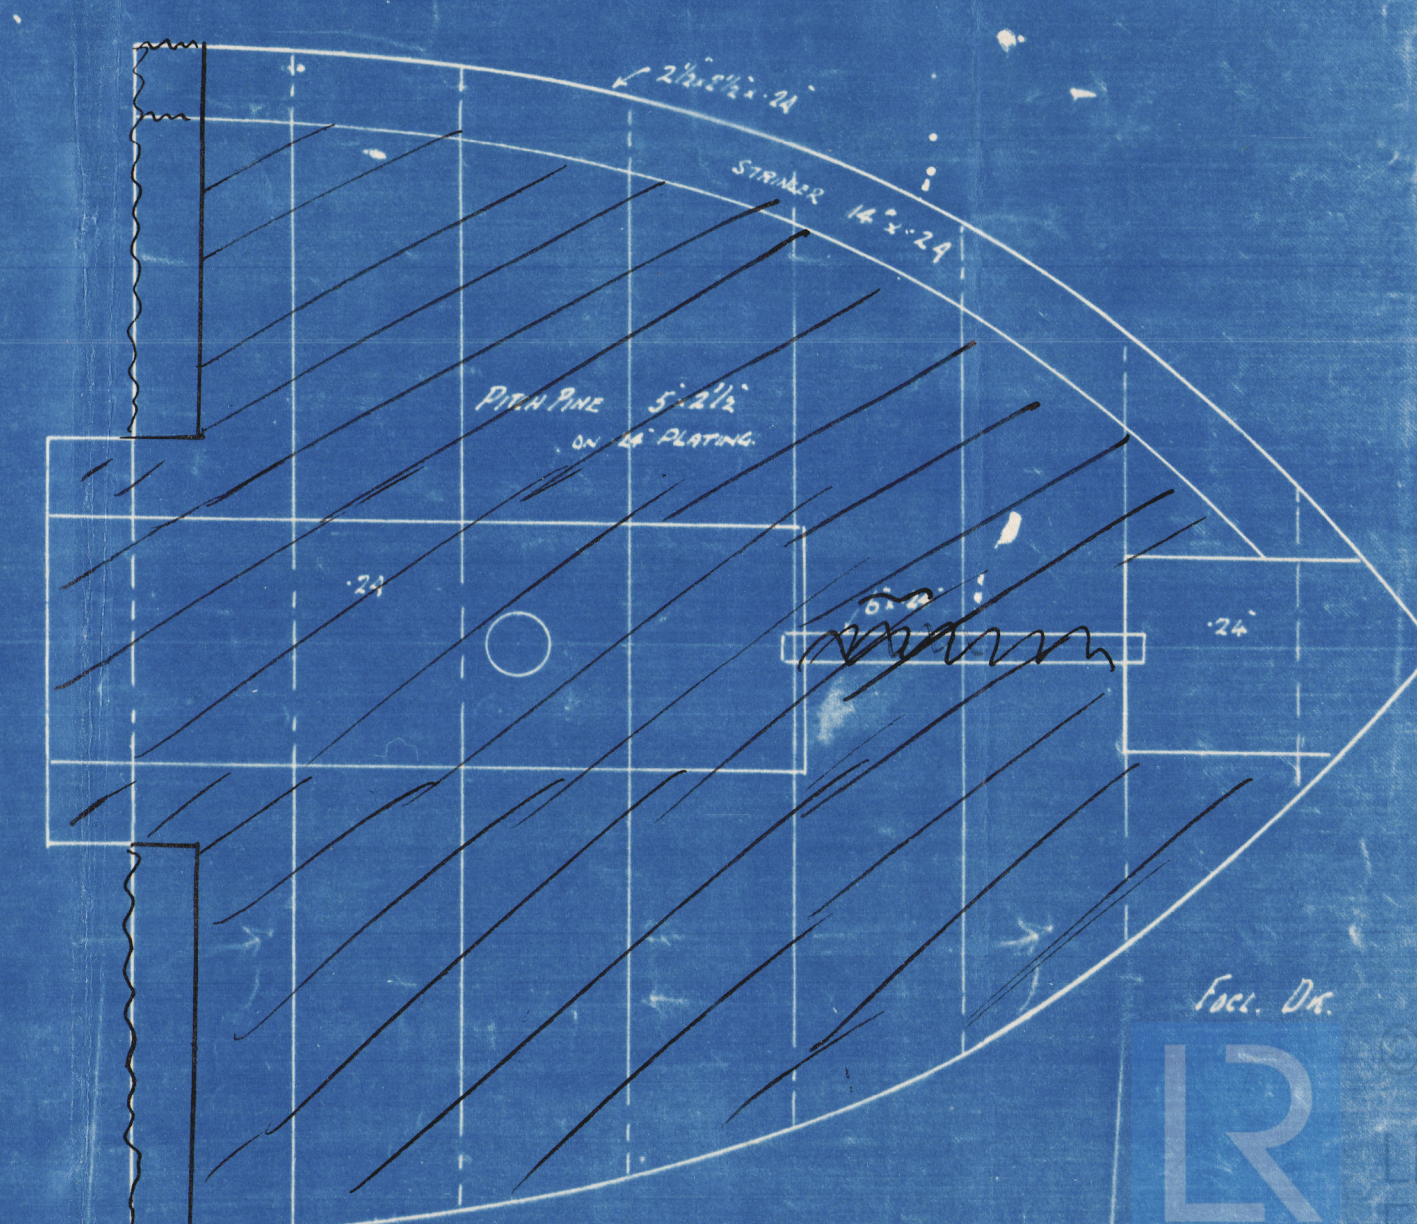
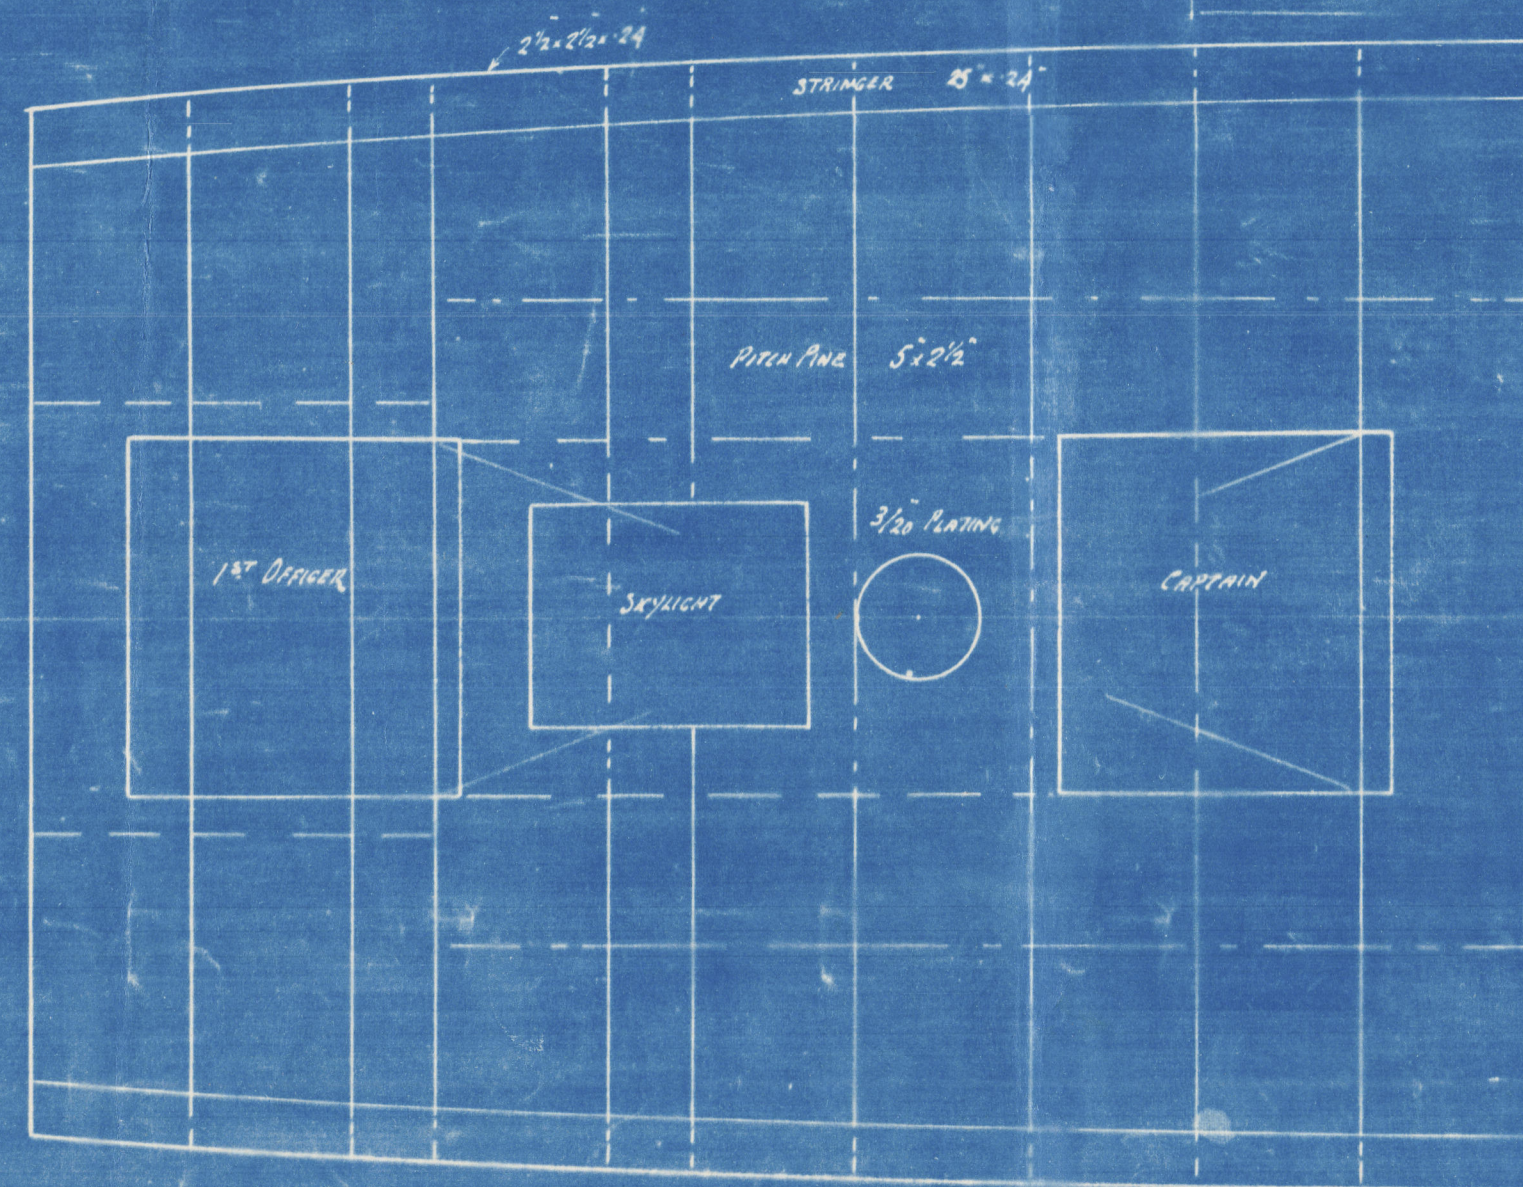


PROFILE & DECK PLAN  
Dimensions - 135'-0" x 26'-0" x 9'-6" M.O.  
To Lines 100 ft. at 100 ft. intervals  
Scale 1/4" = 1'

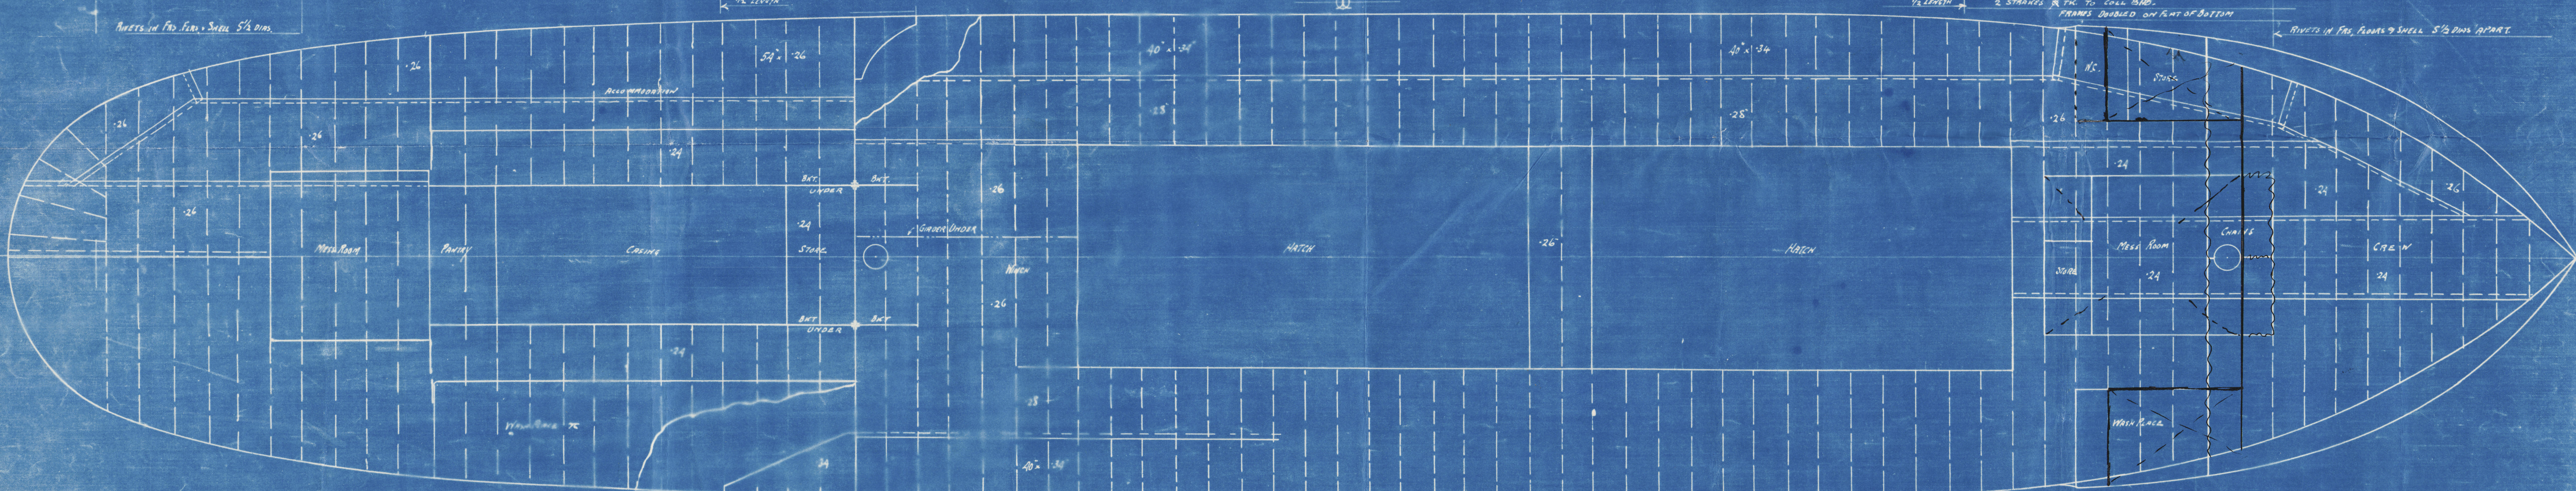

Scale 1/4" = 1'

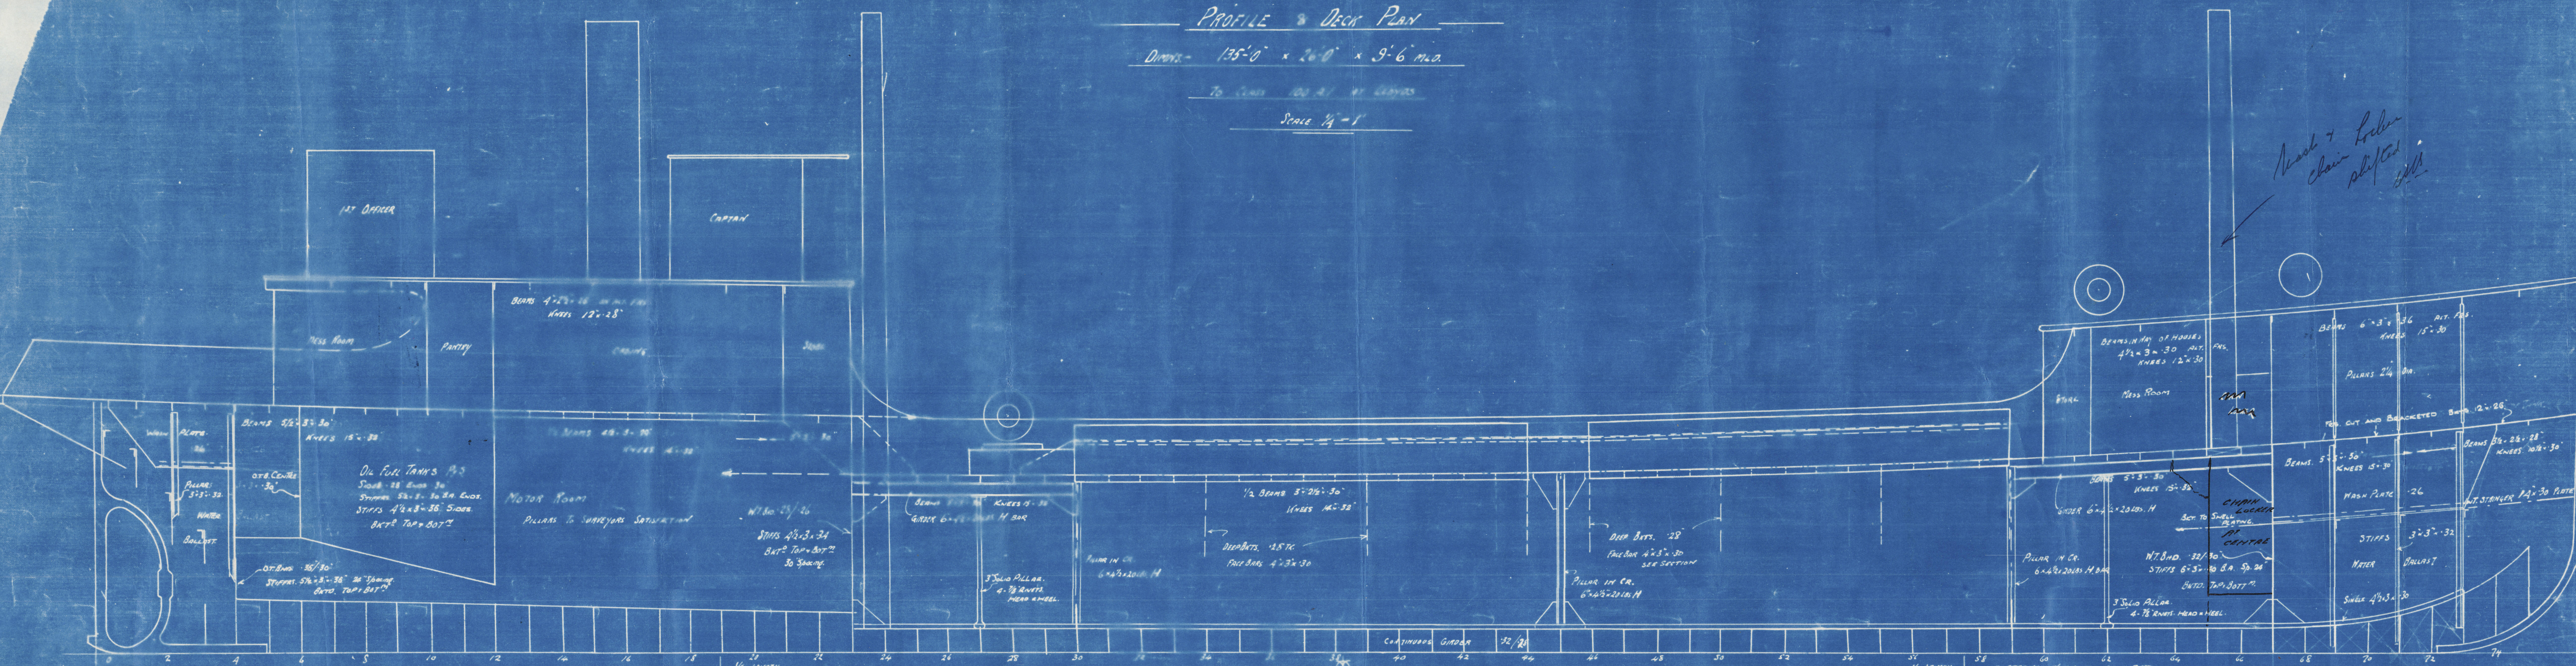

Geo. Brown & Co.

M.V. KATOORA

N<sup>o</sup> 155.

Profile & D<sup>n</sup> plan  
as Built.

M.V. "KATOORA"

GRK. 18783.

Greenk. Rep<sup>t</sup> N<sup>o</sup> 18783.



© 2021

Lloyd's Register  
Foundation

008855-008862-0049