

No 155. KATOORA

MIDSHIP SECTION

SCALE = 1/2" = ONE FOOT

LLOYDS 100 A.I. CLASS

NUMERALS



D	95
1 st LONG. NO. L x D	1280
2 nd LONG. NO. L (S-D)	4783
1/2 TO MAIN DE.	142
1/2 TO ROR DE.	108

EQUIPMENT No: 47925

RAISED Q. DE.	41 x 3	123.0
FORECASTLE DE.	27 x 7 x 3/4	142.0
BRIDGE DE.	23 x 7 x 3/4	121.0
		578.5

EQUIPMENT:

- 1-8 1/2 CWT STOCKLESS ANCHOR
- 1-8 " " " "
- 1-2 1/2 " ANCHOR " "
- 155 FMS 3/16" STUO LINK CABLE
- 45 FMS 2 1/4" STEEL WIRE ROPE
- 75 FMS 2 1/2 " " "
- 90 FMS 5" MANILLA

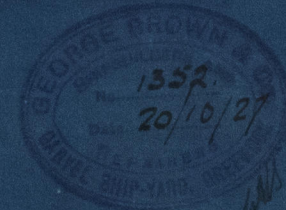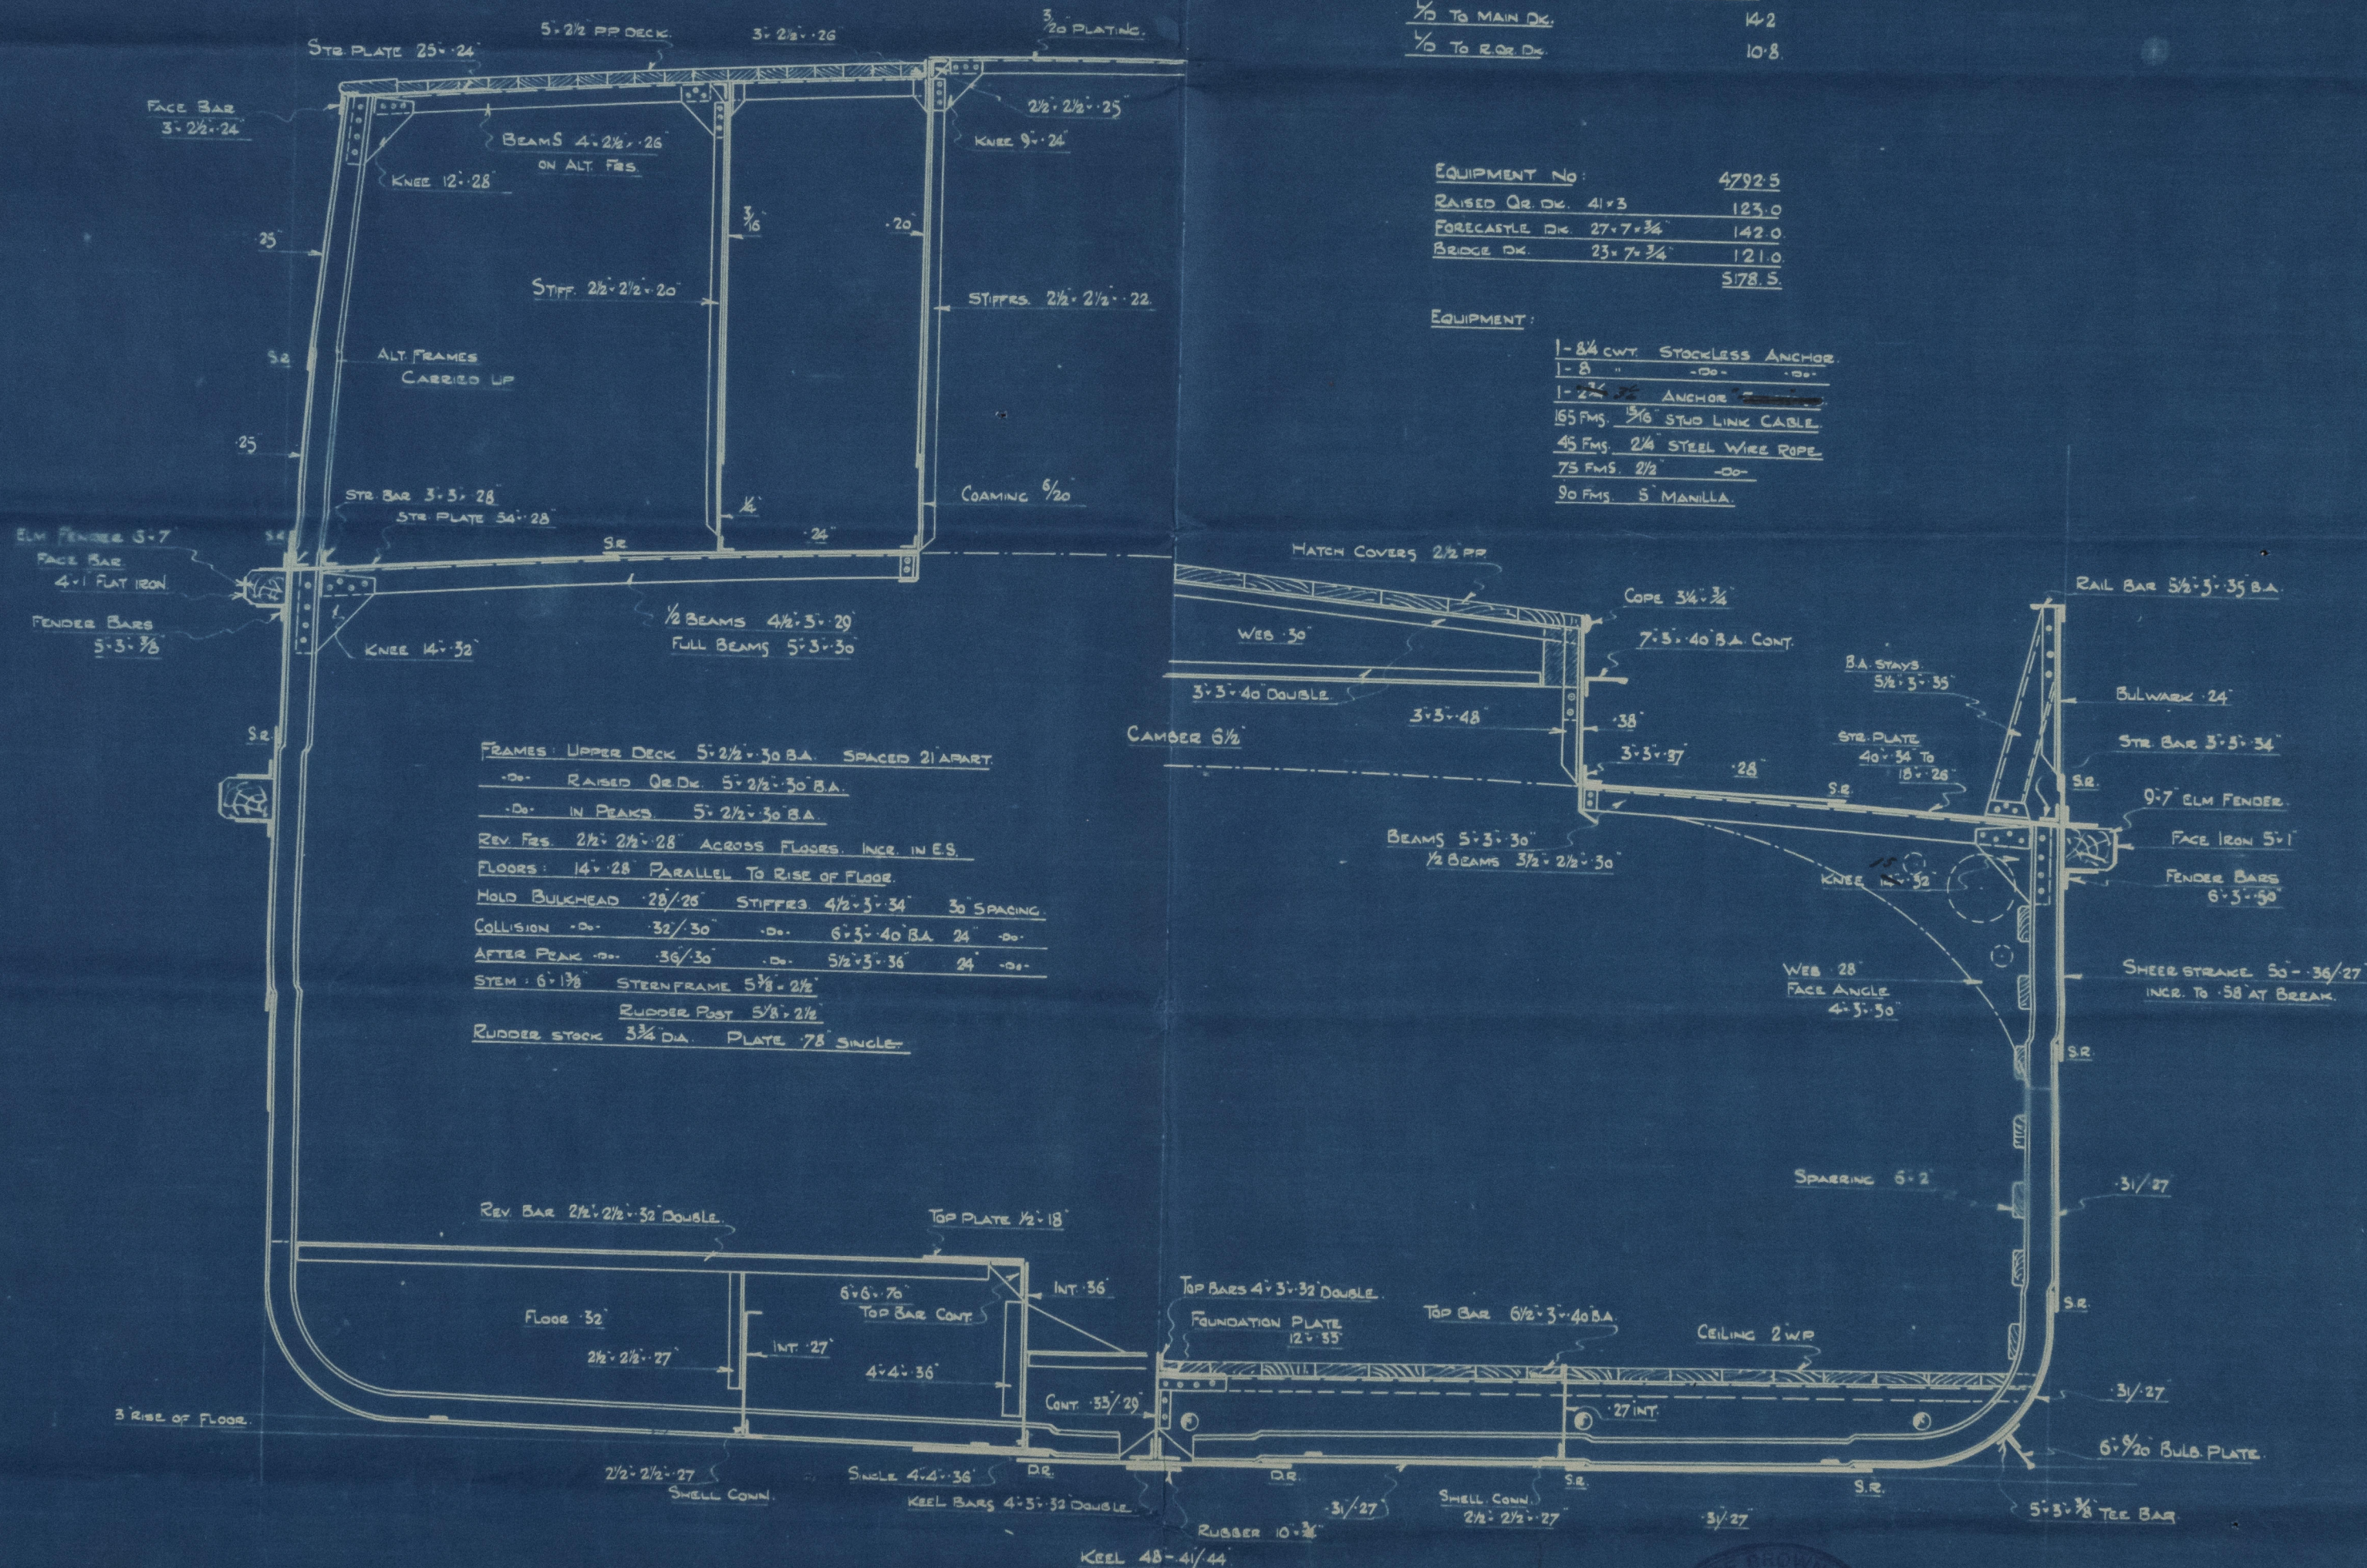

Lloyd's Register of Shipping

Geo. Brown & Co.

M.V. KATOORA

No. 155.

Midships Section
as Built.

M.V. "KATOORA"

GRK. 18783.

Grk. Ref. 18783.

© 2021

Lloyd's Register
Foundation

008855-008862-0051