
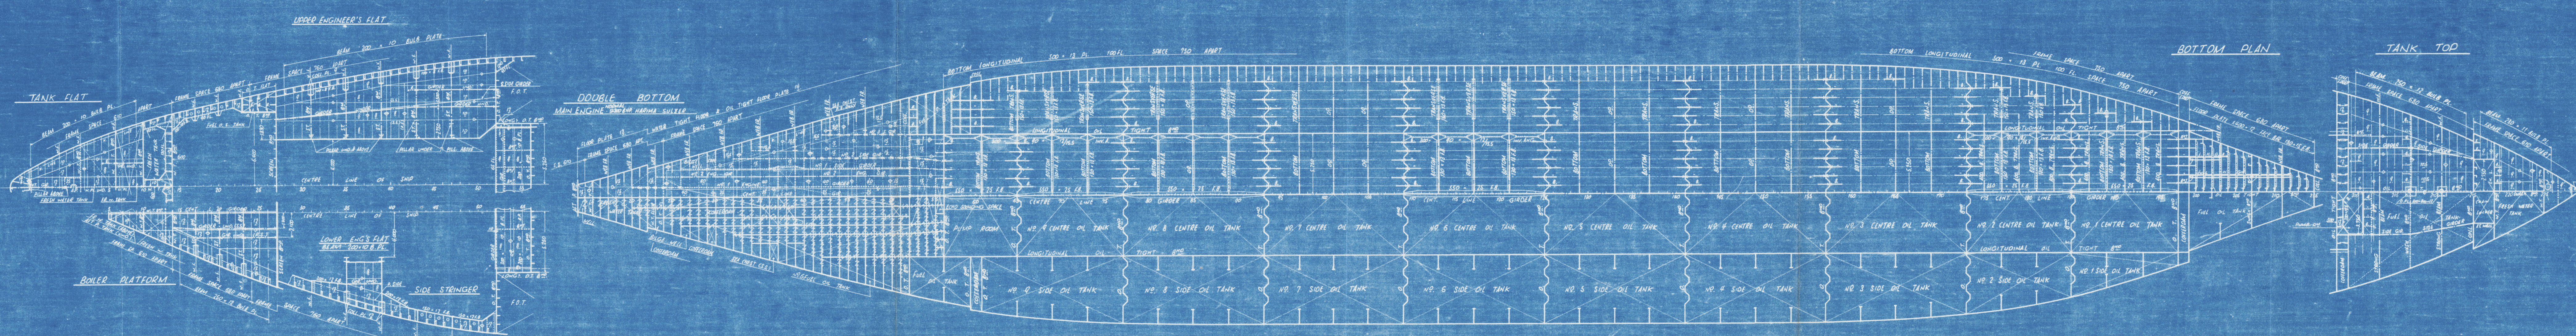
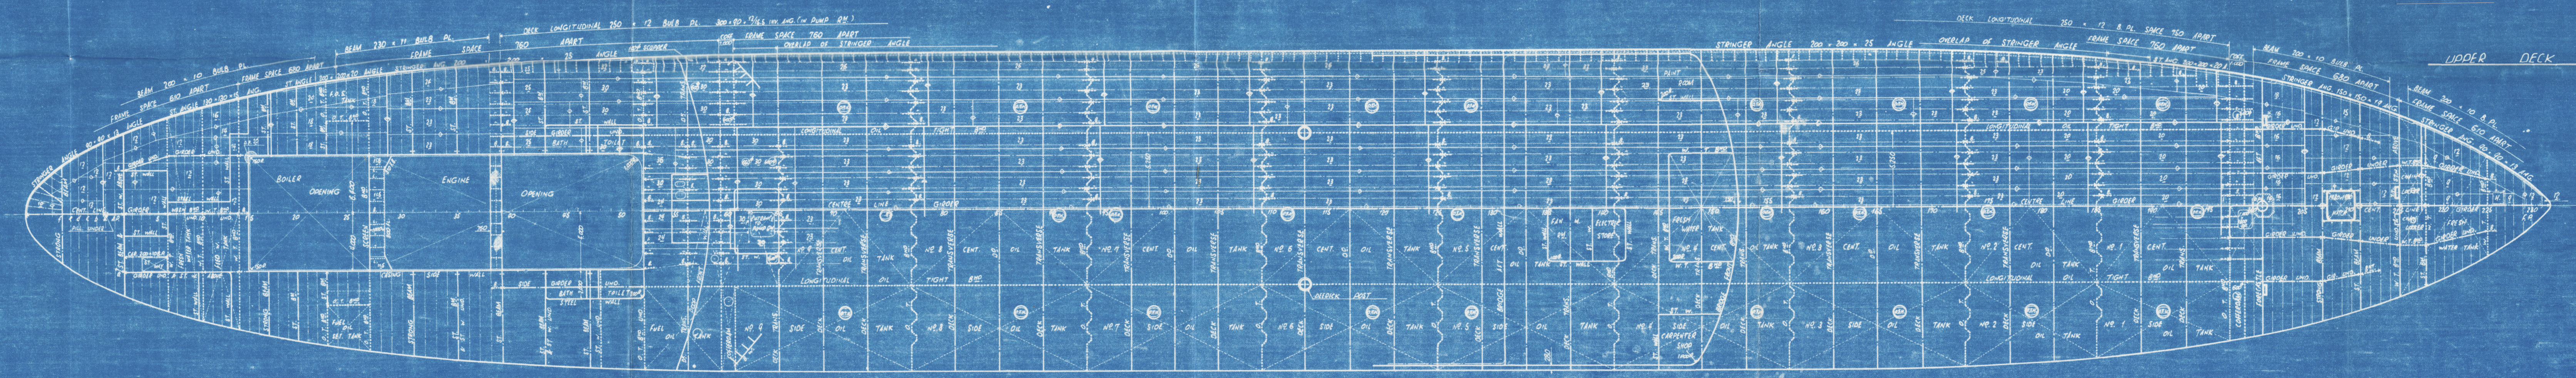
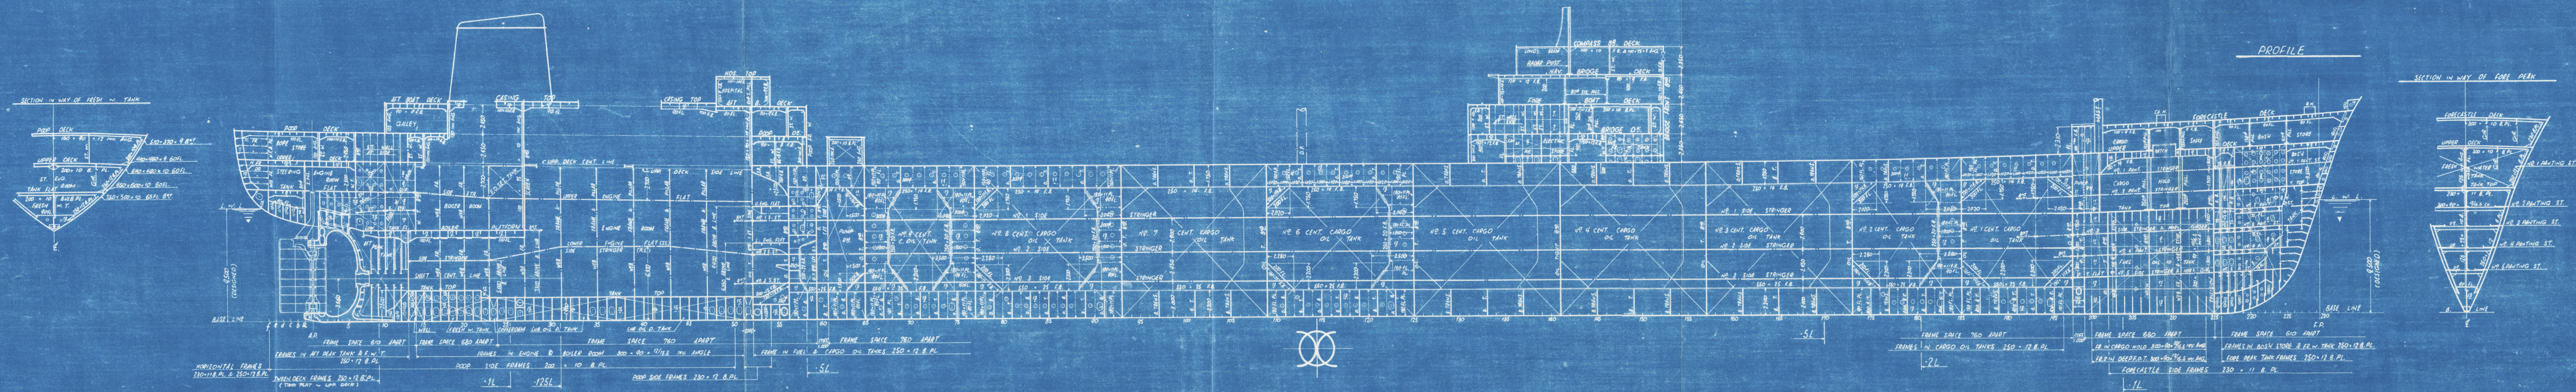


CONSTRUCTION PROFILE AND DECK PLAN

SCALE 1/200

PRINCIPAL DIMENSIONS	
LENGTH (B.D.)	167'00"
LENGTH FROM AFT SIDE OF PARTIAL BACK POST	166'53"
BREADTH (M.L.D.)	22'30"
DEPTH (M.L.D.)	12'30"
DRAFT (DESIGNED)	9'50"
SHEER AT A.P.	2"00"
NO SHEER PART	FWP 81 1/2' - FWP 141'7"

Certified copy of Approved Plan

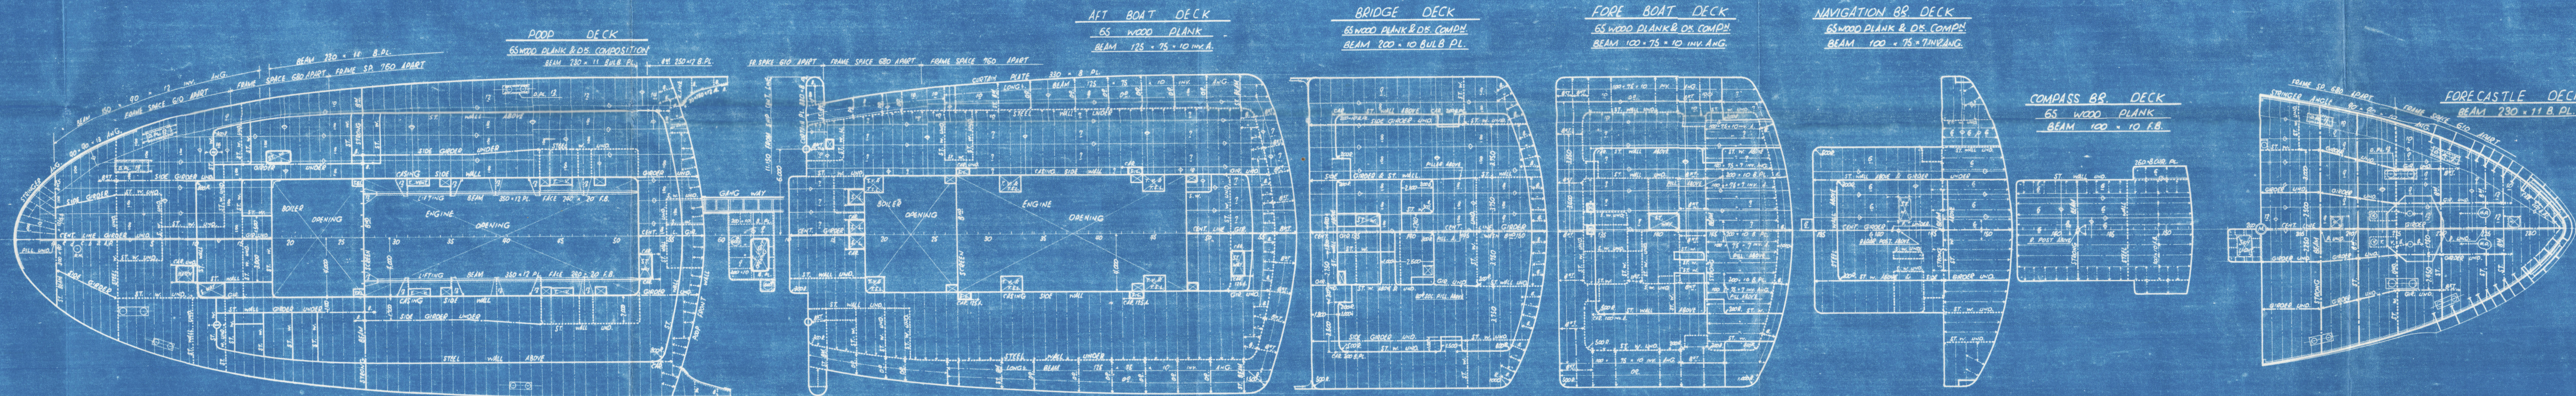

SN 481

ISE MARU

CONSTRUCTION
PROFILE &
DECK PLAN

As built

DRAWING NO H-3

SN 481

伊勢丸

鋼材配置

完成圖

尺度 1/200

船殼設計課

課長係長担当製圖

製圖年月日 昭和29年6月20日

出番 山本

圖印年月日 昭和29年6月20日

圖印番號 船殼-2

008830-598800




"Ise Hara"

Construction profile
and deck plan,

(As built)

Kobe FE Rpt no. 2325

RECORDS DEPT.,
LONDON.

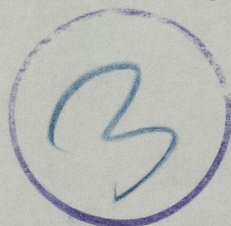

© 2021

Lloyd's Register
Foundation

008863-008870-0148

KOBE RPT. NO. 2325
DATED. _____



© 2021

Lloyd's Register
Foundation

008863-008870-0148