


-N°470-1+2-
MIDSHIP SECTION

OF THREE
STEEL SCREW TRAWLERS

DIMS. 130'-0" BP x 23'-0" EXT x 14'-0" MLD

CLASS 100A LLOYDS

SCALE 1/2" INCH


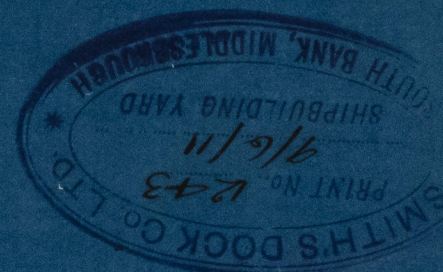


EQUIPMENT

1 ANCHOR (STOCKLESS) 7 1/2 cwt.
 1 " " " 7 " (EX-STOCK)
 120 fms 1 1/8" STUD LINK CHAIN.
 30 fms. 6" MANILLA.
 60 " 5" " "
 60 " 2 1/2" " "

RIVETING.

1" RIVETS IN KEEL & LOWER EDGE OF
 GARBOARD STRAKE.
 RIVETS 3/4" IN ALL SHELL SEAMS & BUTTS
 10-34" RIVS BETWEEN FRAMES IN EACH
 SEAM, EXCLUSIVE OF RIVETS IN FRAMES

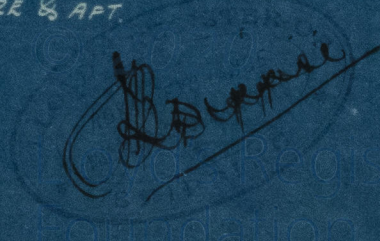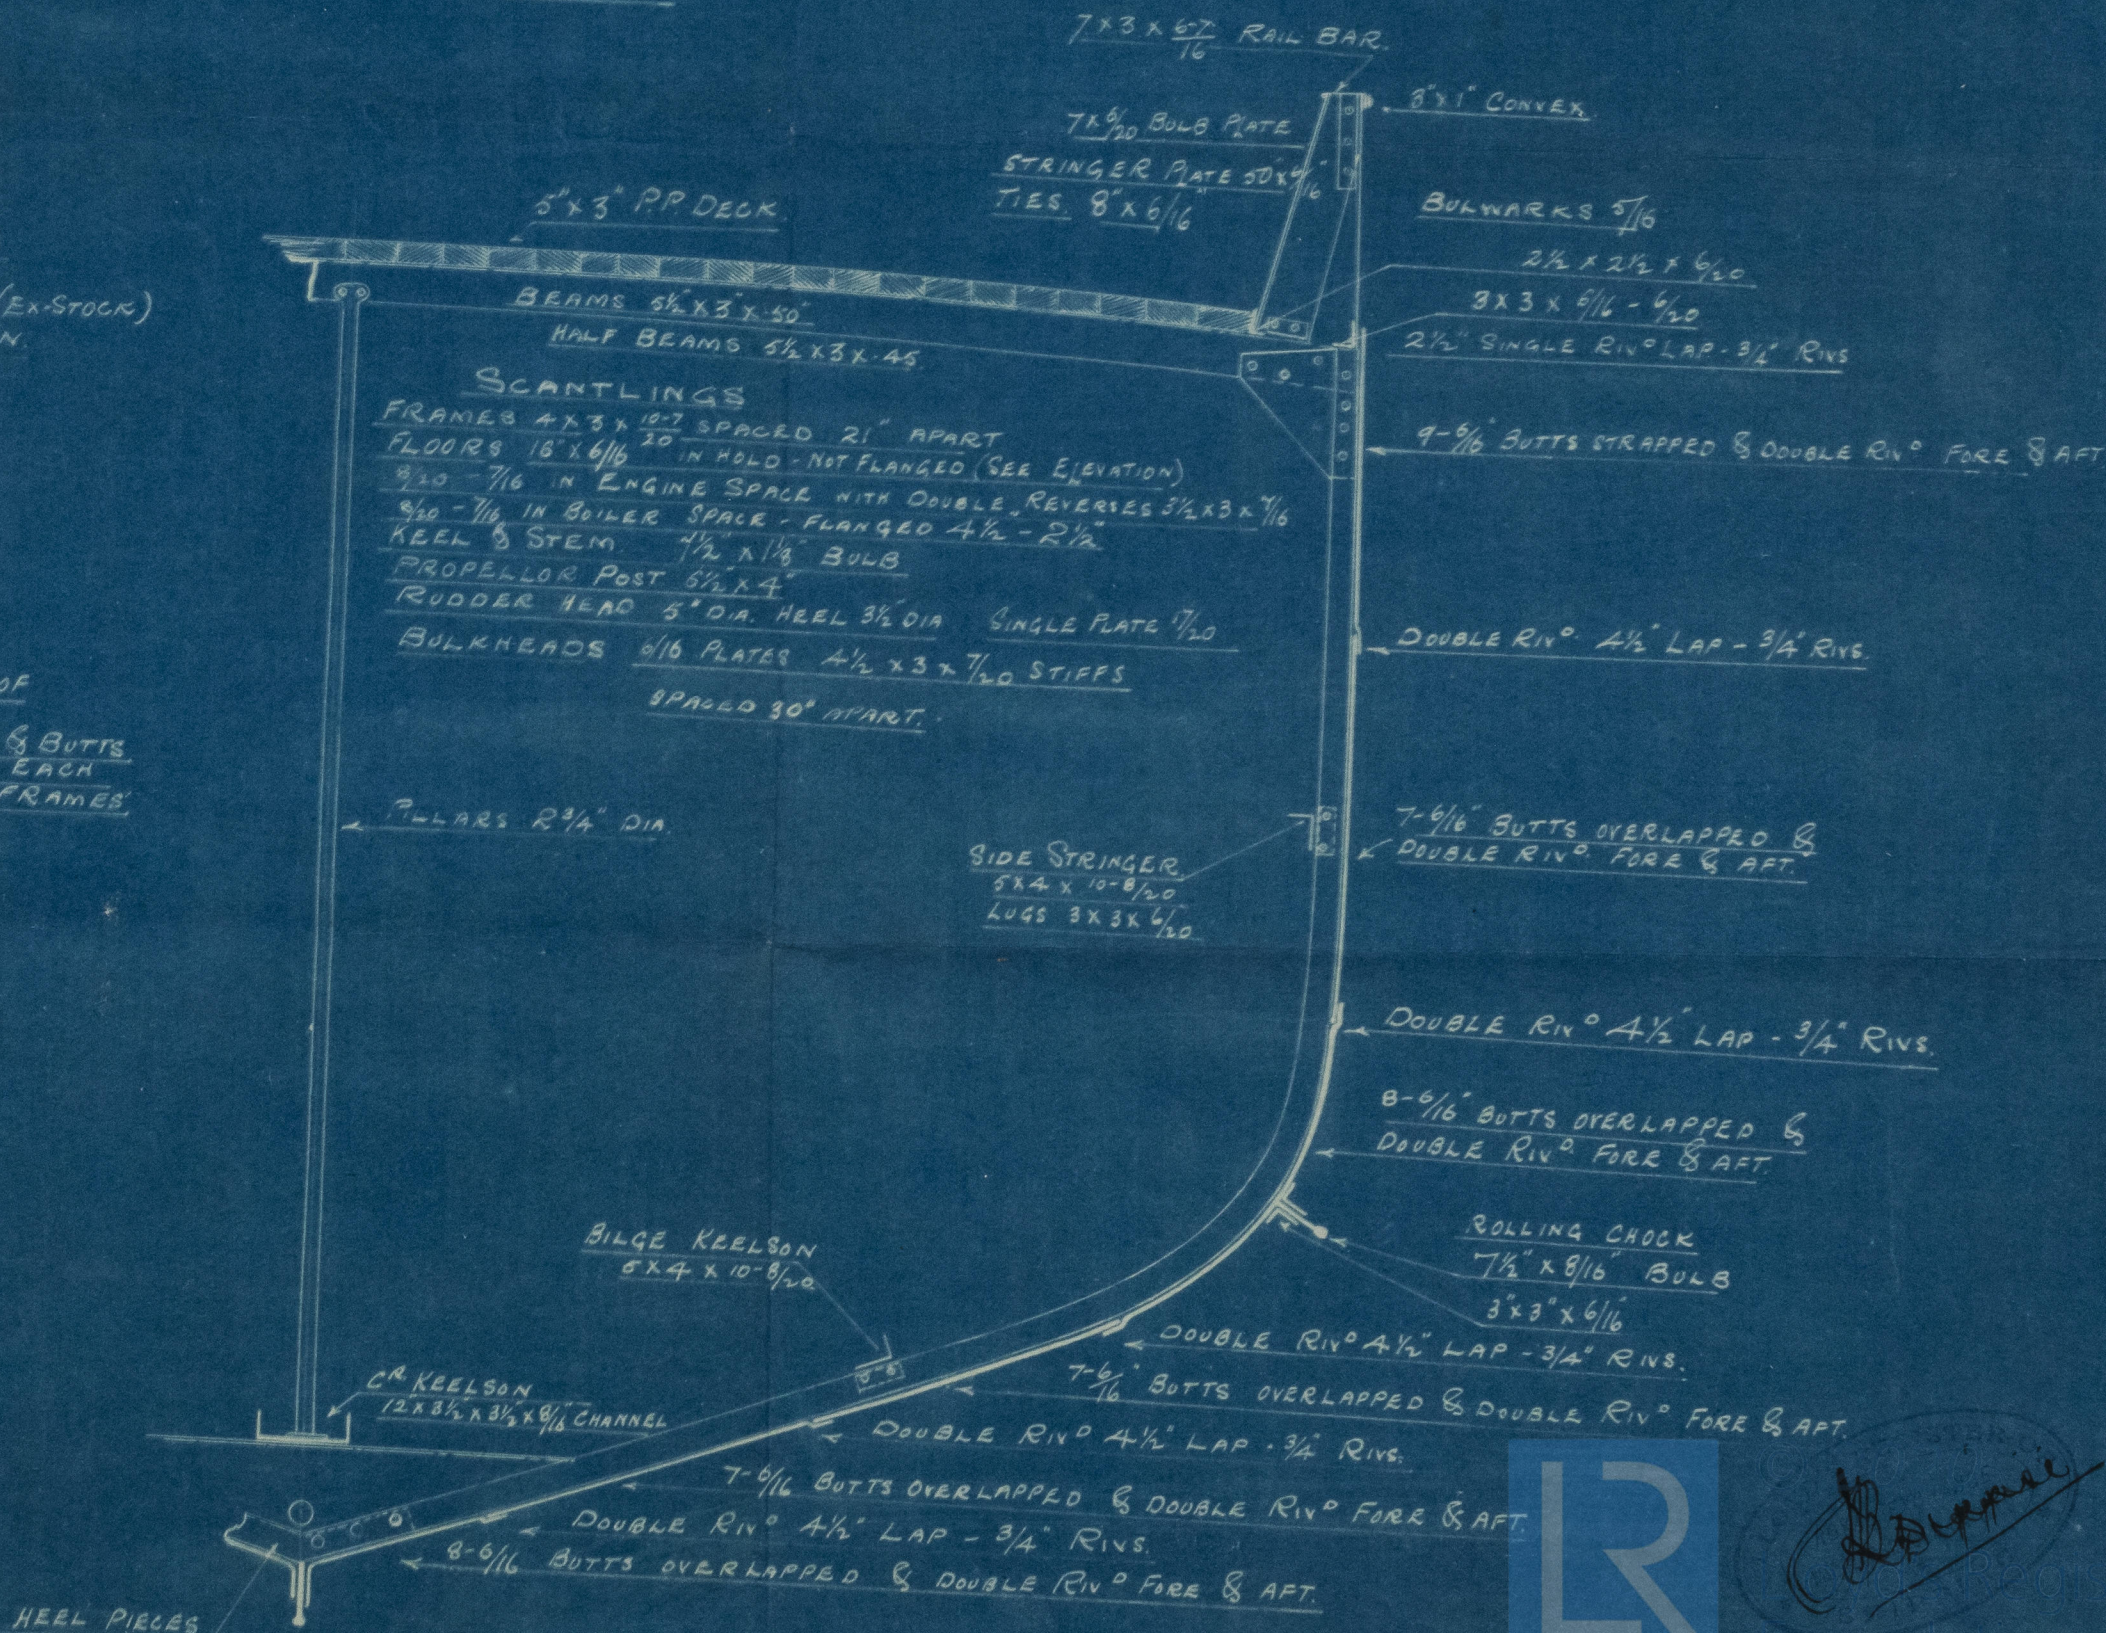

Smiths No 470
S.S. "NANCY HAGUE"

MIDSHIP SECTION

as built

Mar. Rpt. No. 1859



© 2020

Lloyd's Register
Foundation

008900-008908-0330