


	POOP	F ^C SL.
SIDE PLATING	.36"	.38"
STRINGER PLATE	32" x .32"	32 x .32"
" ANGLE	3" x 3" x .32	3" x 3" x .32"
DECK PLATING	.25"	.30"
BEAMS	Y 3" x .36 BA	8 x 3" x .44 BA
BEAM KNEES	20" x .40"	20" x .40"
PILLARS	2 3/4	2 3/4"

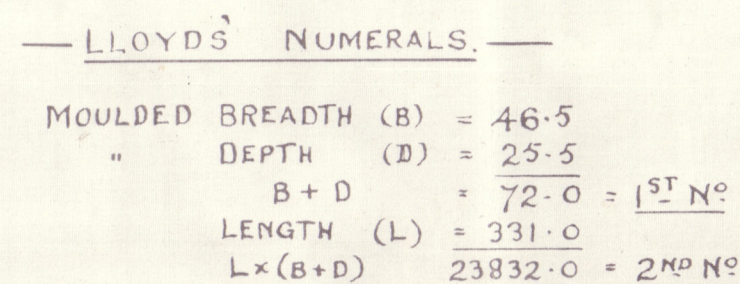

— PROPORTIONS. —

LENGTHS TO DEPTH U.D. = 12.98
d WITH INCREASED BRACKETS = 21.75

SHEER FOR $D = 8'-6"$ $\frac{1}{8}$ LEN. FOR $D = 4'-8"$
AFT 4-3 $\frac{1}{8}$ " AFT = 2-4

— EQUIPMENT NUMERALS. —

$L \times (8+D)$
 $= 331 \times (46.5 + 25.5) = 23832.00$

ERECTIONS:-


POOP	32.92
BRIDGE	98.00
F'CLE	<u>28.58</u>
	$159.50 \times 7.5 \times 75 = 897.19$

CASINGS & HOUSES.
ENGINE CASING $29.46 \times 7 \times .5 = 103.11$
SALOON HOUSE $26.54 \times 7.5 \times .75 = 149.29$ 252.40

EQUIPMENT NO = 24981-59

EQUIPMENT.			
2	BOWER ANCHORS	STOCKLESS	45 CWTs
1	"	"	38 "
1	STREAM ANCHOR	EX. STOCK	12 "
1	KEDGE	"	5 1/2 "
270	FATHOMS	1 1/2" STUD CHAIN	CABLE
90	"	4 1/2" STEEL WIRE	STREAM
100	"	4" STEEL WIRE	TOWLINE

1-90 FMS	7	MANILLA HAWSER	&	1. 90 FMS	2 1/2	STEEL WIRE
1 "	6	"	&	1. 90	2 1/4	"

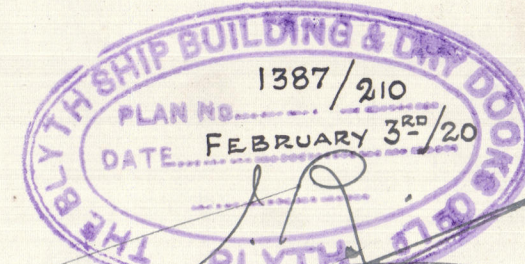

Mem Rptd PB 10012
No 210

Benth 210

DAYBREAK N/V

Mishup Akohu
Lutia nam

as built.

1st July Rptd No 72703

Transferred &

Woosung nam

in Sunmace

Dec Sec
202



© 2020

Lloyd's Register
Foundation