

"EMPIRE BARKIS" SHIP No. 639.



STEEL SINGLE SCREW MOTOR TANKER.

GENERAL ARRANGEMENT



DIMS ~ 152'-0" OA x 141'-6" BP x 23'-6" MLD x 9'-3" MLD

CLASS LLOYDS REG: \* 100 A.1

SCALE = 1/4" = 1 FOOT

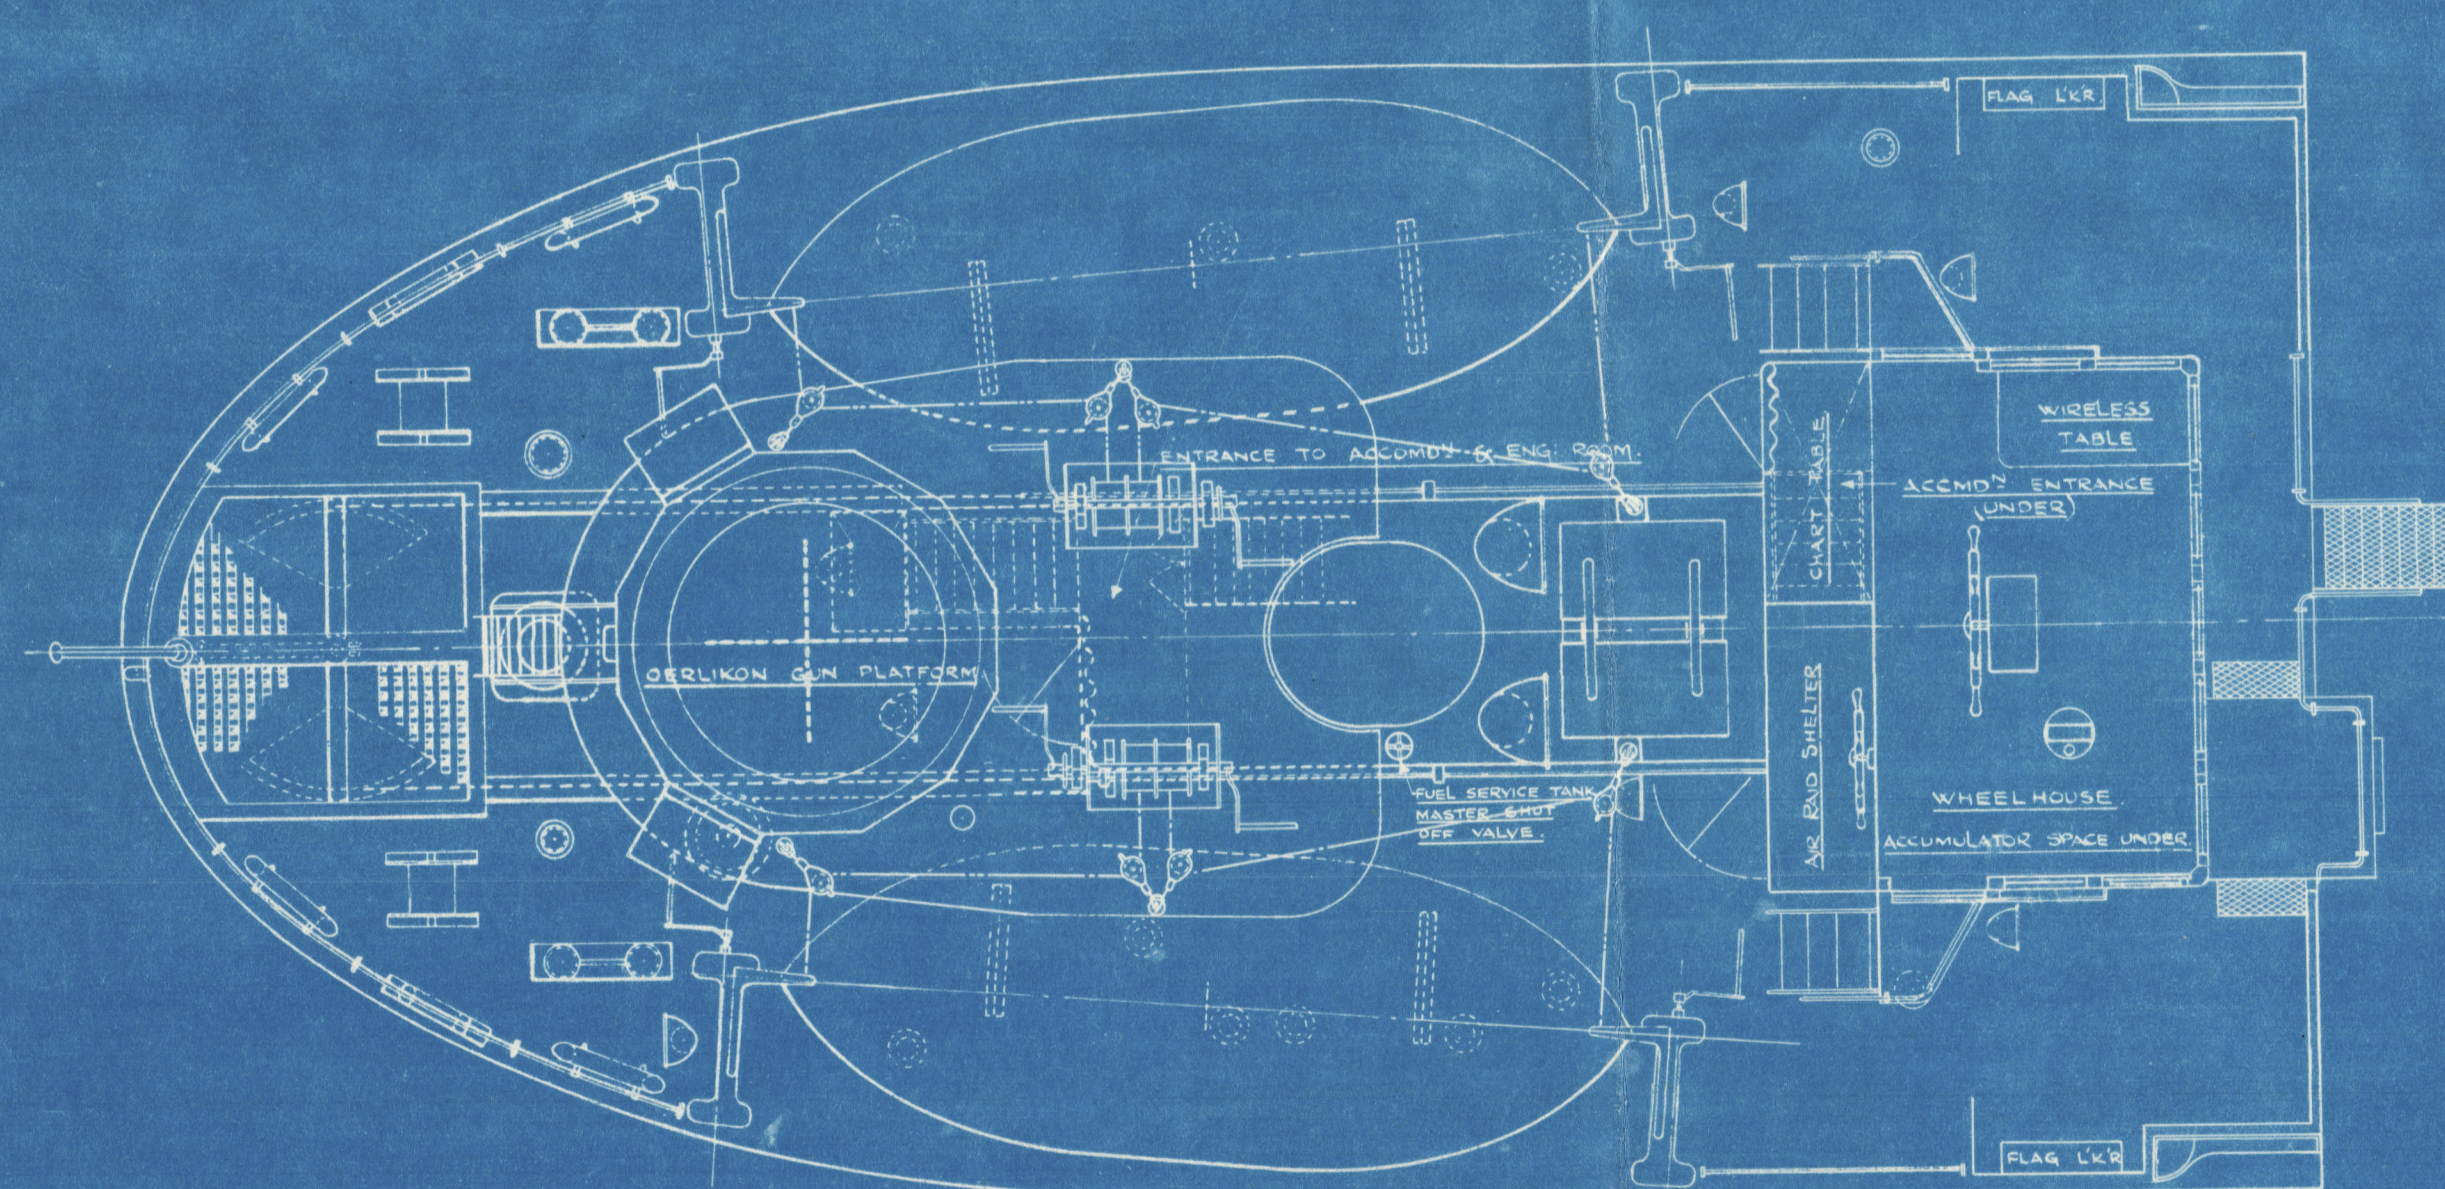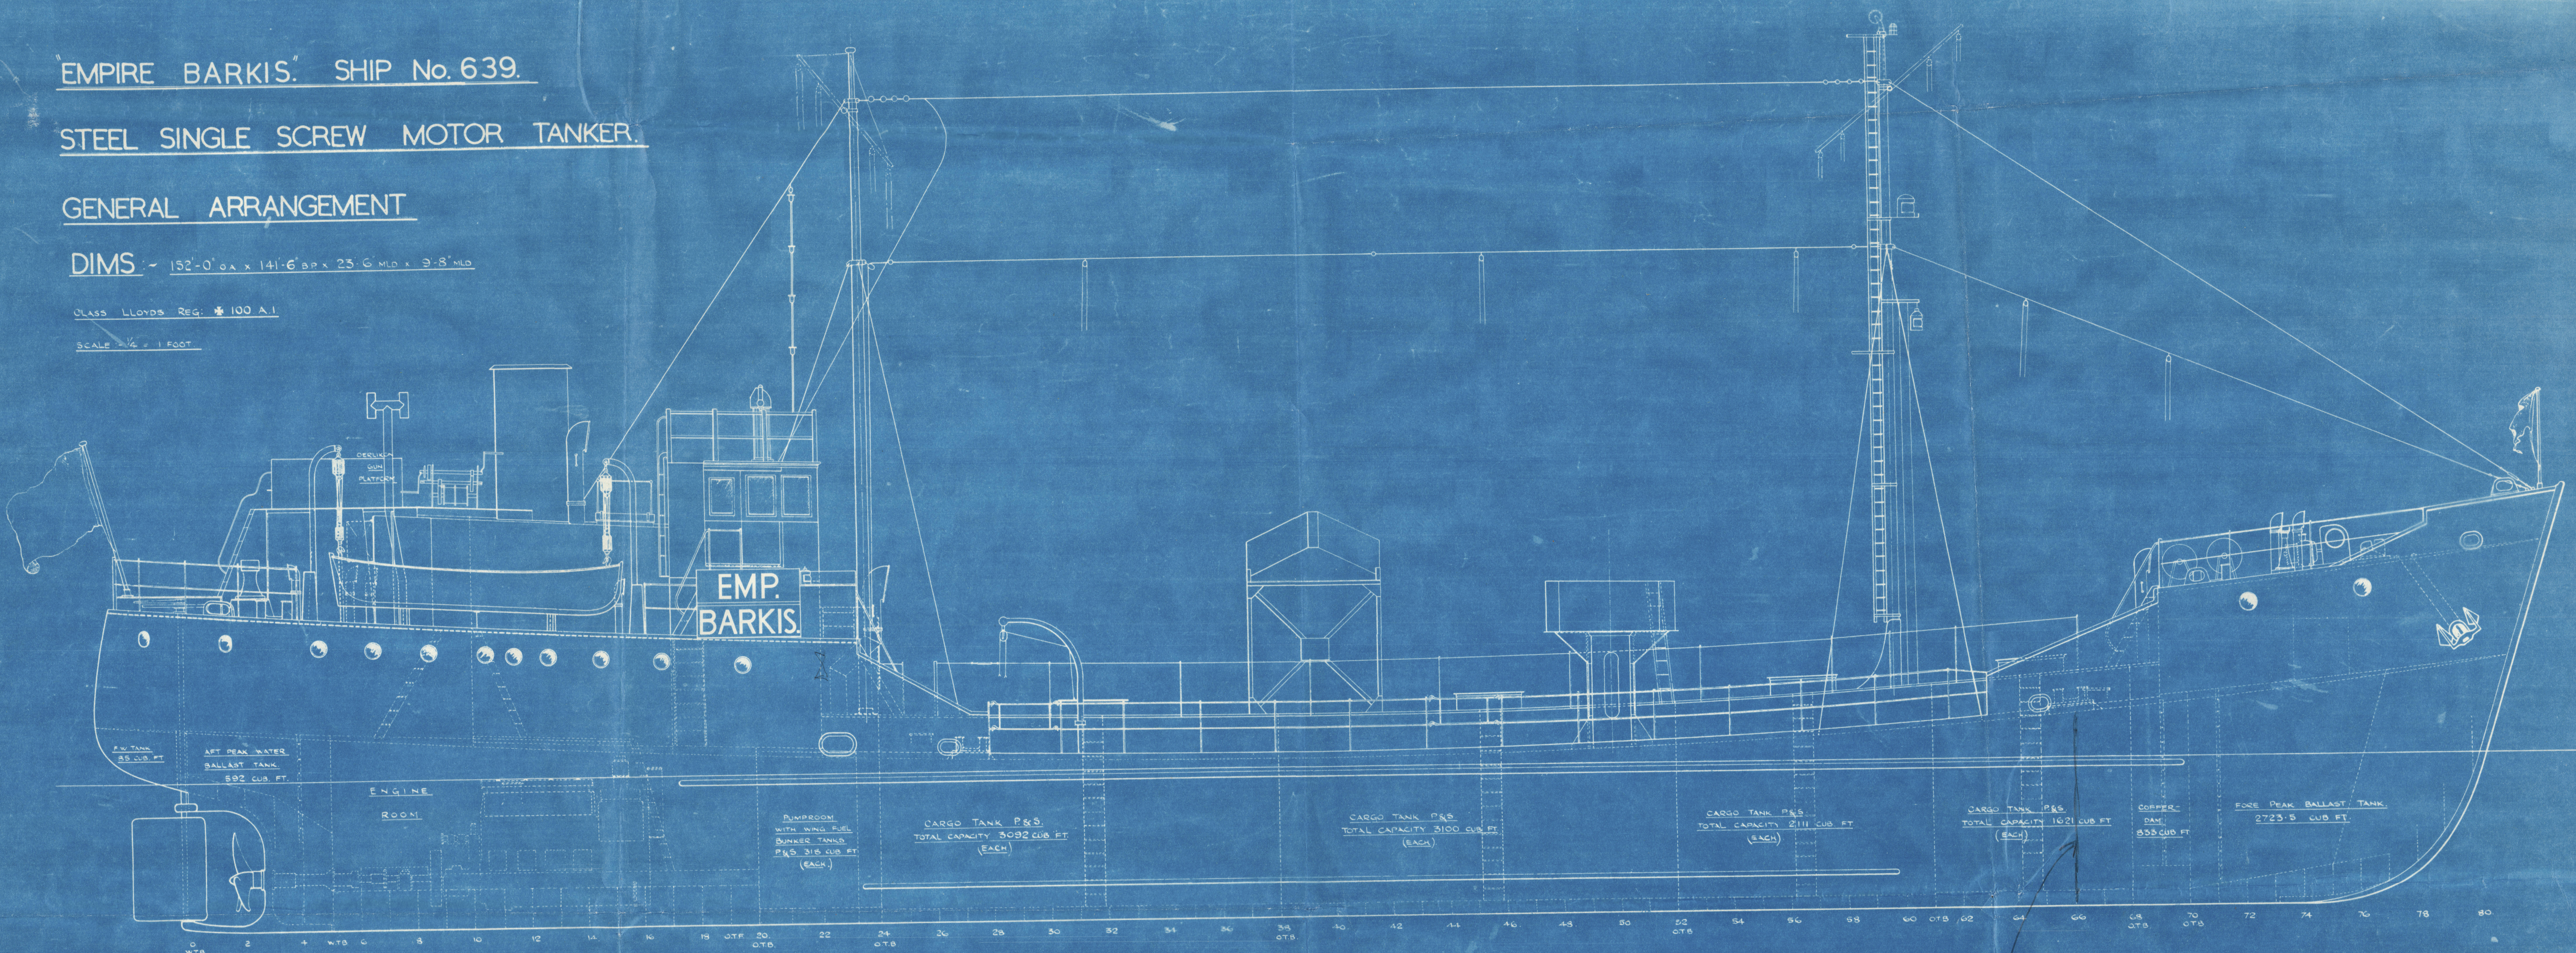

Additional Bldg (OT)  
Fitted on 2-66.  
(See Memo. Rph. 102846 S.48)

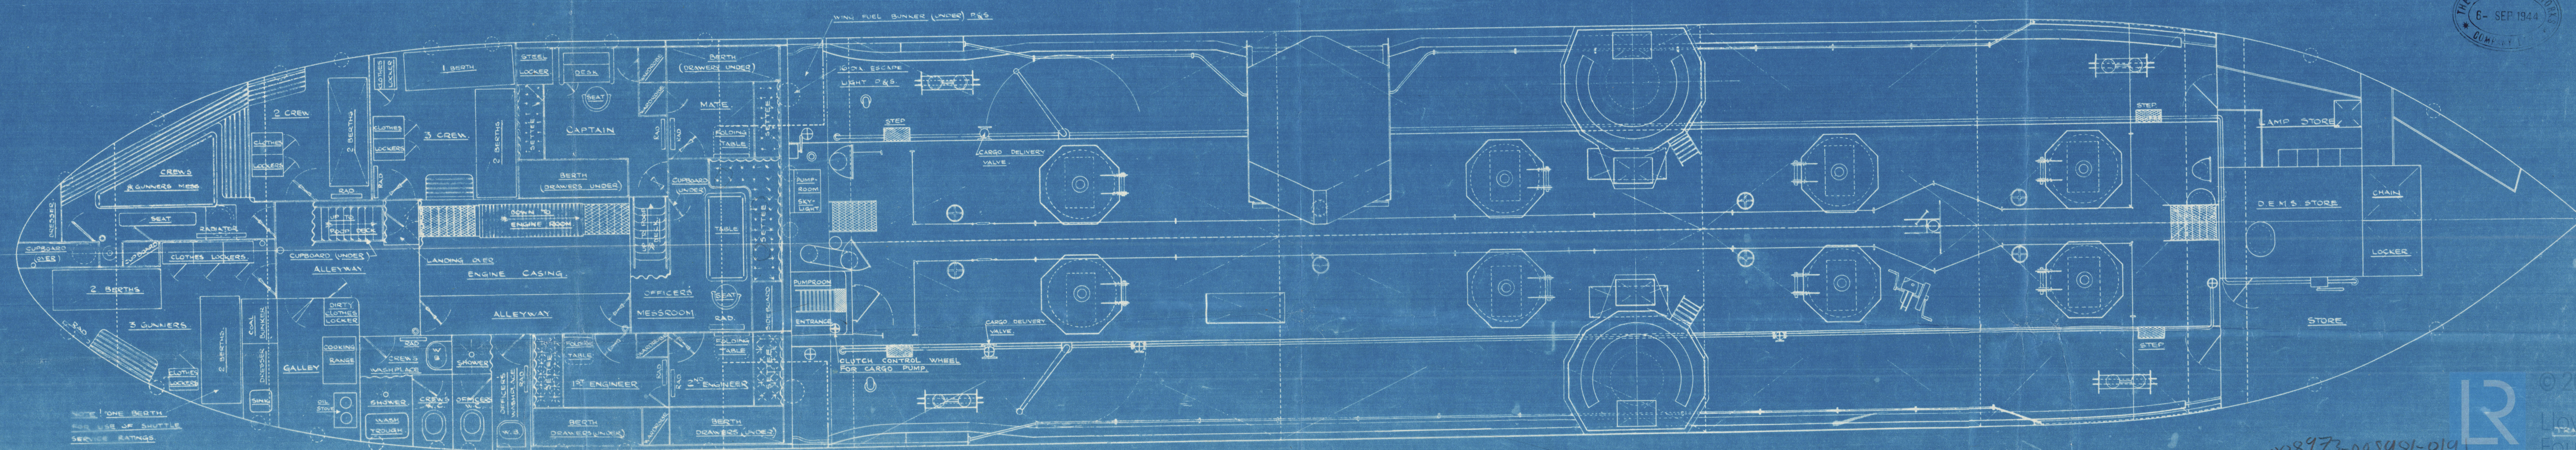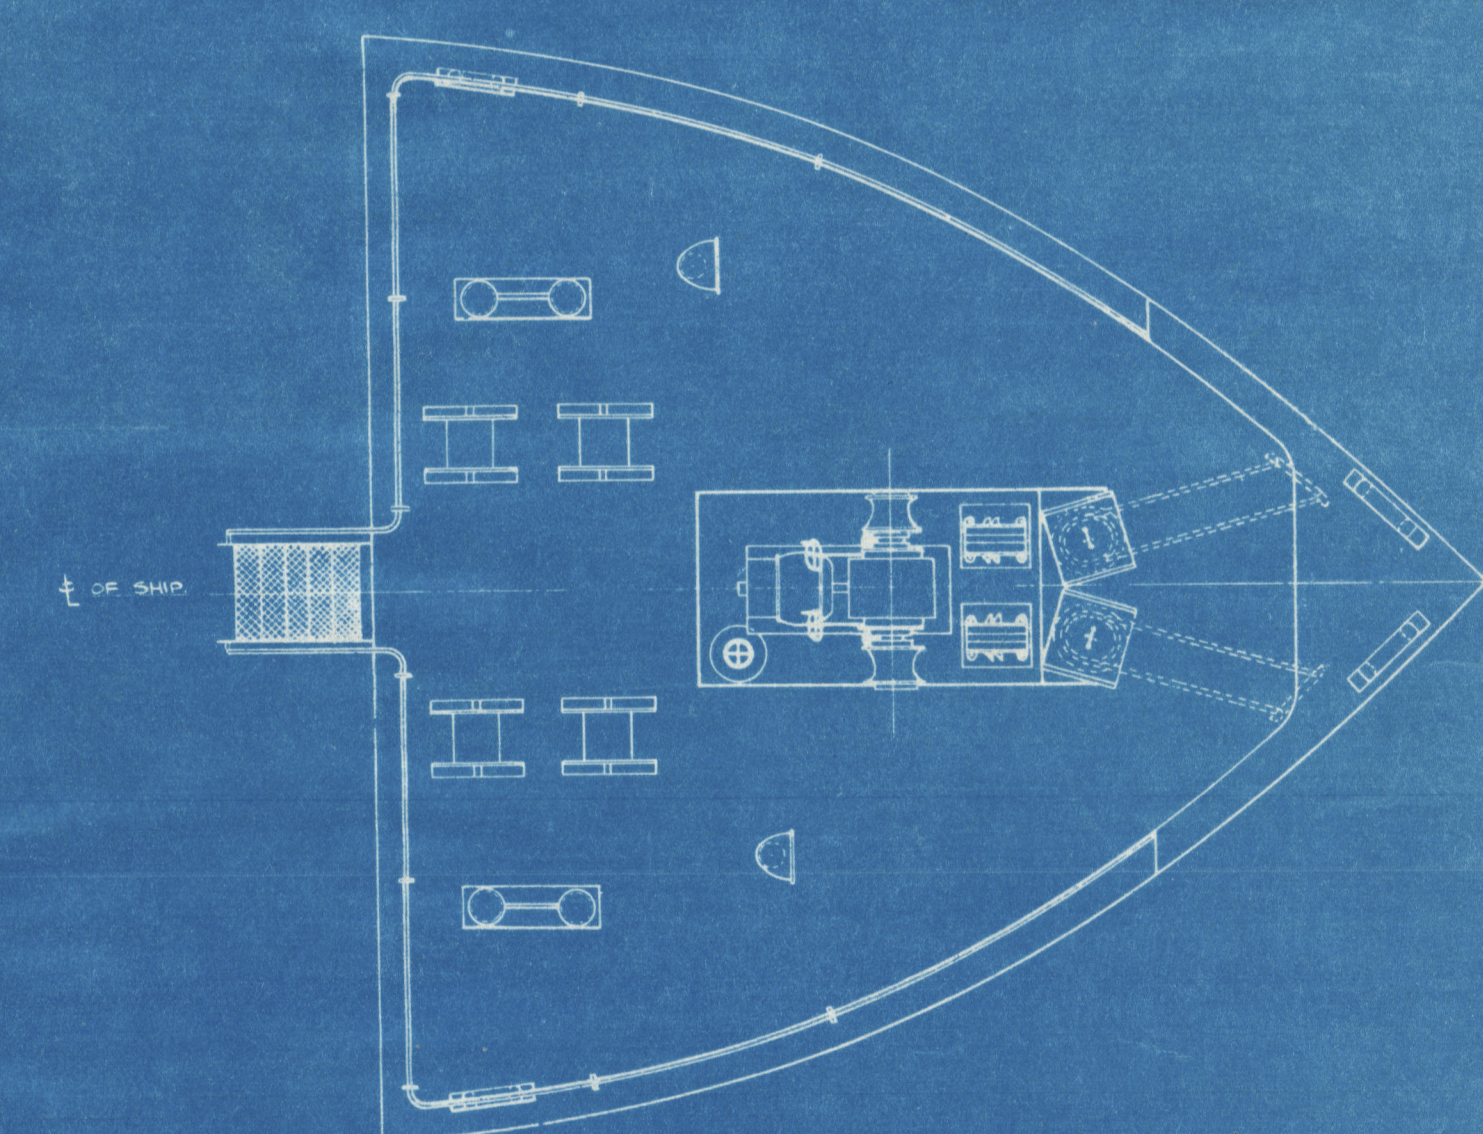


The Howdage Ironworks & Co  
Yard No 639.

General Arrangement.

As Built.

M/V "Empire Barkis"  
"GONFOR"

London Report No. 112116

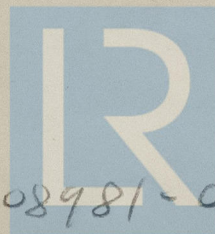

© 2021

Lloyd's Register  
Foundation

008973-008981-0191