


DOUBLERS MADE PREVIOUSLY MARKED THUS
TEST HOLE READINGS SHOWN IN TWENTIETHS OF AN INCH
PLATES RENEWED IN FEB. 1960 MARKED IN RED

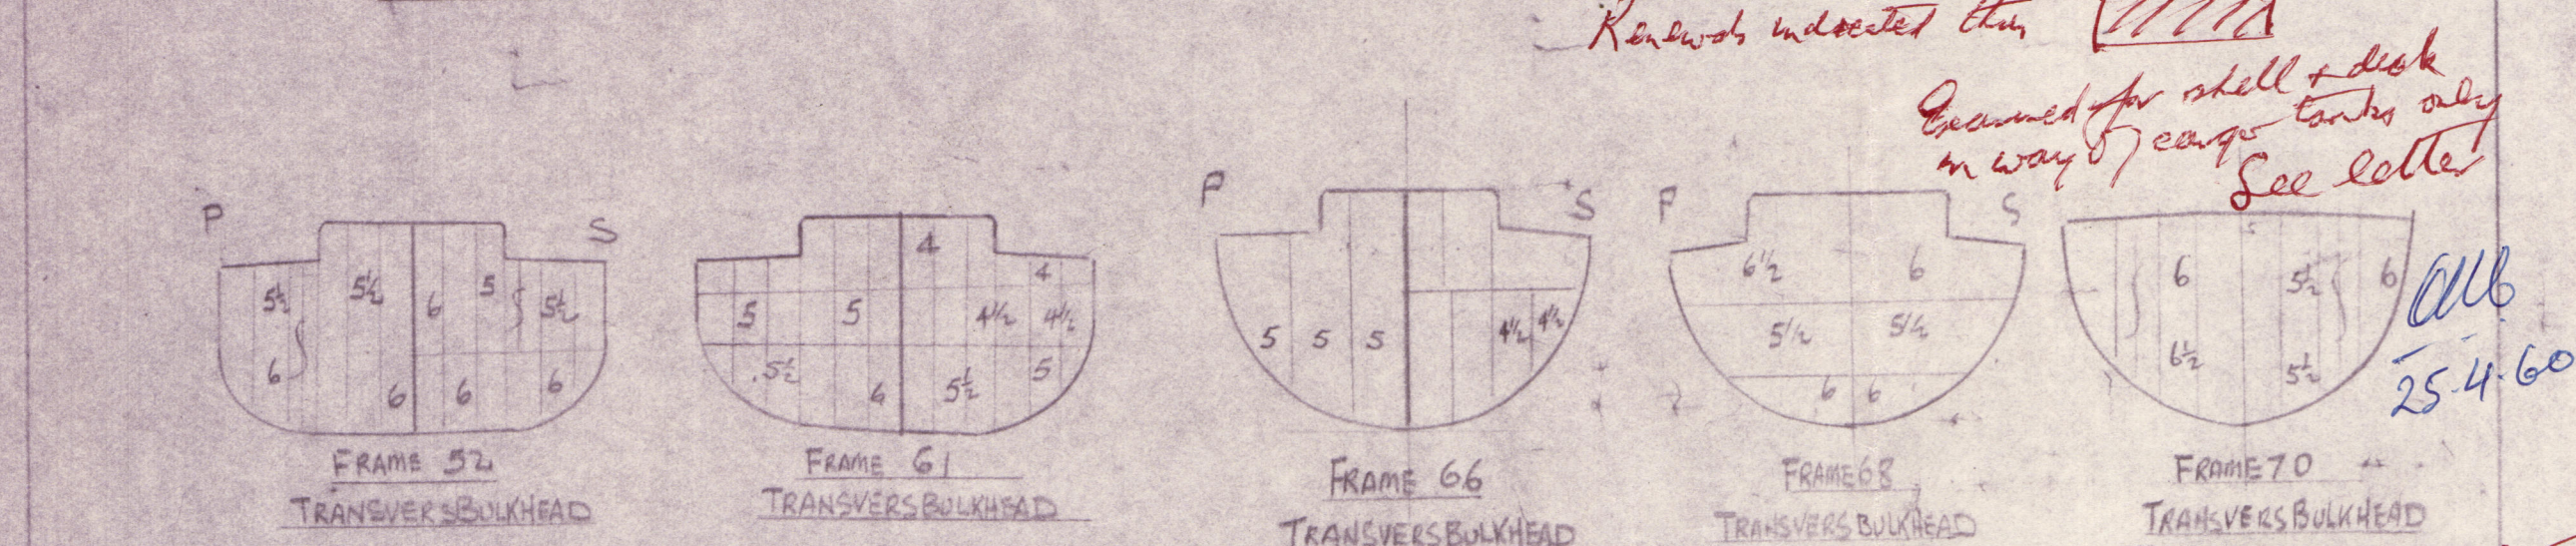

D = DOUBLE MADE IN FEB. 60

OFFICE

	FRAME NO	TRUNK DECK BEAM	TANK DECK BEAM	TRUNK COAMING	CENTRE LINE BULKHEAD	CENTRE LINE BULKHEAD	MAIN DECK BEAM	BEAM BRKT ATTACHED TO CENTRAL BHD	BEAM KNEE	FRAME	BILGE BRACKET	FLOOR	INTERCOASTAL PLATE
		PORT STARBOARD	PORT STARBOARD	PORT STARBOARD	PORT STARBOARD	PORT STARBOARD	PORT STARBOARD	PORT STARBOARD	PORT STARBOARD	PORT STARBOARD	PORT STARBOARD	PORT STARBOARD	PORT STARBOARD
NO 1 TANK	66	BHD	BHD	BHD	BHD	BHD	BHD	BHD	BHD	BHD	BHD	BHD	BHD
	65	7	6	6	4	3	6	7	6	7	6	6	5
	64	7	7	7	2	6	7	6	7	6	7	6	6
	63	6	6	6	3	6	7	6	7	6	7	6	5
	62	6	7	6	3	6	7	6	7	6	7	6	5
	61	TRANSVERSE BULKHEAD											
NO 2 TANK	60	6	8	3	NEW	4	3 1/2	7	6	6	6	5	4
	59	5	6	5	NEW	5	5	7	6	6	6	5 1/2	4
	58	5	6	4	NEW	4	4	6	6	6	6	5 1/2	4
	57	4	7	4	NEW	4	8	7	7	6	6	5 1/2	4
	56	3	3 1/2	8	NEW	3	6	5	7	6	6	5	4
	55	2	7	4	NEW	6	5	4	7	6	6	5	3 1/2
NO 3 TANK	54	6	7	3	NEW	4	4	7	7	6	6	5	4
	53	7	7	4	NEW	5	6	7	7	6	6	5 1/2	4
	52	TRANSVERSE BULKHEAD											
	51	6	7	5	NEW	4	3 1/2	6	6	5	5	5 1/2	4
	50	6	7	5 1/2	NEW	4	3 1/2	5 1/2	5	5	5	4 1/2	4
	49	5	6	5	4	3 1/2	6	6	5	5	5	4	4
NO 4 TANK	48	7	6	5	3 1/2	4	3	5 1/2	5	4 1/2	4	4	4
	47	7	6	5	4	3	5 1/2	5	4 1/2	4	4	4	4
	46	6	6	4	3 1/2	4	5 1/2	5 1/2	6	4	4	4	4
	45	7	7	4	4	3	5	5	6	4	4	4	4
	44	7	4	4 1/2	3 1/2	4	5	5 1/2	4 1/2	5	5	5	5
	43	2	6	5	3 1/2	4	5	5	5	5	5	5	5
NO 5 TANK	42	6	7	4 1/2	3 1/2	4	5	5	5	5	5	5	5
	41	6	6	5	3 1/2	4	5	5 1/2	6	6	6	5	4
	40	4	4	5	3 1/2	4	6	6	6	6	6	5	4
	39	4	5	4	NEW	3 1/2	4 1/2	6	6	6	6	5 1/2	4
	38	TRANSVERSE BULKHEAD											
	37	7	7	8	7	5	8	7	6	6	6	5 1/2	4
NO 6 TANK	36	7	7	8	7	4	8	6	6	6	6	5 1/2	4
	35	7	7	7	6	4	8	6	6	6	6	5 1/2	4
	34	7	7	7	6	4	8	6	6	6	6	5 1/2	4
	33	7	7	7	6	5	8	6	6	6	6	5 1/2	4
	32	4	4	8	6	5 1/2	8	6	6	6	6	5 1/2	4
	31	5	5	8	6	5 1/2	8	6	6	6	6	5 1/2	4
NO 7 TANK	30	5	6	8	6	5 1/2	8	6	6	6	6	5 1/2	4
	29	6	7	8	6	3	7	7	6	6	6	5 1/2	4
	28	7	7	8	6	3	7	7	6	6	6	5 1/2	4
	27	3	7	8	6	3	8	6	6	6	6	5 1/2	4
	26	7	7	8	6	3	8	6	6	6	6	5 1/2	4
	25	7	7	8	7	3	8	6	6	6	6	5 1/2	4
NO 8 TANK	24	TRANSVERSE BULKHEAD											
	23	7	7	8	7	3	8	6	6	6	6	5 1/2	4
	22	7	7	8	7	3	8	6	6	6	6	5 1/2	4
	21	7	7	8	7	3	8	6	6	6	6	5 1/2	4
	20	7	7	8	7	3	8	6	6	6	6	5 1/2	4
	19	7	7	8	7	3	8	6	6	6	6	5 1/2	4

	PILLAR BAR INWAY OF HATCH	PILLAR BAR FOOT BRKT
	PORT STARBOARD	PORT STARBOARD
NO 1 TANK	6	3
NO 2 TANK	8	8
NO 3 TANK	4	7
NO 4 TANK	6	7

	PORT	STARBOARD
NO 1 TANK	7 6 7 6 6	7 7 8 7 7
NO 2 TANK	6 5 6 7 7	7 7 6 7 6
NO 3 TANK	6 6 6 7 7	7 7 6 7 6
NO 4 TANK	7 7 7 7 7	5 5 8 8 8
NO 5 TANK	7 7 7 6 7	6 6 6 6 7
NO 6 TANK	7 7 7 7 7	7 8 7 7 8

	PORT	STARBOARD
NO 7 TANK	8 8 8 8 8	6 6 8 8 8
NO 8 TANK	5 5 5 6 5	5 5 5 5 5
NO 9 TANK	6 6 6 6 7	6 6 6 6 6
NO 10 TANK	3 3 4 6 6	7 7 8 8 8
NO 11 TANK	6 6 6 6 7	4 4 4 4 4
NO 12 TANK	6 6 7 7 7	7 7 7 6 5

OFFICE

SINGAPORE SLIPWAY & ENG. CO., LTD.

DATE 29-2-60

SHIP M.V. GUNTER

JOB No.

DRAWN BY J. H. H.

PASSED

ISSUED TO

Lloyd's Found

OFFICE

SINGAPORE SLIPWAY & ENG. CO.

DATE	29-2-60
------	---------

SHIP
M.V. GUNTER 202

JOB No.

DRAWN BY *J. H. H.*

PASSED

ISSUED TO [redacted] FOUNDATION

Lloyd's Register
Foundation

008973-008981-0224

SS/MS " <i>Gunter</i> "	
TO ACCOMPANY... <i>Ing</i>	Rpt. No. <i>13876</i>
Dated <i>3.60</i>	
SUBJECT:- <i>Drillings of shell, deck & internal structure.</i>	

008973 008981-0224



© 2021

Lloyd's Register
Foundation