


S. S. "SAGA MARU" (NO 58).

PROFILE, DECK & INNER BOTTOM PLANS.

SCALE 1/8" = 1'-0"

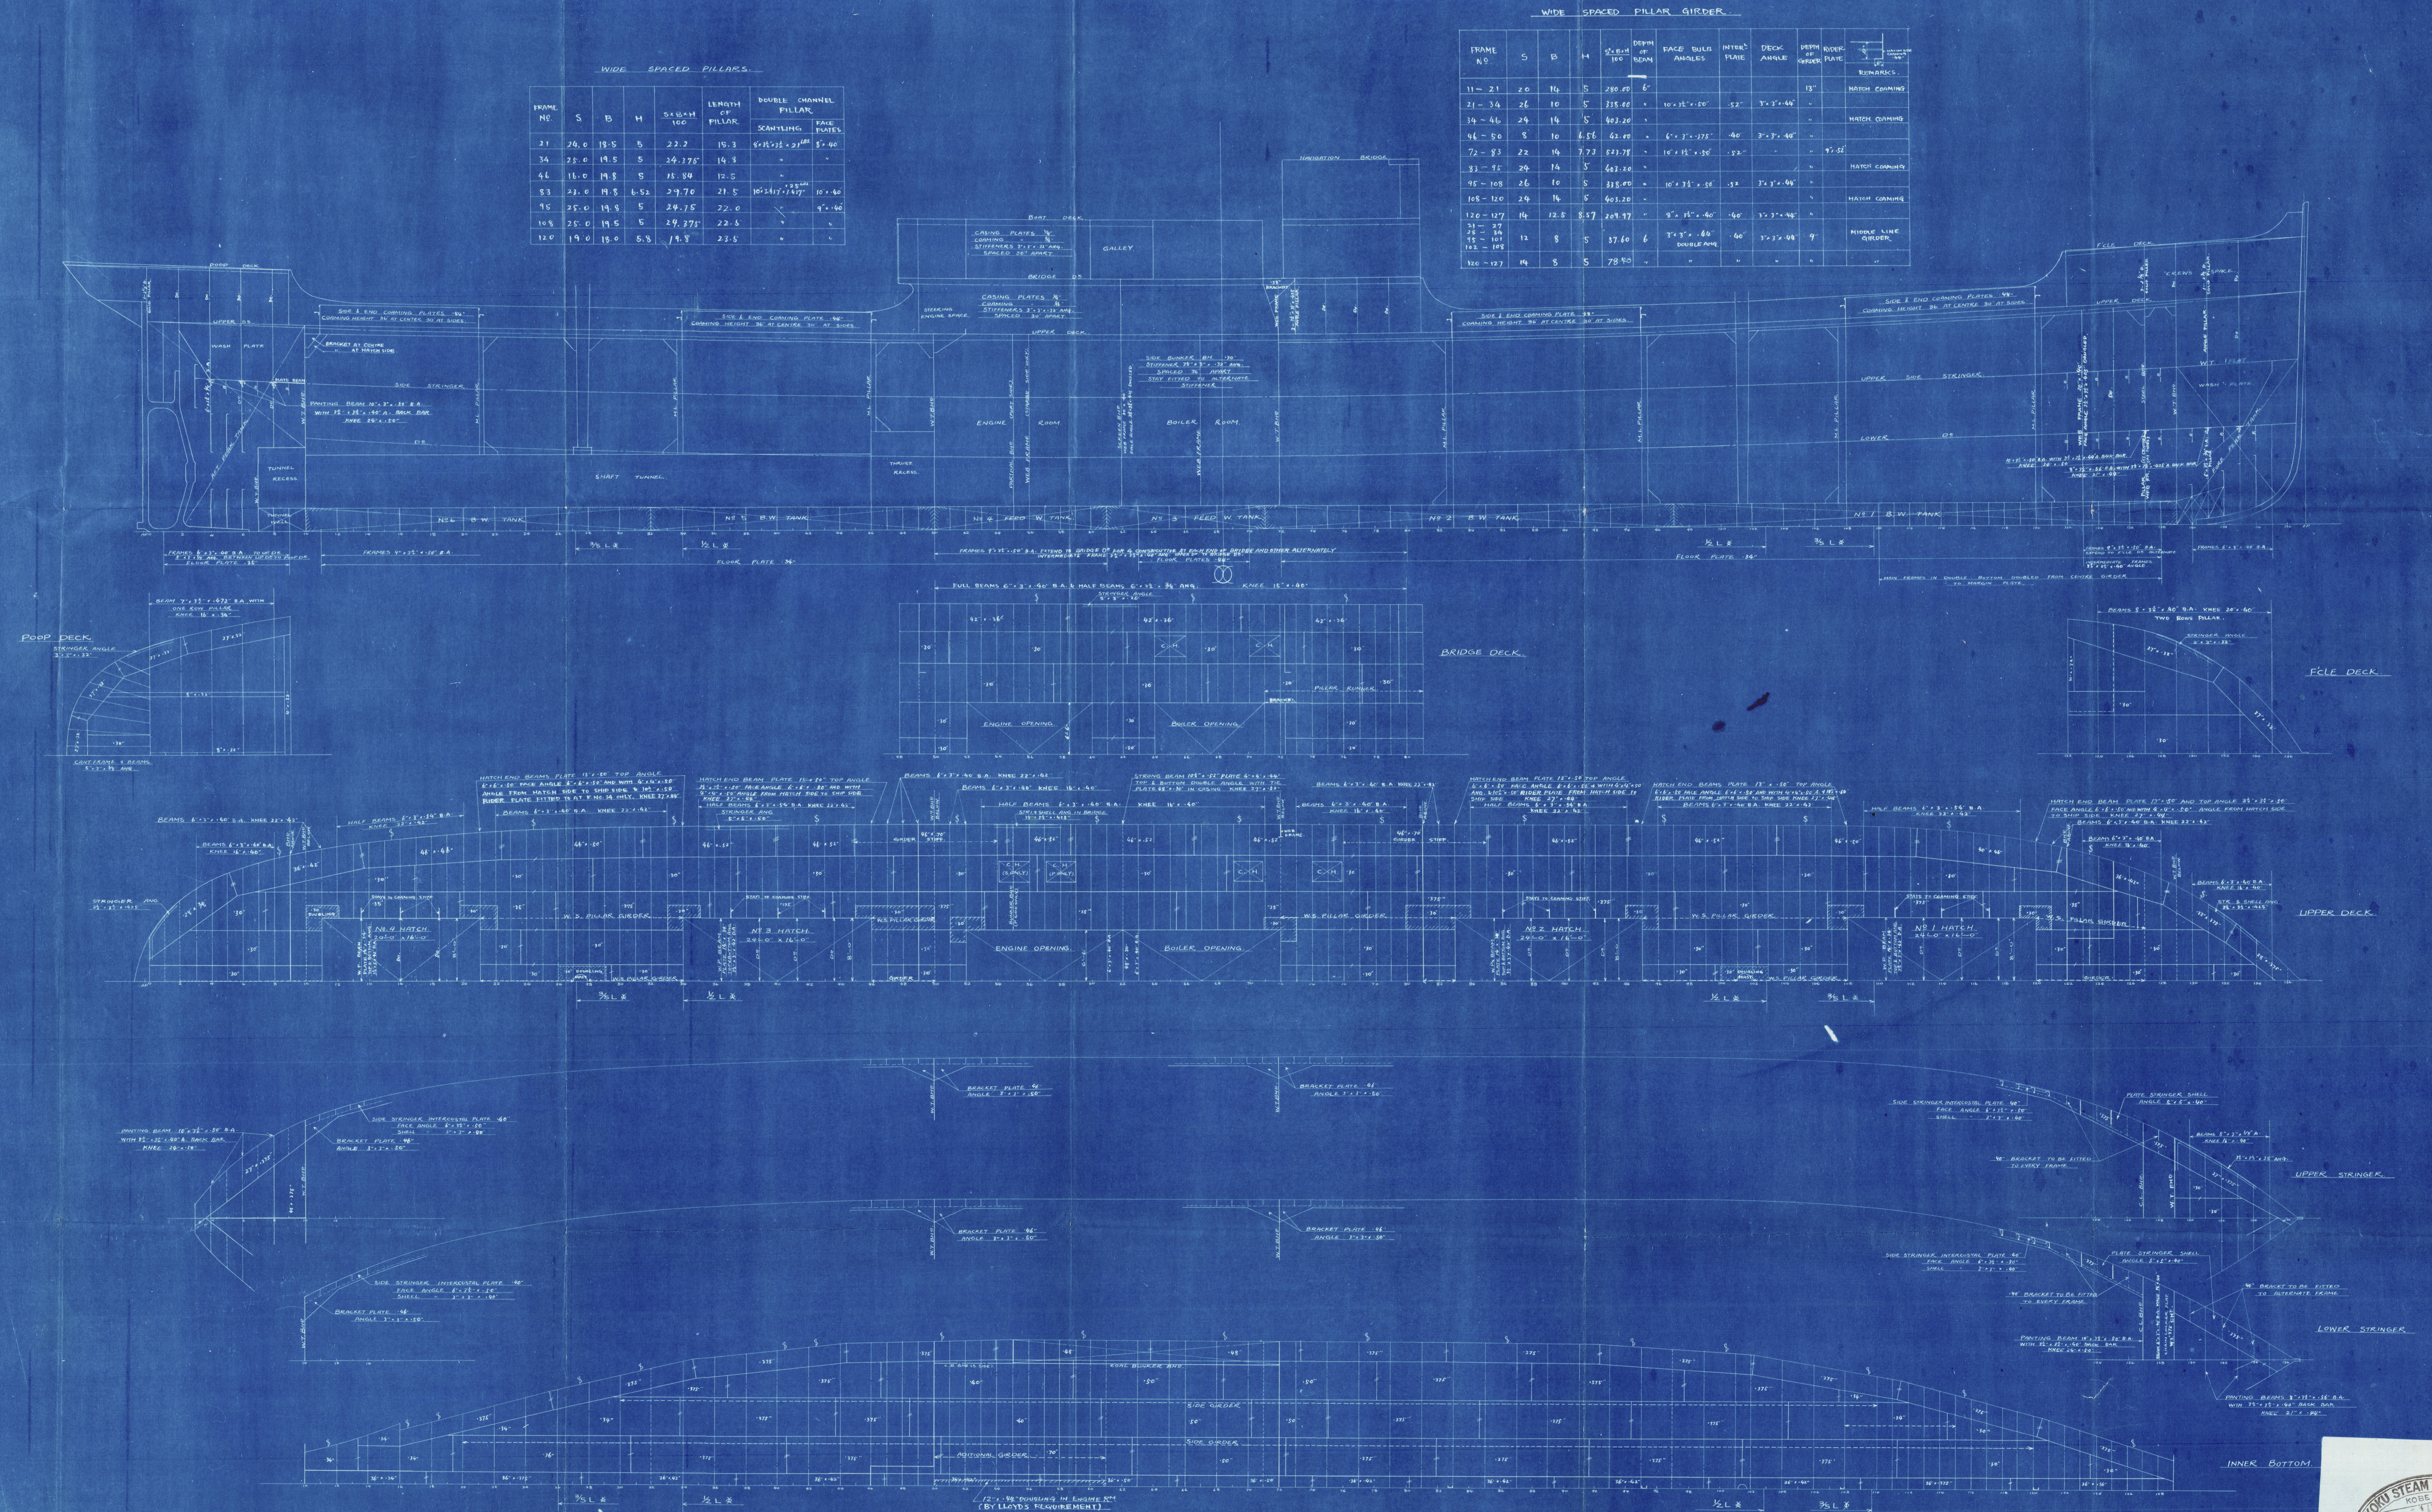

— 5.5. "SAGA MARU" —

Profile and Deck Plans
of vessel as built

Tokoku Fels's Toba Dockyard
Hull No 58.

Kobe: Japan
Report No 2701.



© 2020

Lloyd's Register
Foundation

000001-000002-0204

S/S "SAGA MARU"

CONSTRUCTION PROFILE
AND DECK

FINISHED



© 2020

Lloyd's Register
Foundation

89897-00003-0204