

S.S. "CITÉ DE LÉVIS"

S.S. "CITÉ DE QUÉBEC"

MIDSHIP SECTION.

SCALE :- $\frac{3}{8}" = 1 \text{ FOOT.}$

FERRY STEAMERS.


CLASSED 100A. AT LLOYDS FOR FERRY SERVICE BETWEEN QUEBEC & LEVIS.

LENGTH B.P. 144'-0"
BREADTH MOULDED. 50'-0"
DEPTH MOULDED. 18'-0"




EQUIPMENT.

1 STOCKLESS ANCHOR 9 CWTs.
1 STOCKLESS ANCHOR (SPARE) 9 CWTs.
30 FATHOMS 1" STUD LINK GABLE.
4 LENGTHS - 6" GIRD. MANILLA, 7 FATHOMS EACH.

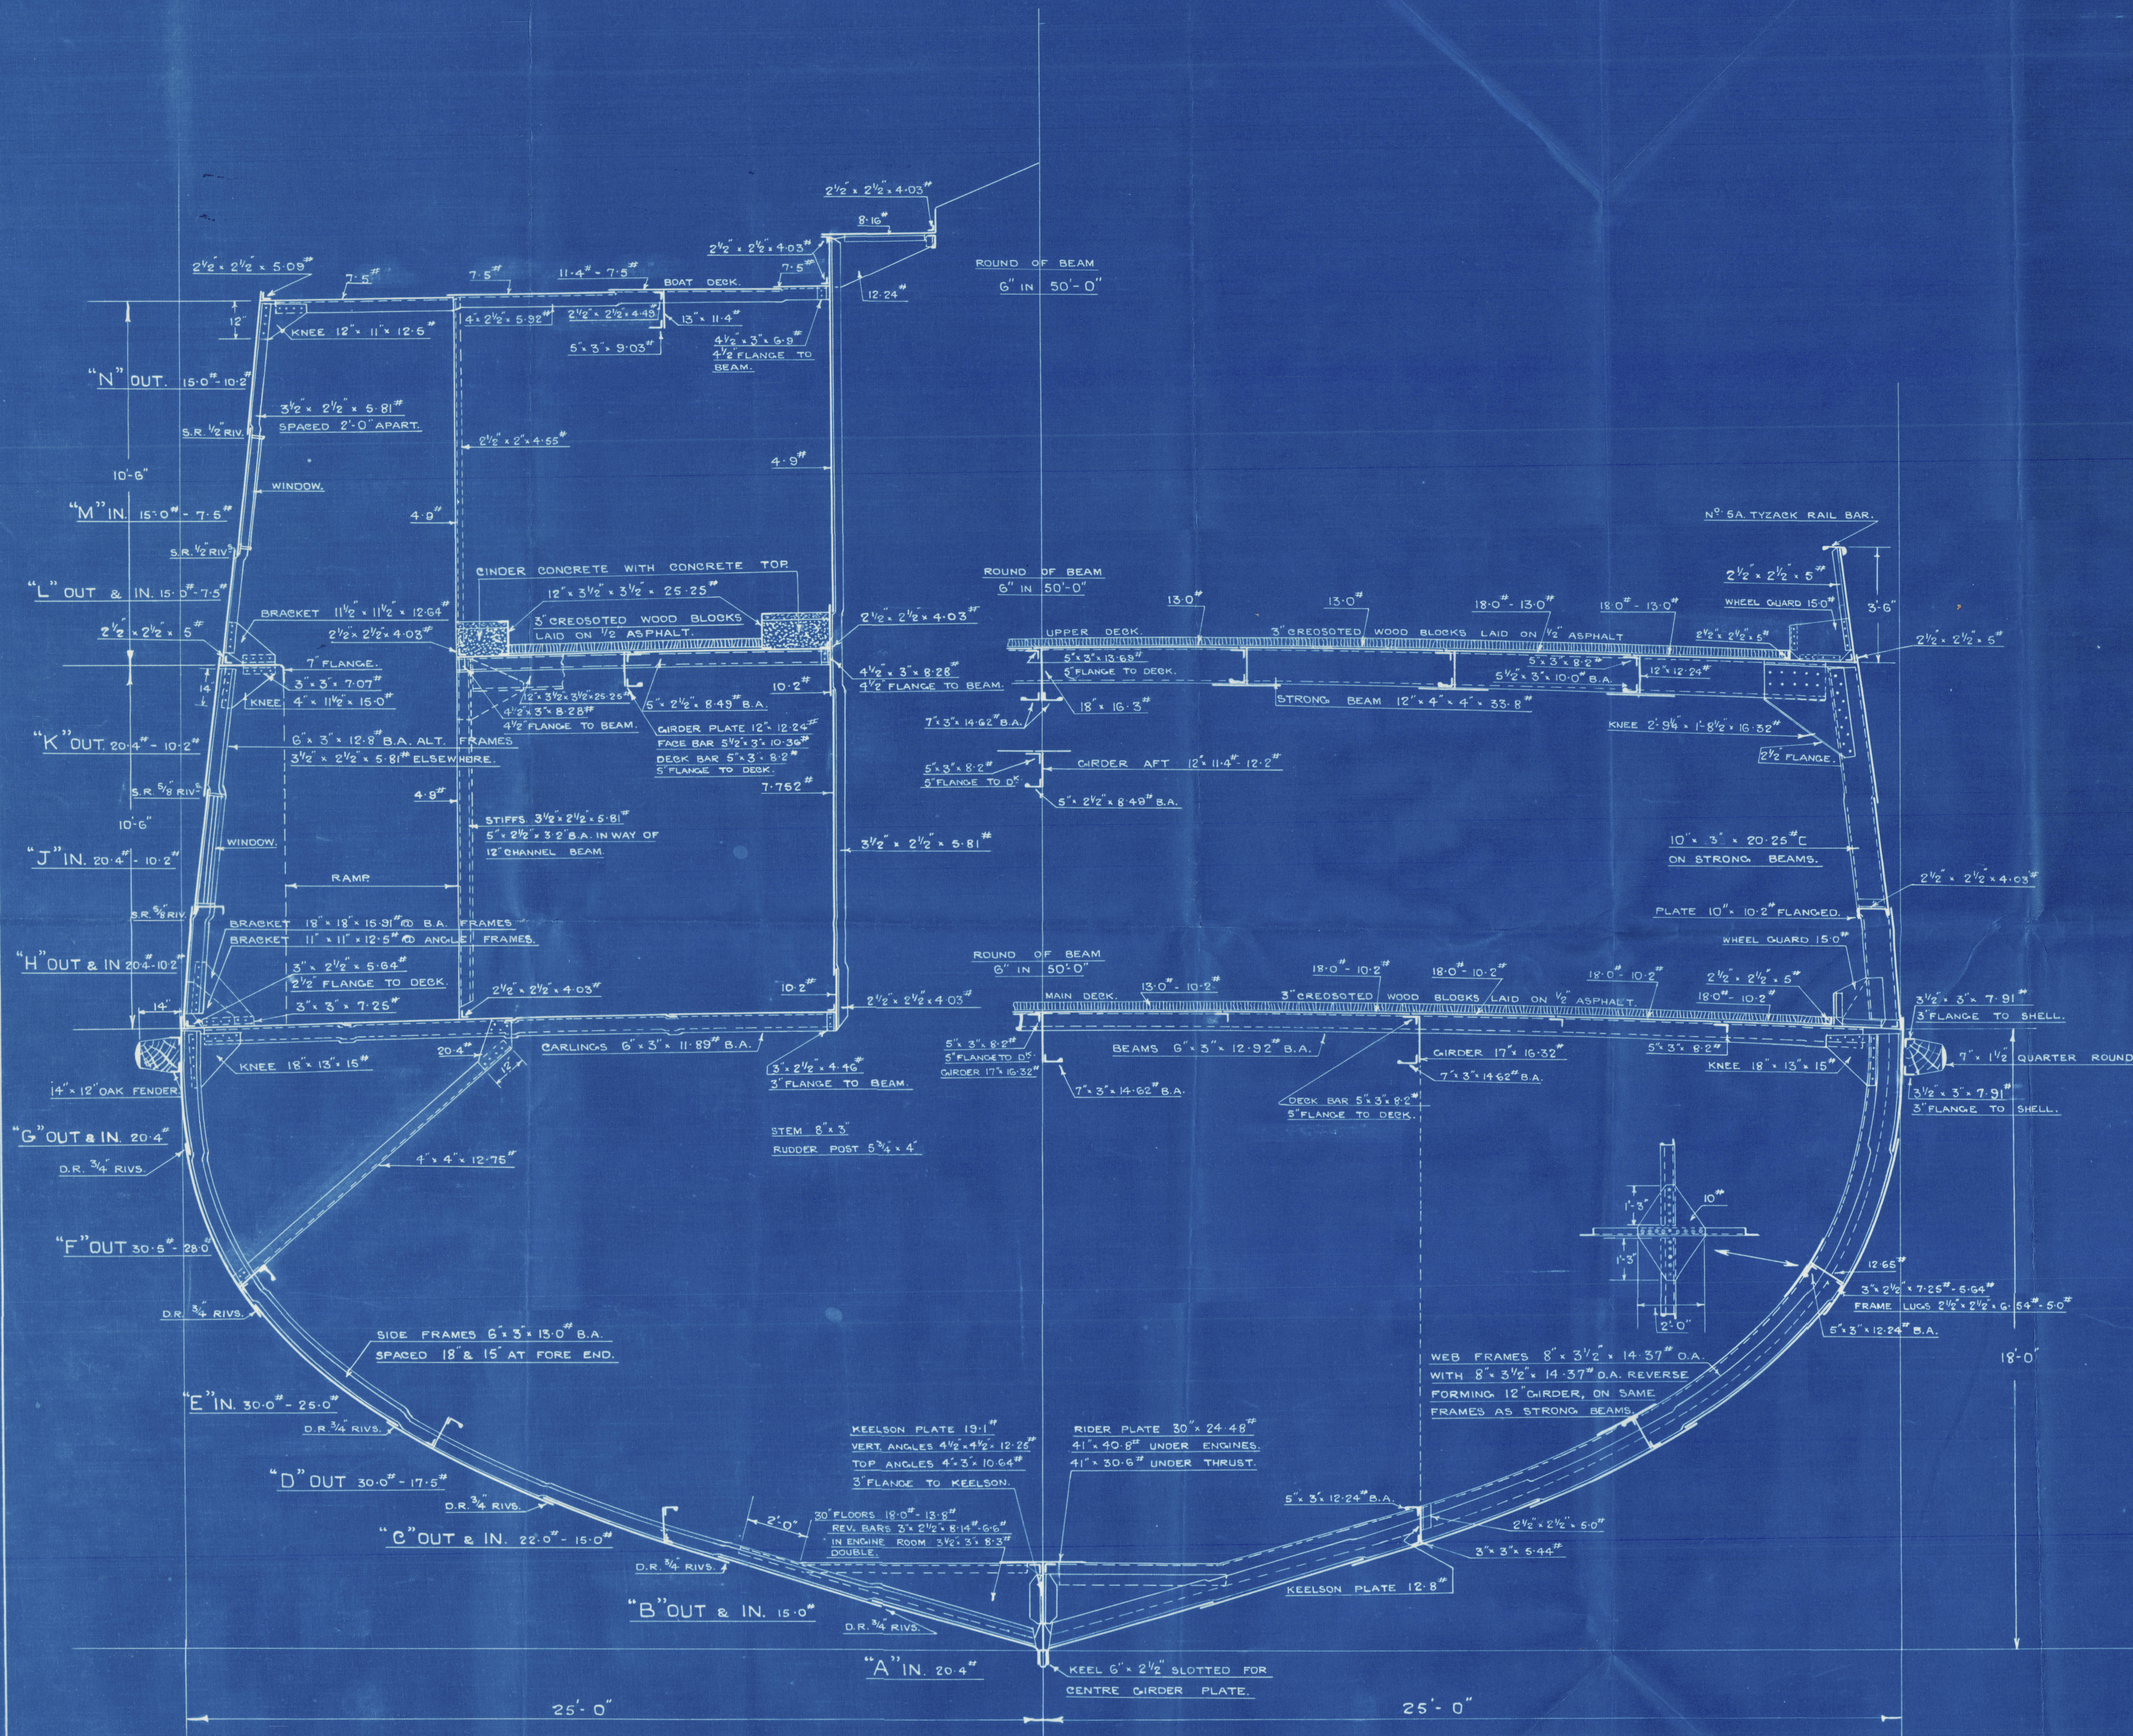

SECTION AFT
LOOKING AFT.

SECTION FORWARD
LOOKING FORWARD.

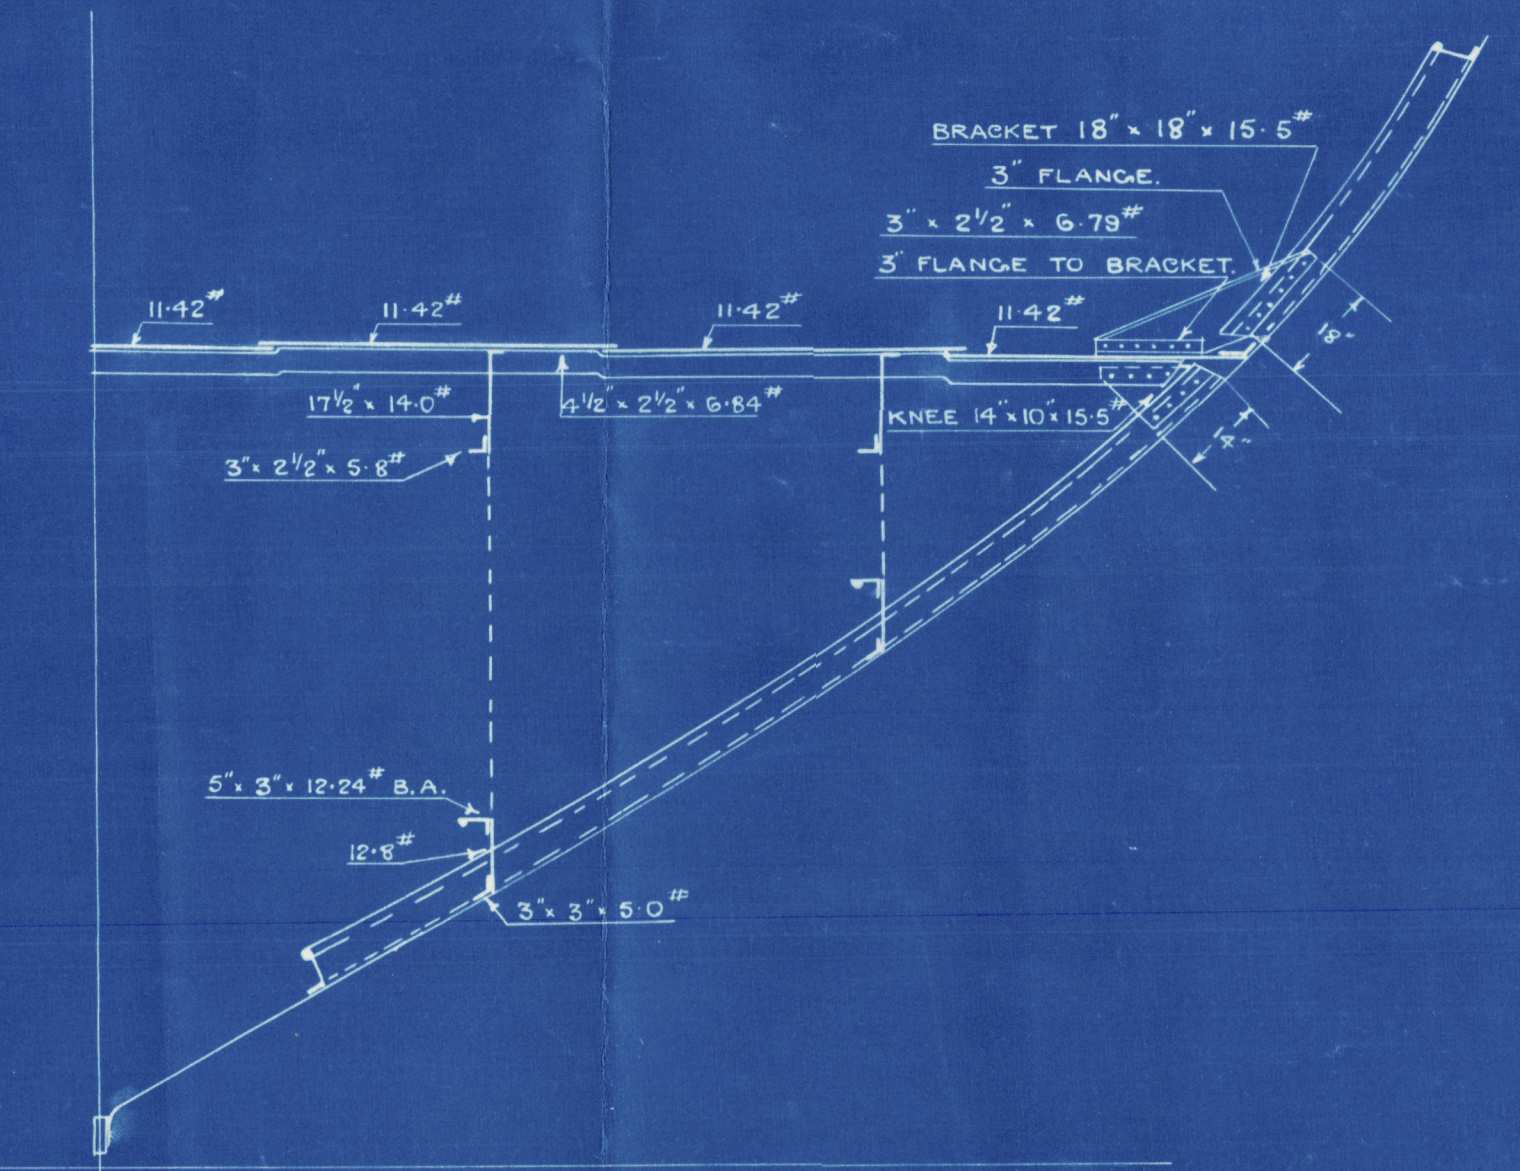

SECTION AT WATERTIGHT FLAT FORWARD
LOOKING AFT.

"

"

CITE DE QUEBEC

Napier & Miller's No 275

Midship Section
as Built -

GLASGOW REPORT No. 50721



© 2020

Lloyd's Register
Foundation

008993-009003-0225