
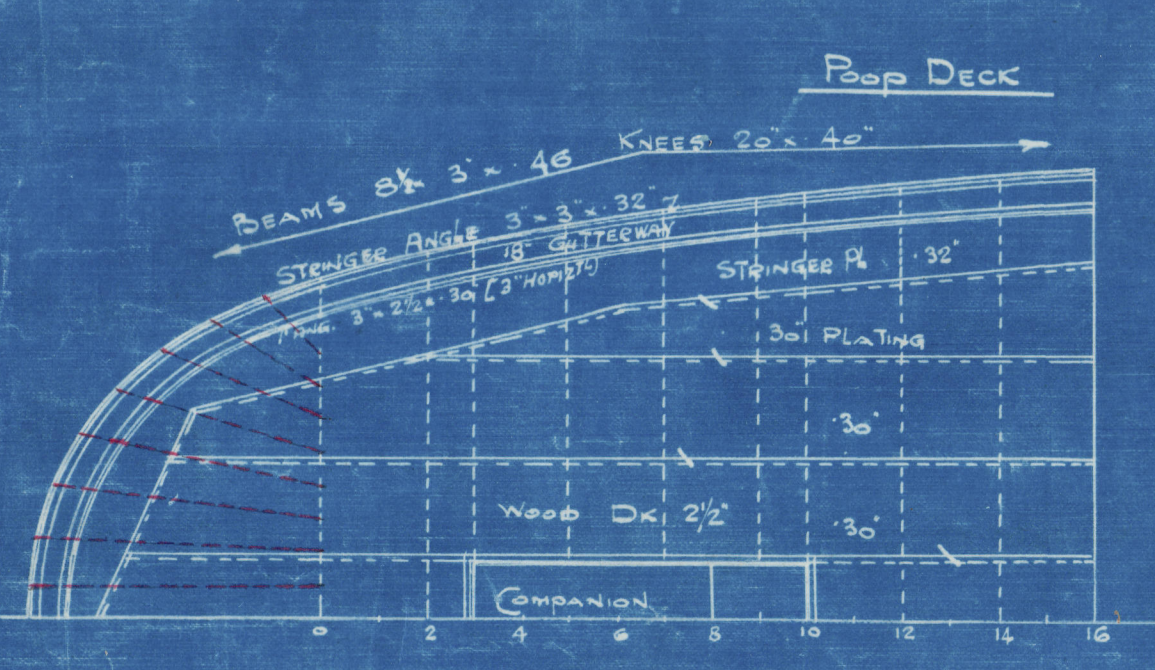
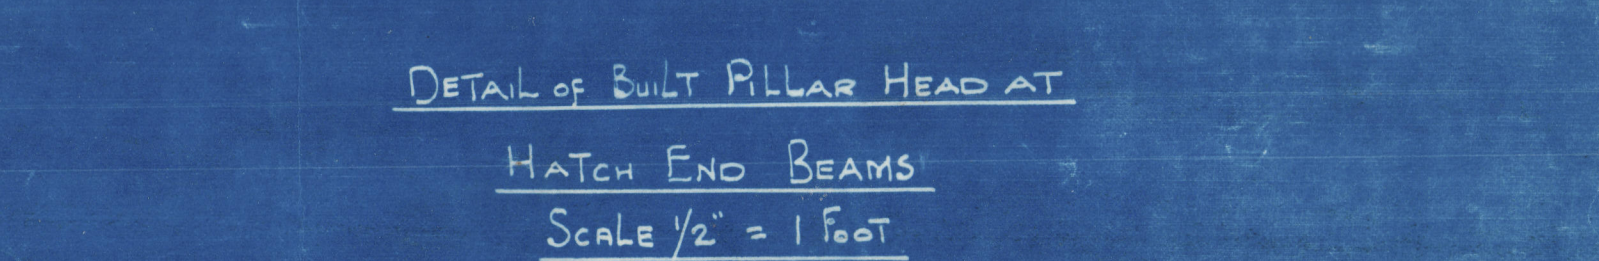
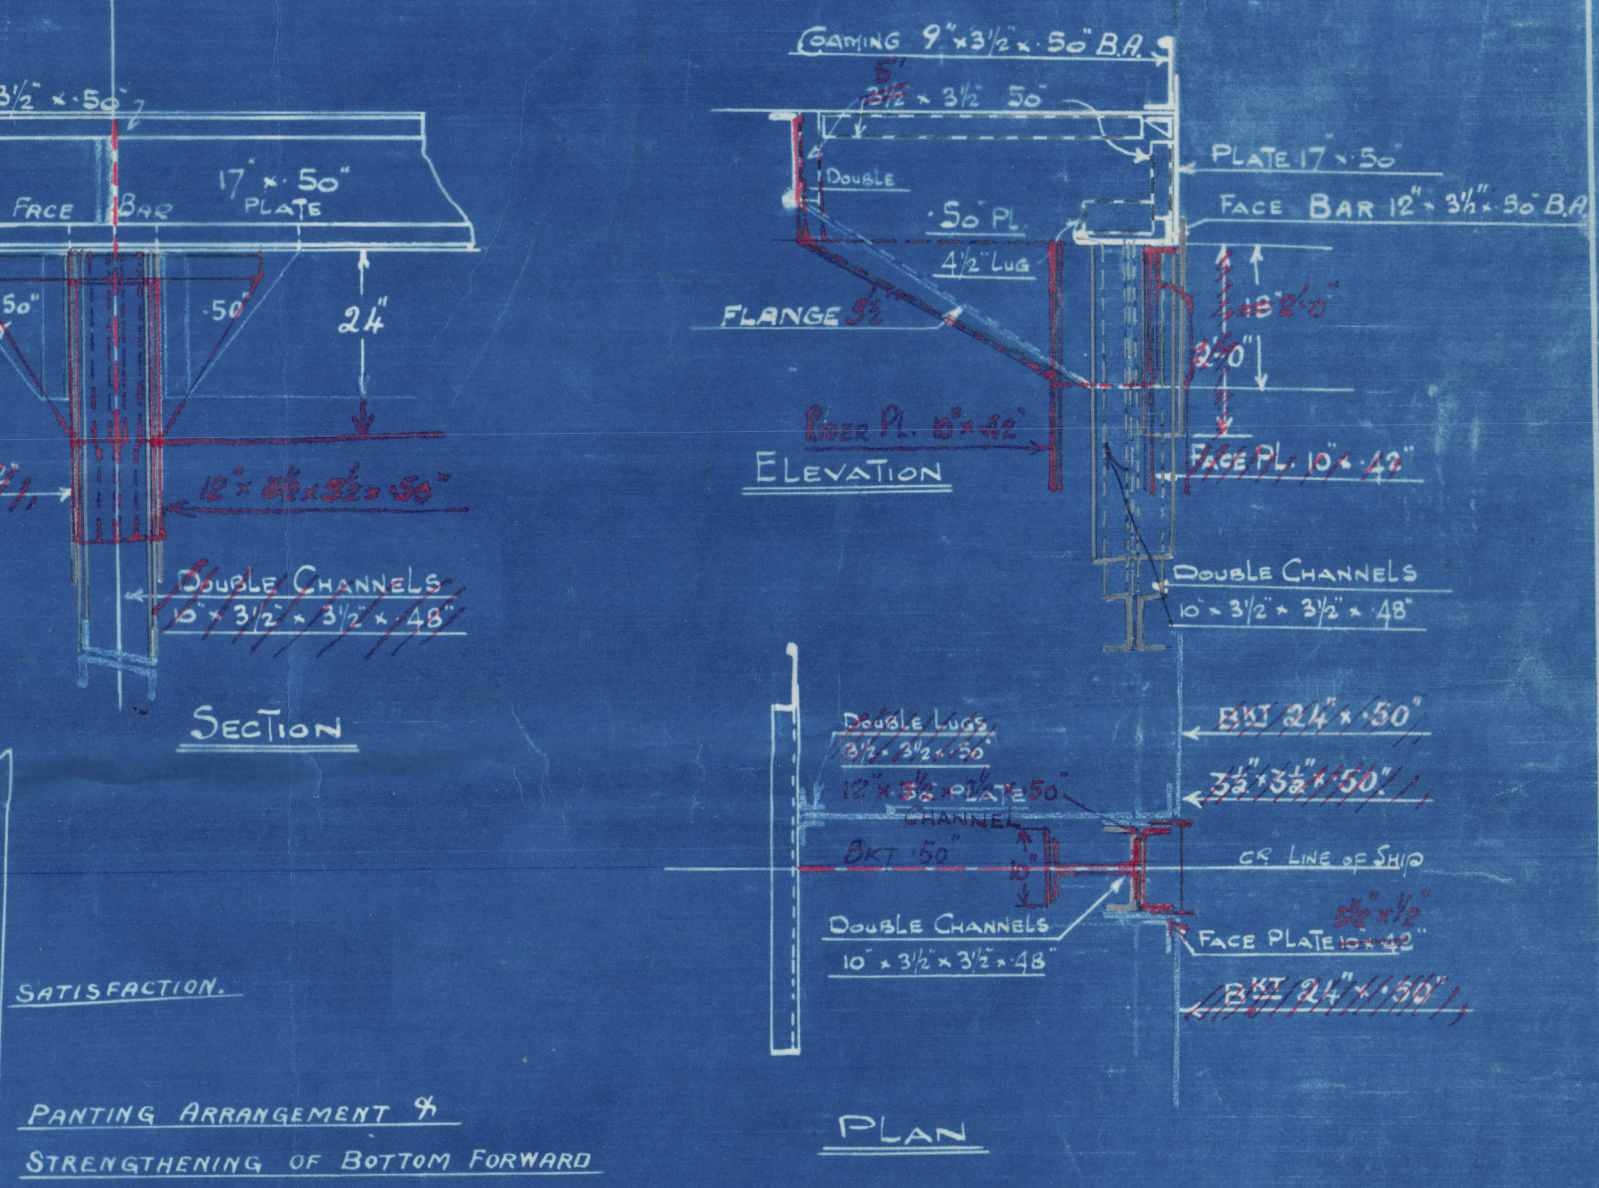


S.S. NOS 345 16  
PROFILE AND DECKS





SCALE 1/8" = 1 FOOT

TO CLASS 100 A.I. LLOYDS

DIMS. 285'0" B.P. x 42'6" M.B. B.P. x 22'3" M.B. (top edge)

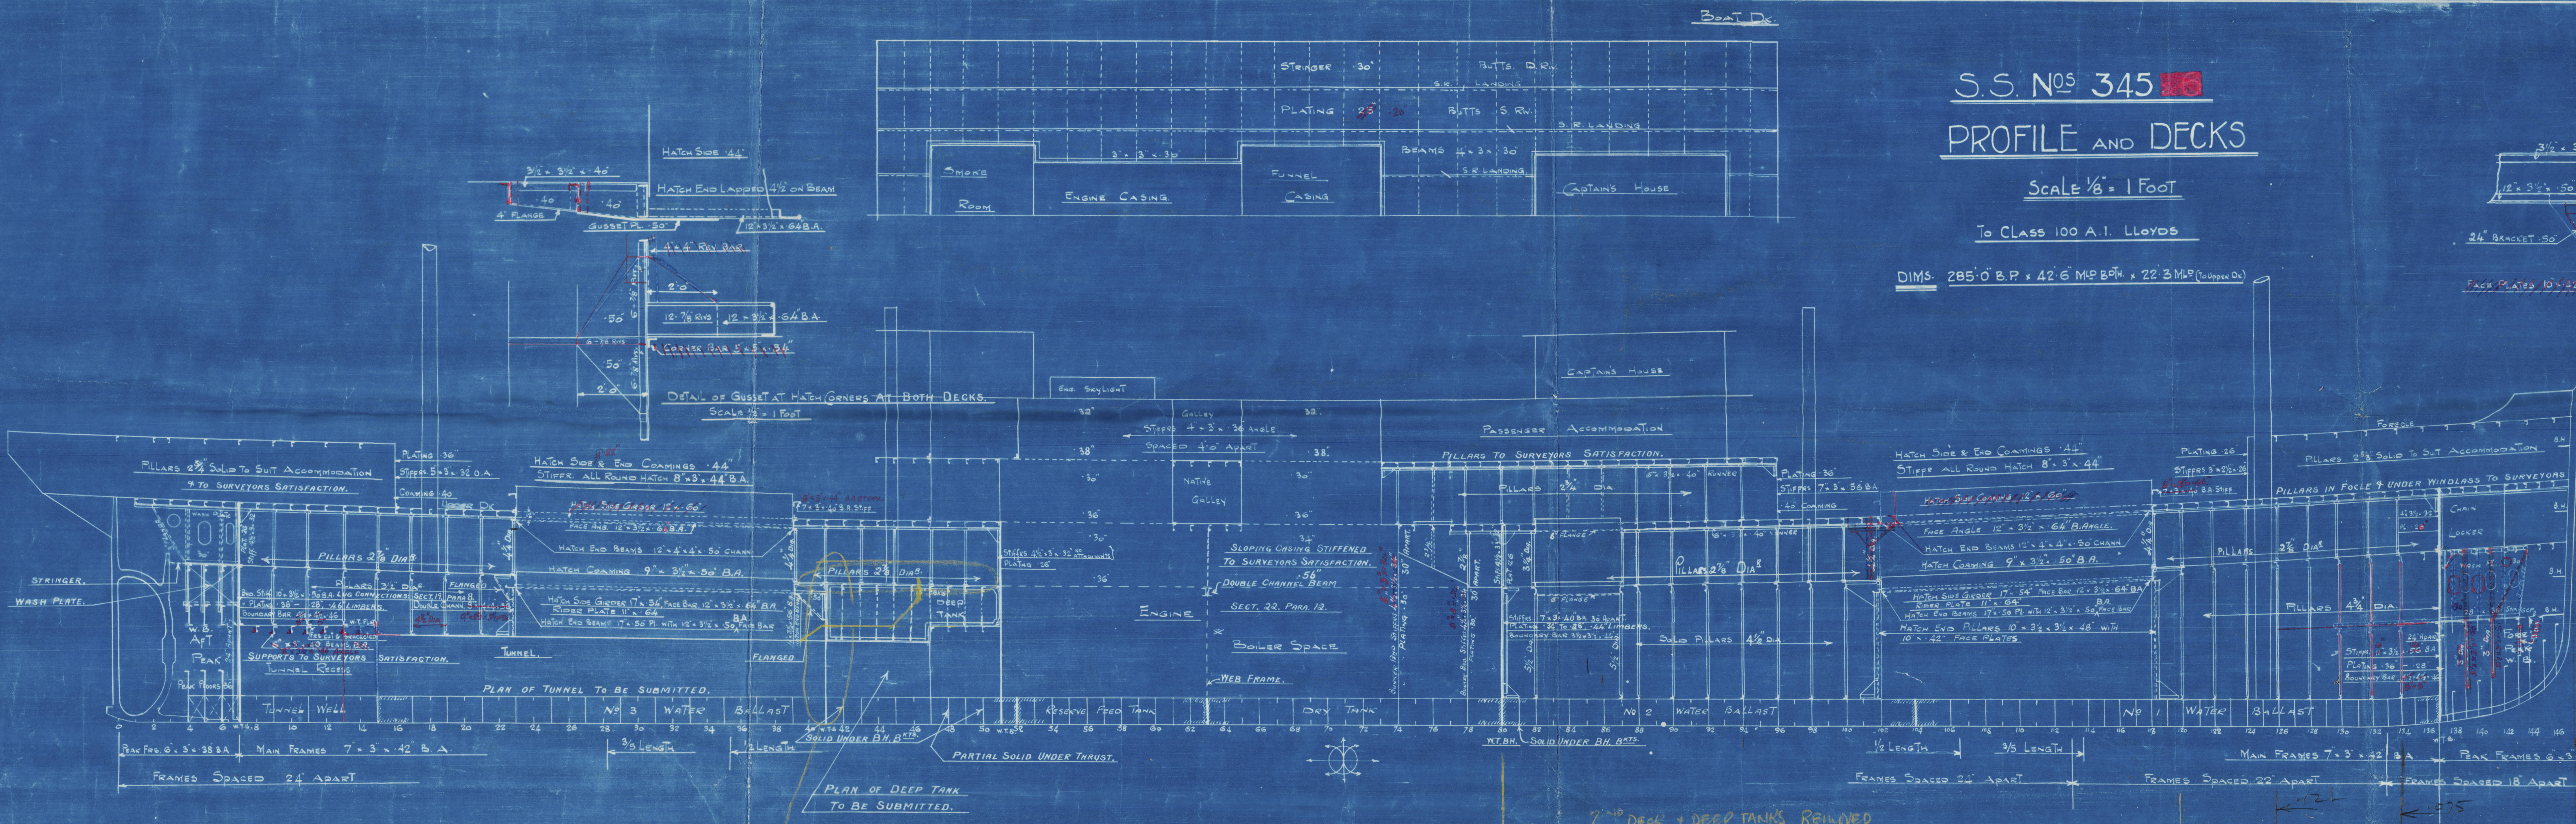

See Calcutta Letter dated 18.1.63

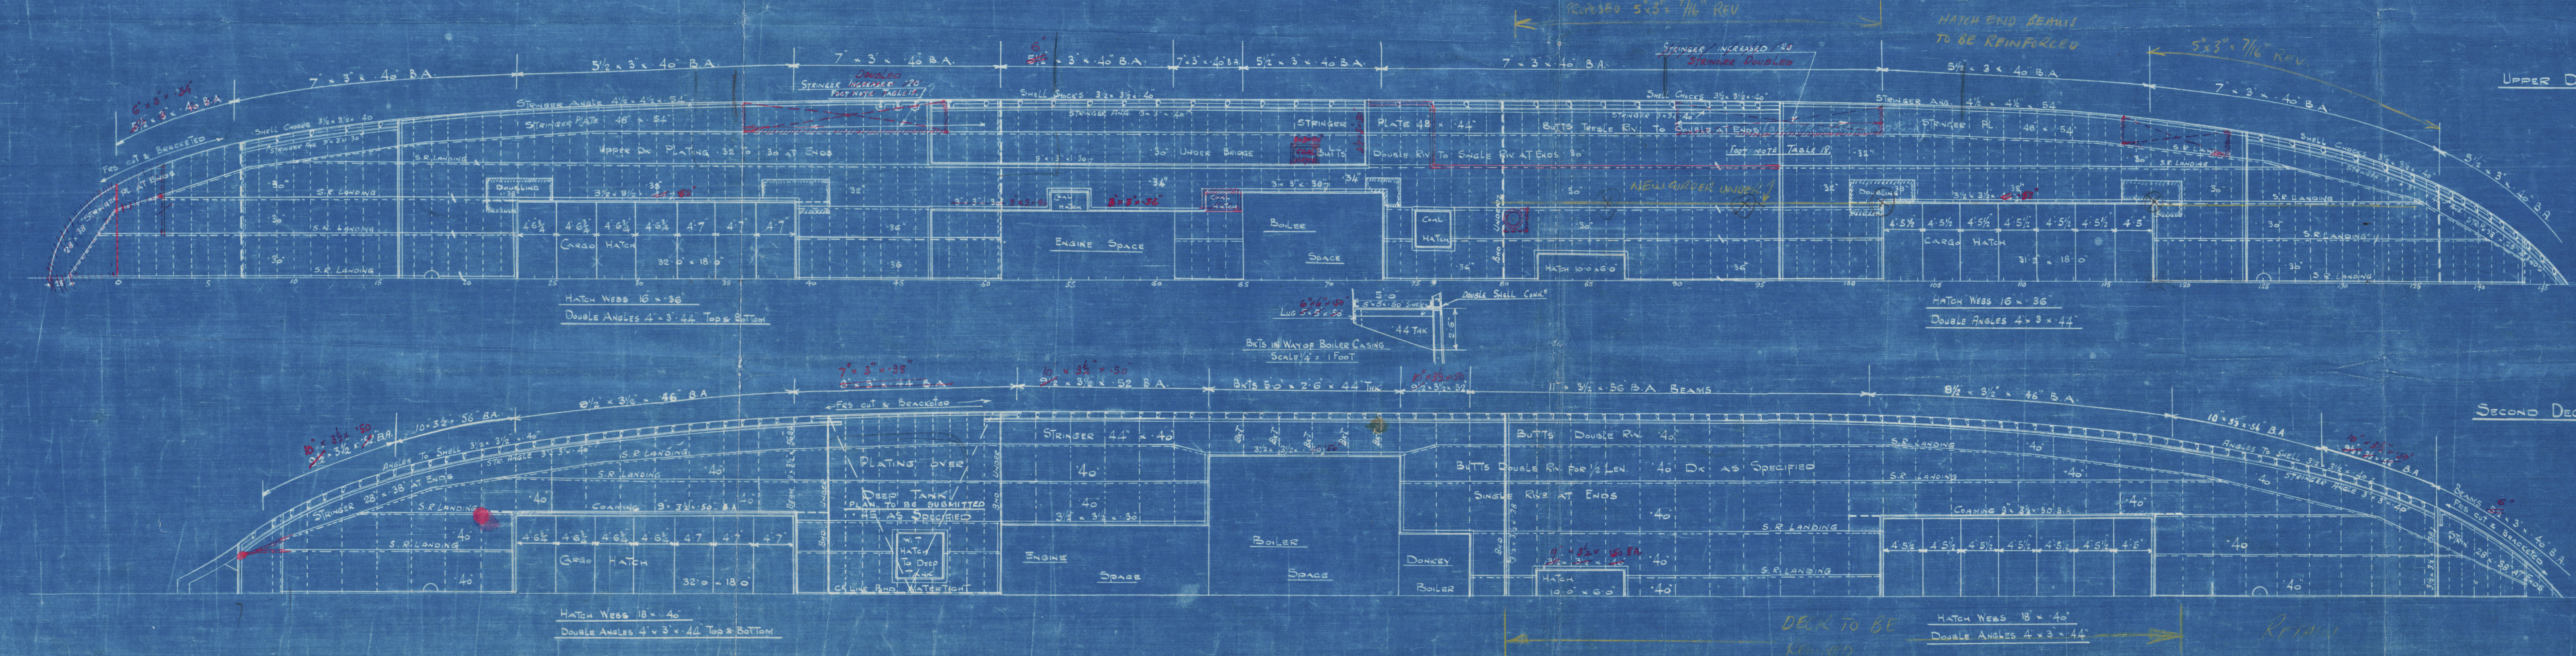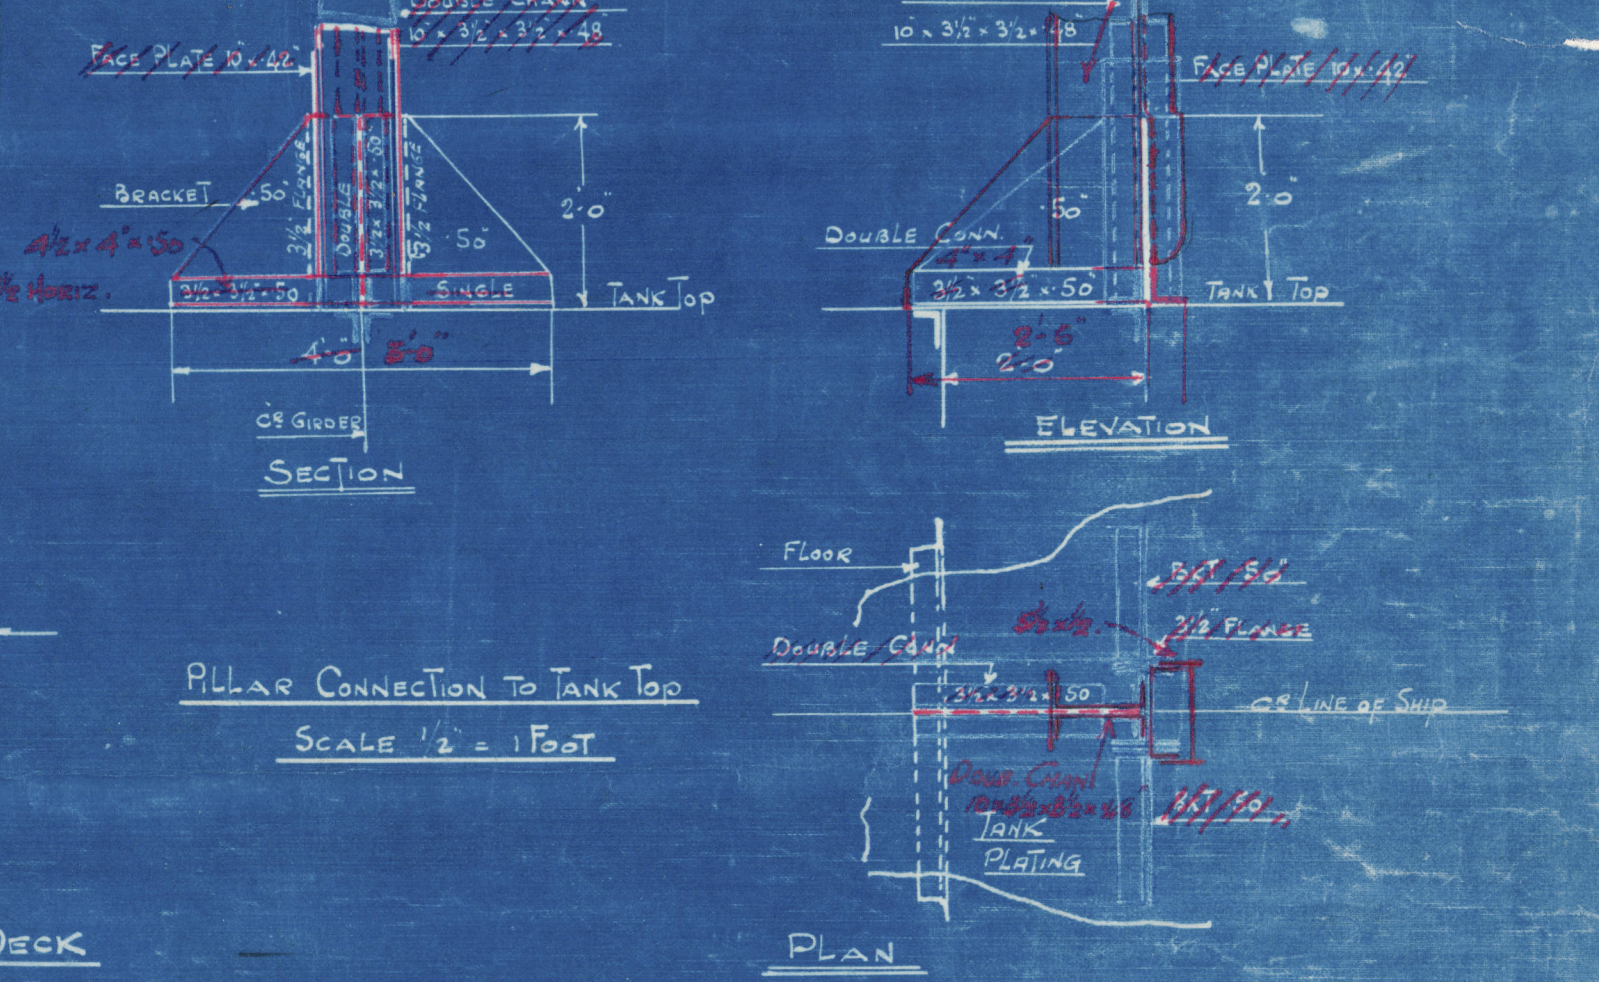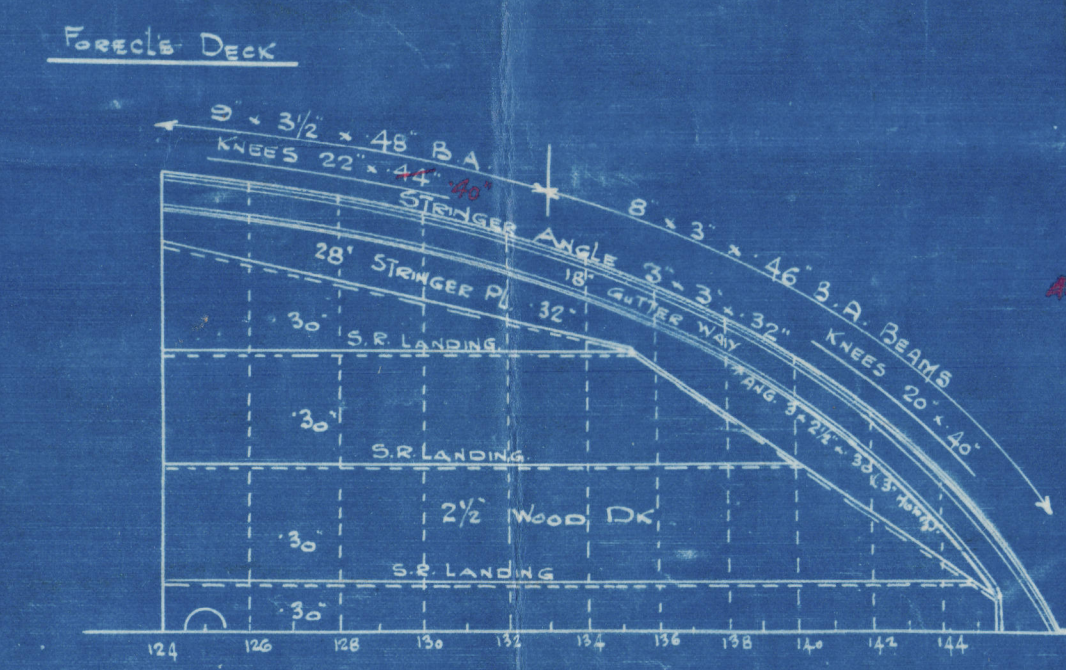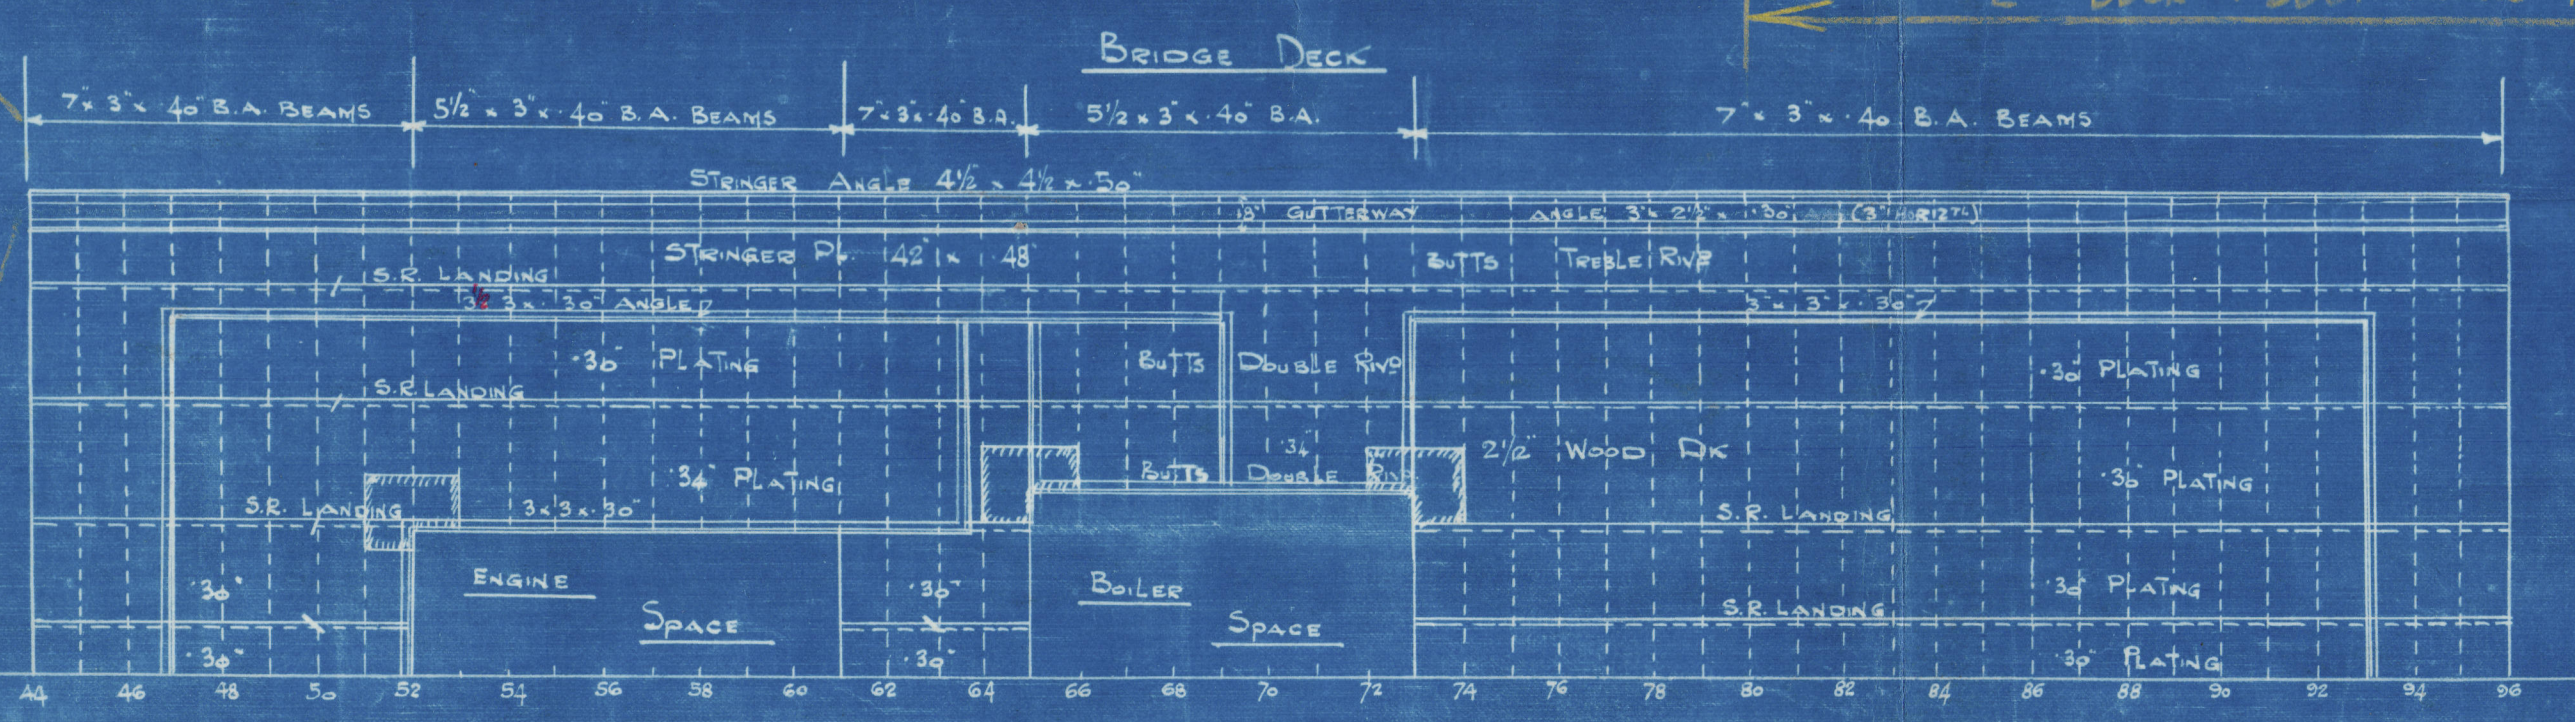



PROFILE AND DECK PLAN  
AS BUILT.

S.S. 'FAUSANG'

DUNLOP BREMNER'S N<sup>o</sup> 345

---

GREENOOK

Report No 17920.

Boat D



© 2020

Lloyd's Register  
Foundation

009008-009014-0153