

S.S. "CITÉ DE LÉVIS."

S.S. "CITÉ DE QUÉBEC."

MIDSHIP SECTION.


SCALE :- $\frac{3}{8}$ " = 1 FOOT.

FERRY STEAMERS.

CLASSED 100A. AT LLOYDS FOR FERRY SERVICE BETWEEN QUEBEC & LÉVIS.	
LENGTH B.P.	144'-0"
BREADTH MOULDED.	50'-0"
DEPTH MOULDED.	18'-0"

EQUIPMENT.

- 1 STOCKLESS ANCHOR 9 CWTs.
- 1 STOCKLESS ANCHOR (SPARE) 9 CWTs.
- 90 FATHOMS 1" STUD LINK CABLE.
- 4 LENGTHS - 6" GIRC. MANILLA, 7 FATHOMS EACH.

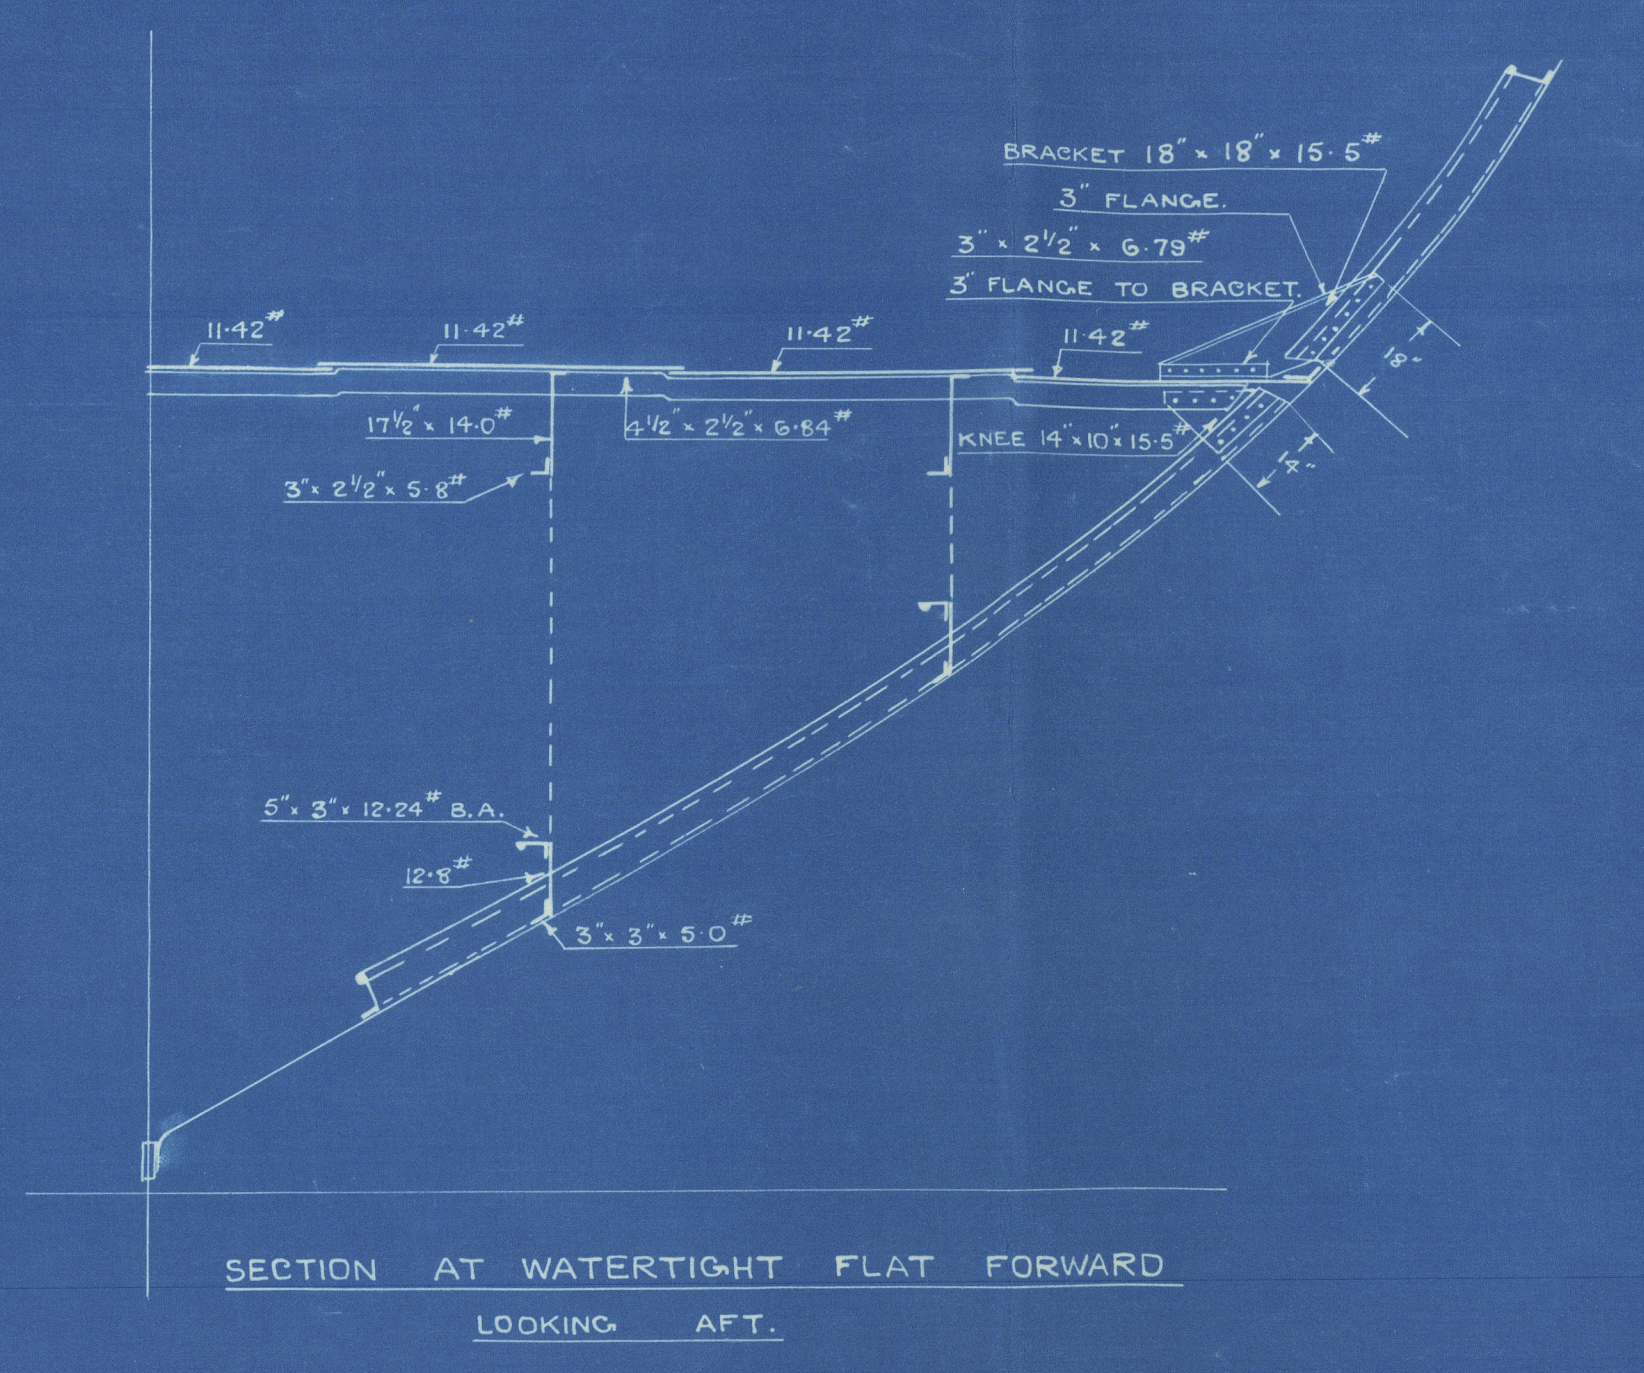

"CITE DE LEVIS"

Napier & Miller's No. 274

Midship Section
(as Built)

GLASGOW REPORT No. 50653



© 2020

Lloyd's Register

009122-009130-0096