

MIDSHIP TRANSVERSES Nos 36-41-51-56-66+71.

SCALE $\frac{3}{4}" = 1 \text{ FOOT}$
STARBOARD SIDE SHOWN. LOOKING AFT.

TRANSVERSES


4	OFF	STARBOARD	SIDE	} N ^o 36 - 41 - 51 + 56 FRAMES AS SHOWN.
4	→	PORT	SIDE	
1	→		→	} N ^o 66 FRAME CORRECTED FOR SHEER
1	→	STARBD	→	
1	→		→	} N ^o 71 FRAME CORRECTED FOR SHEER + BILGE.
1	→	PORT	→	

SECTION AT INTERMEDIATE FRAMES. STARBD SIDE. LOOKING AFT.

SECTION 21. INTERMEDIATE FRAMES, SHARDED SIDE SPOCKING

FRAME NOS	
29-30-33-34-35-37-38-39-40	} AS SHOWN.
42-43-44-47-48-49-50-52-53	
54-55-57-58-59-60	
63-64-65-67-68-69-70	CORRECTED FOR SHEER
72-73-74	CORRECTED FOR SHEER AND FORM.

DECK LONGITUDINALS 6" x 3" x .30 B.A.
RIVETS 1/2" FROM HEEL

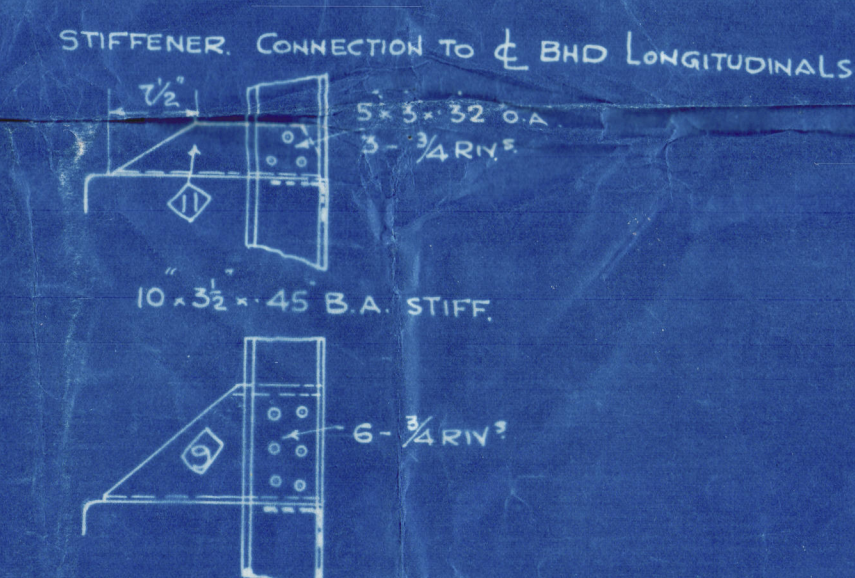

Nº 5. 9367.

BOTTOM LONGITUDINALS $9 \times 3 \times 38$ B.A.
RIVETS IN BOTTOM LONG^{TS} $1\frac{3}{4}$ " FROM HEEL

FURNESS S.B. CO.
S/S "OTTAWALITE" N°173
MIDSHIP TRANSVERSES
AS BUILT

S.S. *Ottawalite*
MDB. RPT. No. 14064



© 2020

Lloyd's Register
Foundation

009131-009138-0042