



SCALE:-  $\frac{1}{8}$  IN. TO ONE FT.

SHEATHED WITH 2 1/4" TEAK

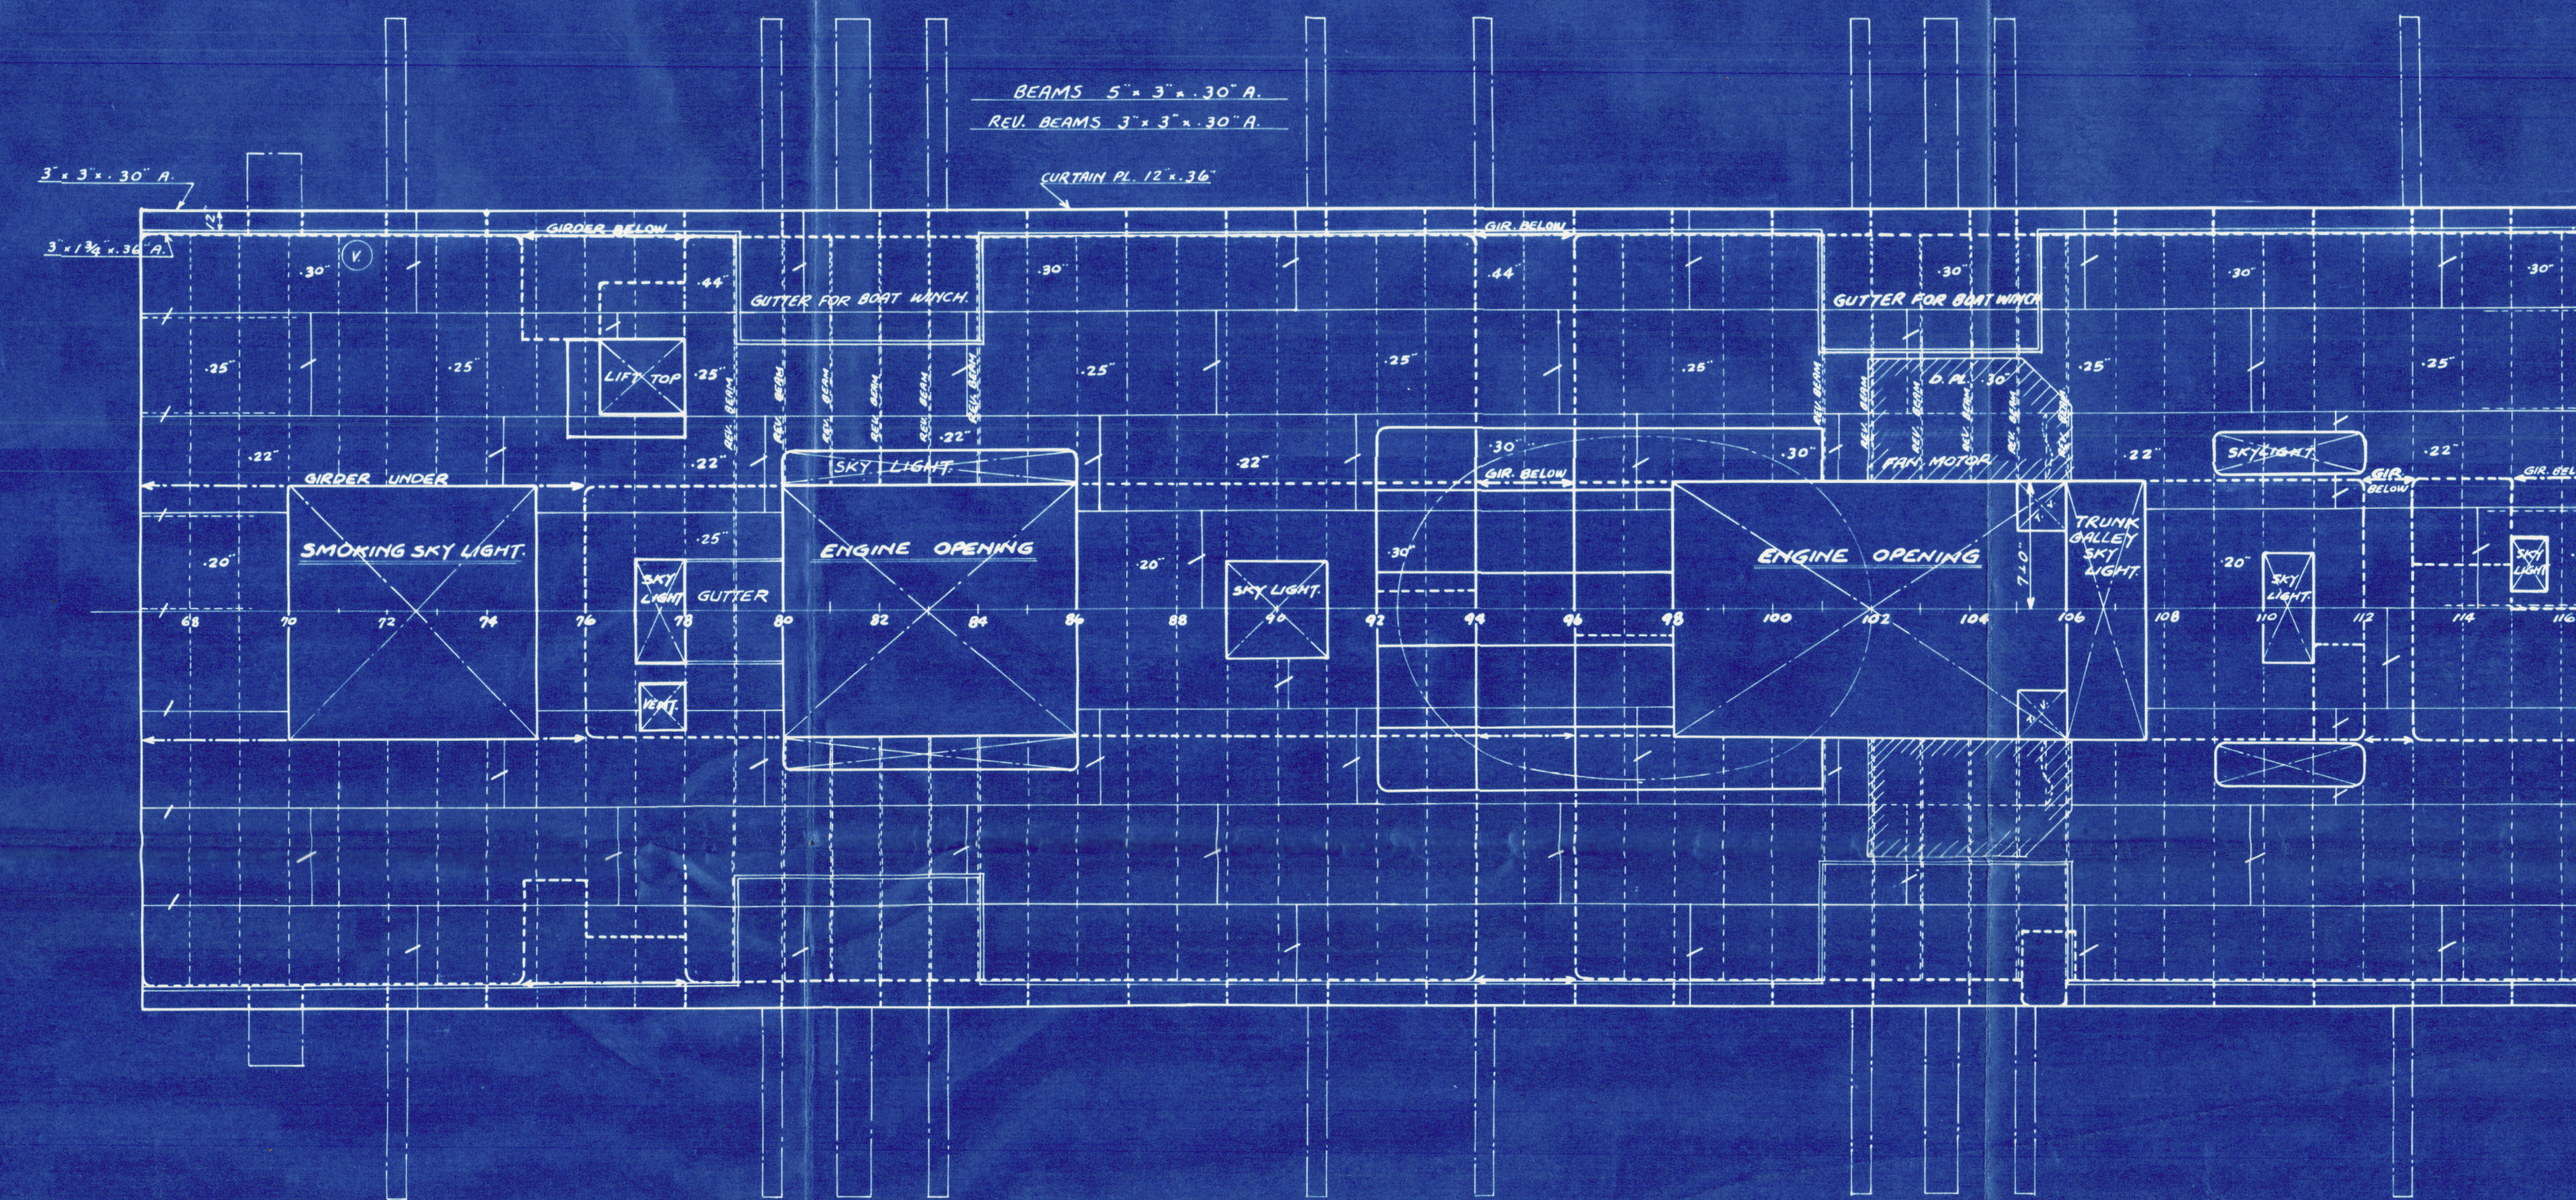


SHEATHED WITH 5" x 3" O.P. WHERE EXPOSED WITH TEAK MARGIN PLANK

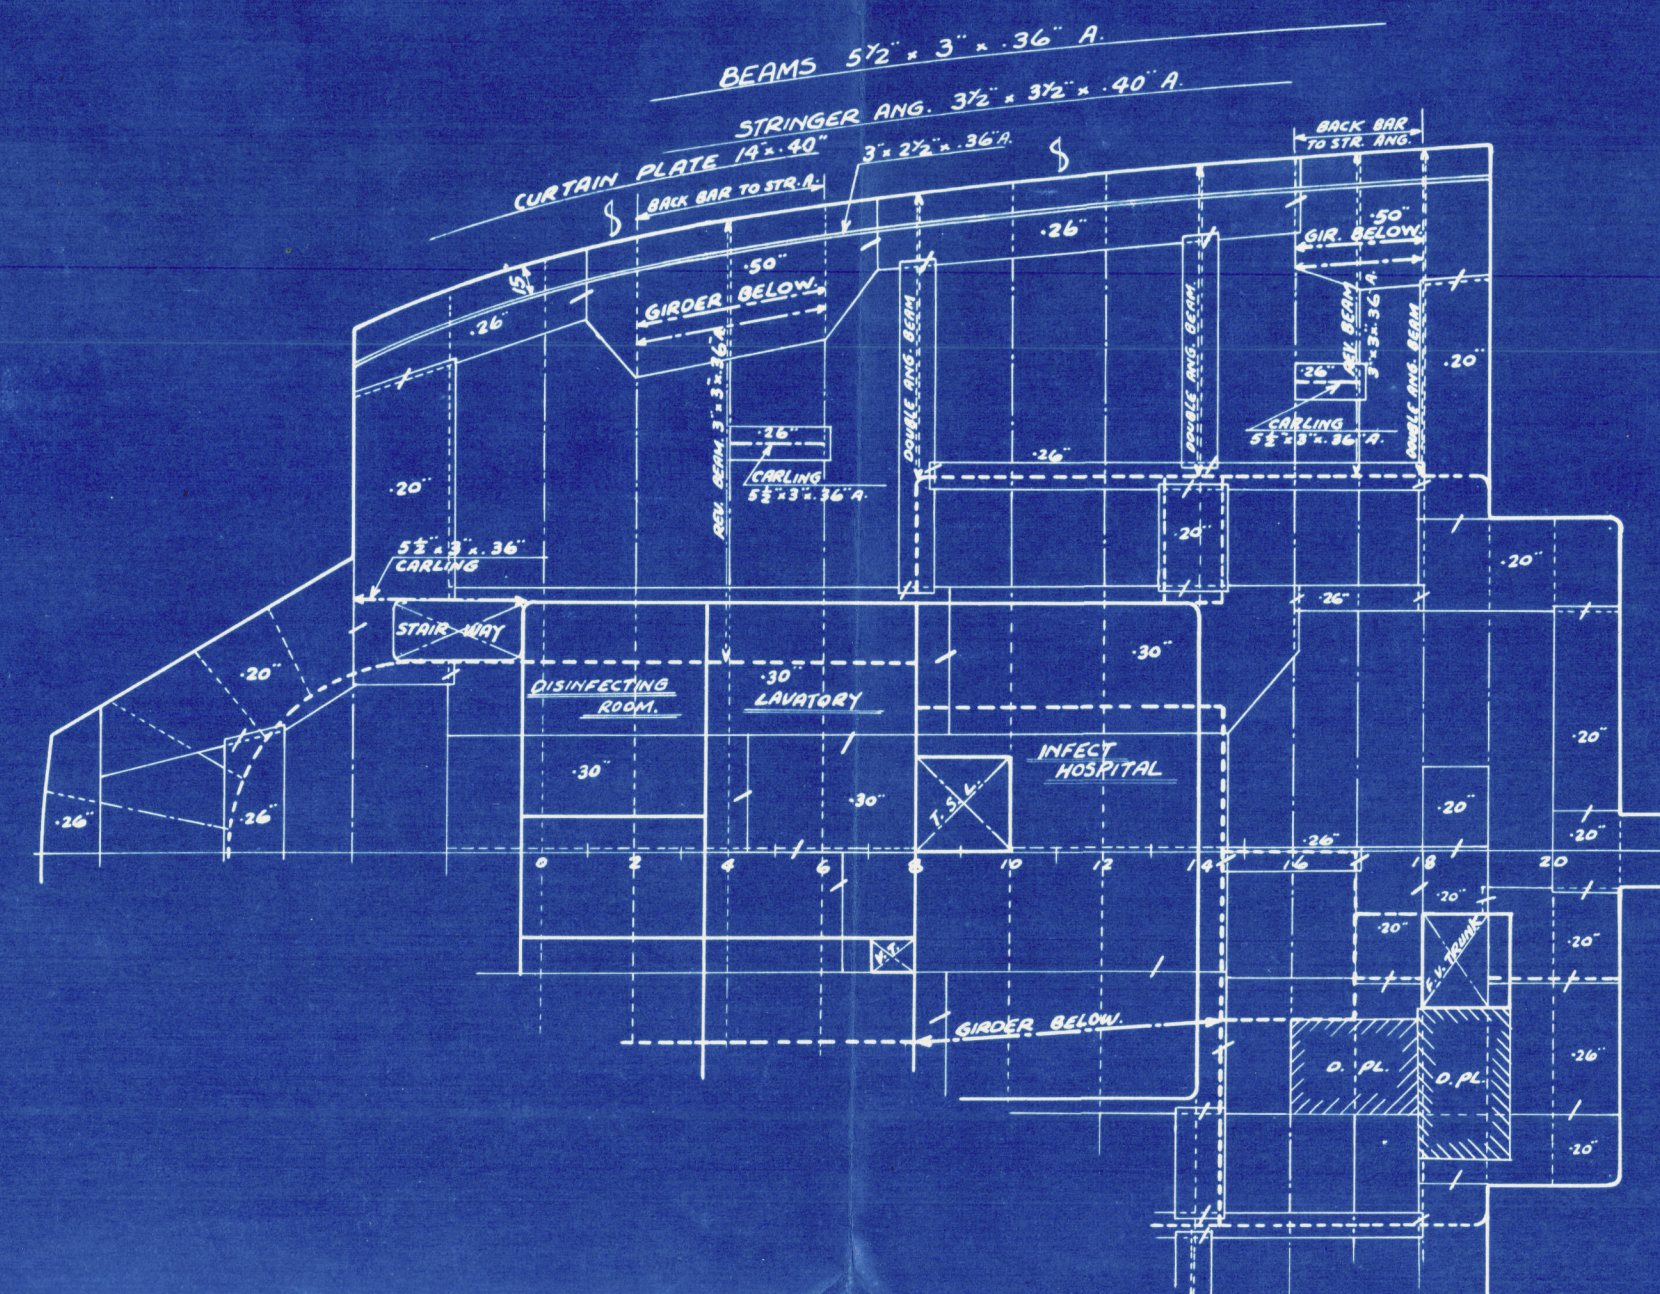

FRAME SPACE 24"      FRAME SPACE 33"

BEAMS 6" x 3" x .40" ANGLES - 16' 0" SPAN

SHEATHED WITH 3" O. P. WHERE EXPOSED  
2 1/2" O. P. WHERE ENCLOSED  
 2" x 3" x 3/4" O. P. IN HOUSE ONLY

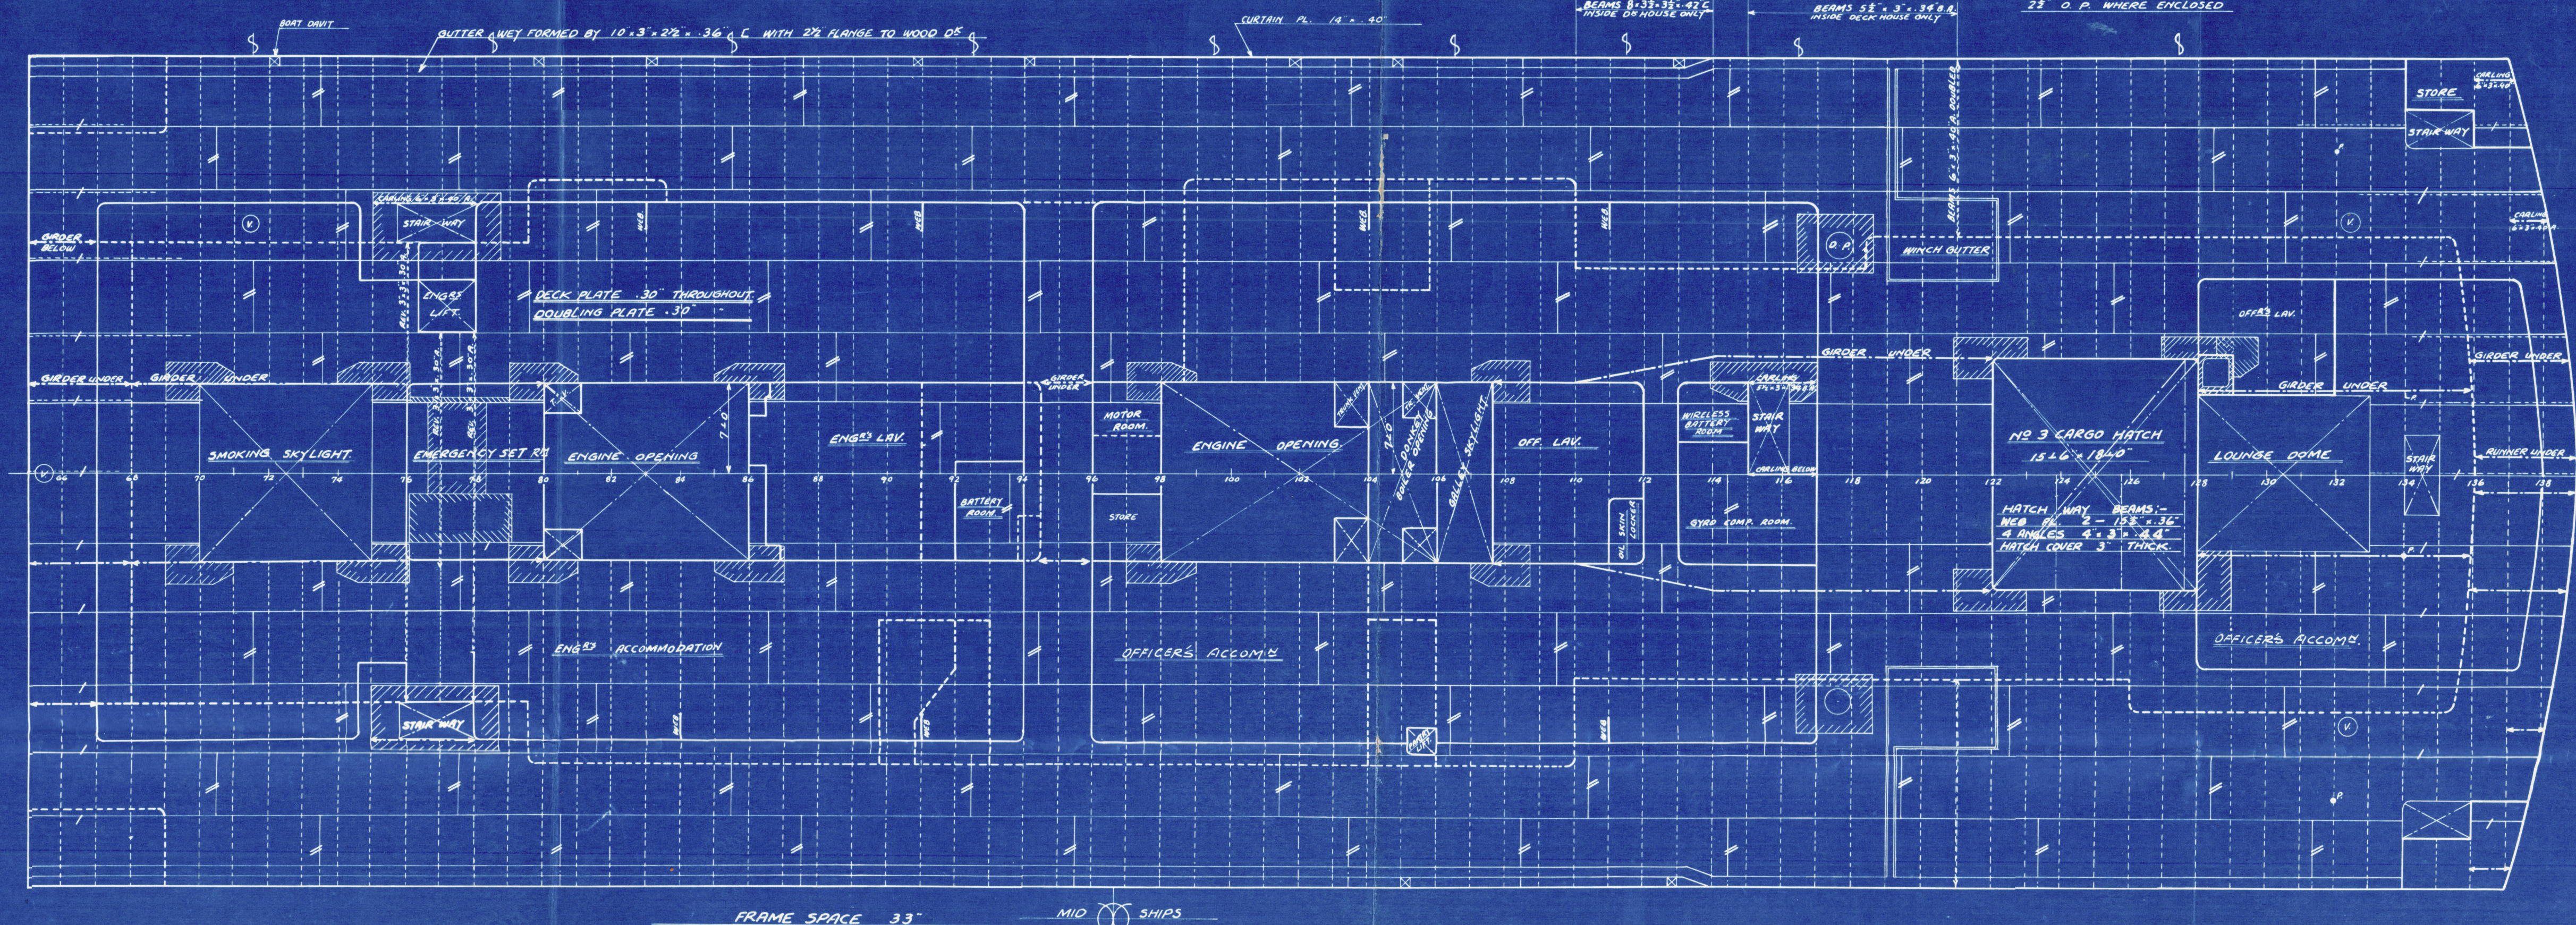

FRAME SPACE 33" MID SHIPS



T.S.M.V. "HEIAN MARU"  
CONSTRUCTION PROFILE  
AND  
DECK PLANS  
SHEET NO.2

*As Built-*

*Kobe Report 7150*



© 2021

Lloyd's Register  
Foundation  
REF. NO. SH-732

009182 - 009191 - 0022