






STEEL DUMB BARGES.—YARD No. <sup>285</sup>~~284 B~~.

DIMS:- LTH.B.P 160'-0" x 25'-0" BTH.MLD. x 8'-6" DPH.MLD.

AS BUILT

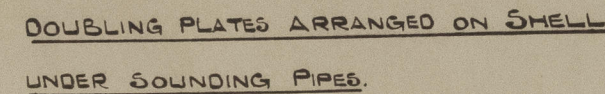

SCALE:- 1" = 1. FOOT.

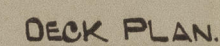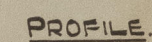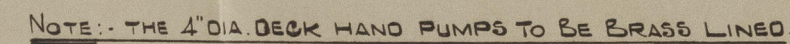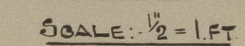




BARGE.

Henry Robb Esq Yard No 285.

Pumping Plan as built.

"KAVAR"

Leith Report No 19789.

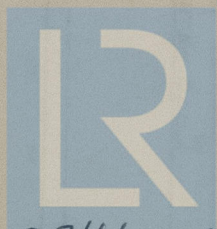

© 2021

Lloyd's Register  
Foundation

009341-009349-0105