

TO CLASS TEISHINSHO RULE 1ST CLASS VESSEL &
LLOYD'S 100A1 WITH FREEBOARD (MOULDED LOAD DRAFT 7.697 METRE)

SECTION BARS TO BE NIPPON STANDARD SECTION

CASTING & FORGING:-

STEM	LOWER PART	CAST STEEL
	UPPER	MILD STEEL PLATE
STERN POST		CAST STEEL
RUDDER POST		
RUDDER MAIN PIECE		FOR OERTZ RUDDER
RUDDER STOCK		FORGED STEEL

RIVETING IN SHELL TO FRAME

RIVET 22 DIA. 19 DIA. AT ENDS SPACED 7 DIA. APART FOR BOTTOM PLATING
& 6 1/2 DIA. APART FOR SIDE PLATING 1/2 DIA. APART IN PEAK TANKS & DEEP
TANK & BOTTOM 1/2 L. FORWARD & PANTING FRAME

RIVETING IN DECK PLATING TO BEAM:-

THIRD DECK
RIVET 16 DIA. THROUGHOUT SPACED 7 DIA. APART 6 DIA. APART
IN WAY OF PEAK TANKS EXCEPT 19 ON PEAK TANK TOP
SECOND DECK
RIVET 19 DIA. 16 DIA. AT ENDS SPACED 7 DIA. APART THROUGHOUT
UPPER DECK
RIVET 19 DIA. 22 DIA. AT AHEAD OF OPENING WHERE PLATING
ABOVE 12.5 SPACED 7 DIA. APART THROUGHOUT

RIVETING IN INNER BOTTOM PLATING TO REV. FRAME

RIVET 19 DIA. THROUGHOUT SPACED 7 DIA. APART EXCEPT IN MOTOR
ROOM WHERE 22 DIA. 28 DIA. AT MOTOR BED PLATING SPACED 5 DIA.
APART & 5 DIA. APART REV. TO FLOOR UNDER MOTOR BED PLATING

ROW OF RIVET IN BUTT	ITEM	L	ENDS
UPPER DECK STRINGER PLATE	4	3-2	
PLATE	3	1	
SECOND DECK STRINGER PLATE	2	1	
PLATE	2	1	
THIRD DECK STRINGER PLATE	2	2	
PLATE	1	1	
SHEER STRAKE	4	3	
STRAKE BELOW	4	3	
SIDE PLATING	4	3	
BOTTOM PLATING	4	3	
MIDDLE STRAKE OF INNER BOTTOM	2	2	
INNER BOTTOM PLATING	2	2	
MARGIN PLATE	3	3	
CENTRE GIRDER	3	3	
KEEL PLATE	4	4-3	

PRINCIPAL DIMENSIONS:-

LENGTH BETWEEN P.P.	128.00 M.
BREADTH MOULDED	17.50
DEPTH	11.00
HIGHT BETWEEN	UPPER & 2ND DKS. 2.85 M., 2.60 M. IN MOTOR RM.
	UPPER & BRIDGE DKS. 2.35
	BRIDGE & BOAT DKS. 2.35
	BOAT & FLYING BR. DKS. 2.45
	UPPER & FORCIBLE DKS. 2.25
	OF POOP HOUSE 2.25
	OF DECK STORES UNDER DERRICK TABLE 2.15

SCANTLING NUMERALS:-

B.	17.50
D.	11.00
L.	128.00
FIRST LONGITUDINAL NUMERAL	1408.00
SECOND	3648.00
1/2 TO UPPER DECK	11.64

EQUIPMENT NUMERAL:-


SECOND LONGITUDINAL NUMERAL	3648.00
FORECASTLE	12.40 x 2.25 x 3/4
DECK HOUSE	(8.40 x 24.00) x 2.35 x 1/2
	13.40 x 2.45 x 1/2
	12.00 x 2.25 x 1/2
	3770.07

EQUIPMENTS:-

3 BOWER ANCHORS (STOCKLESS)	3555 ^{MM} 3555 ^{MM} 3872 ^{MM} EACH
STREAM ANCHOR (COMMON EX. STOCK)	1357 ^{MM}
550 METRE 60 ^{MM} STUD CHAIN CABLE	
225 40.5 ^{MM} (5/16) STEEL WIRE FOR STREAM ANCHOR	
240 40.5 ^{MM} (5/16)	
185 28 ^{MM} (5/16)	
2 COILS OF 185 METRE 65 ^{MM} MANILA	
1 COIL OF 220 METRE 40 ^{MM}	
2 COILS 28 ^{MM}	

IN NO 6 HOLD

SIDE GIRDER IN HOLDS
(EXCEPT 1/2 L. FORWARD)

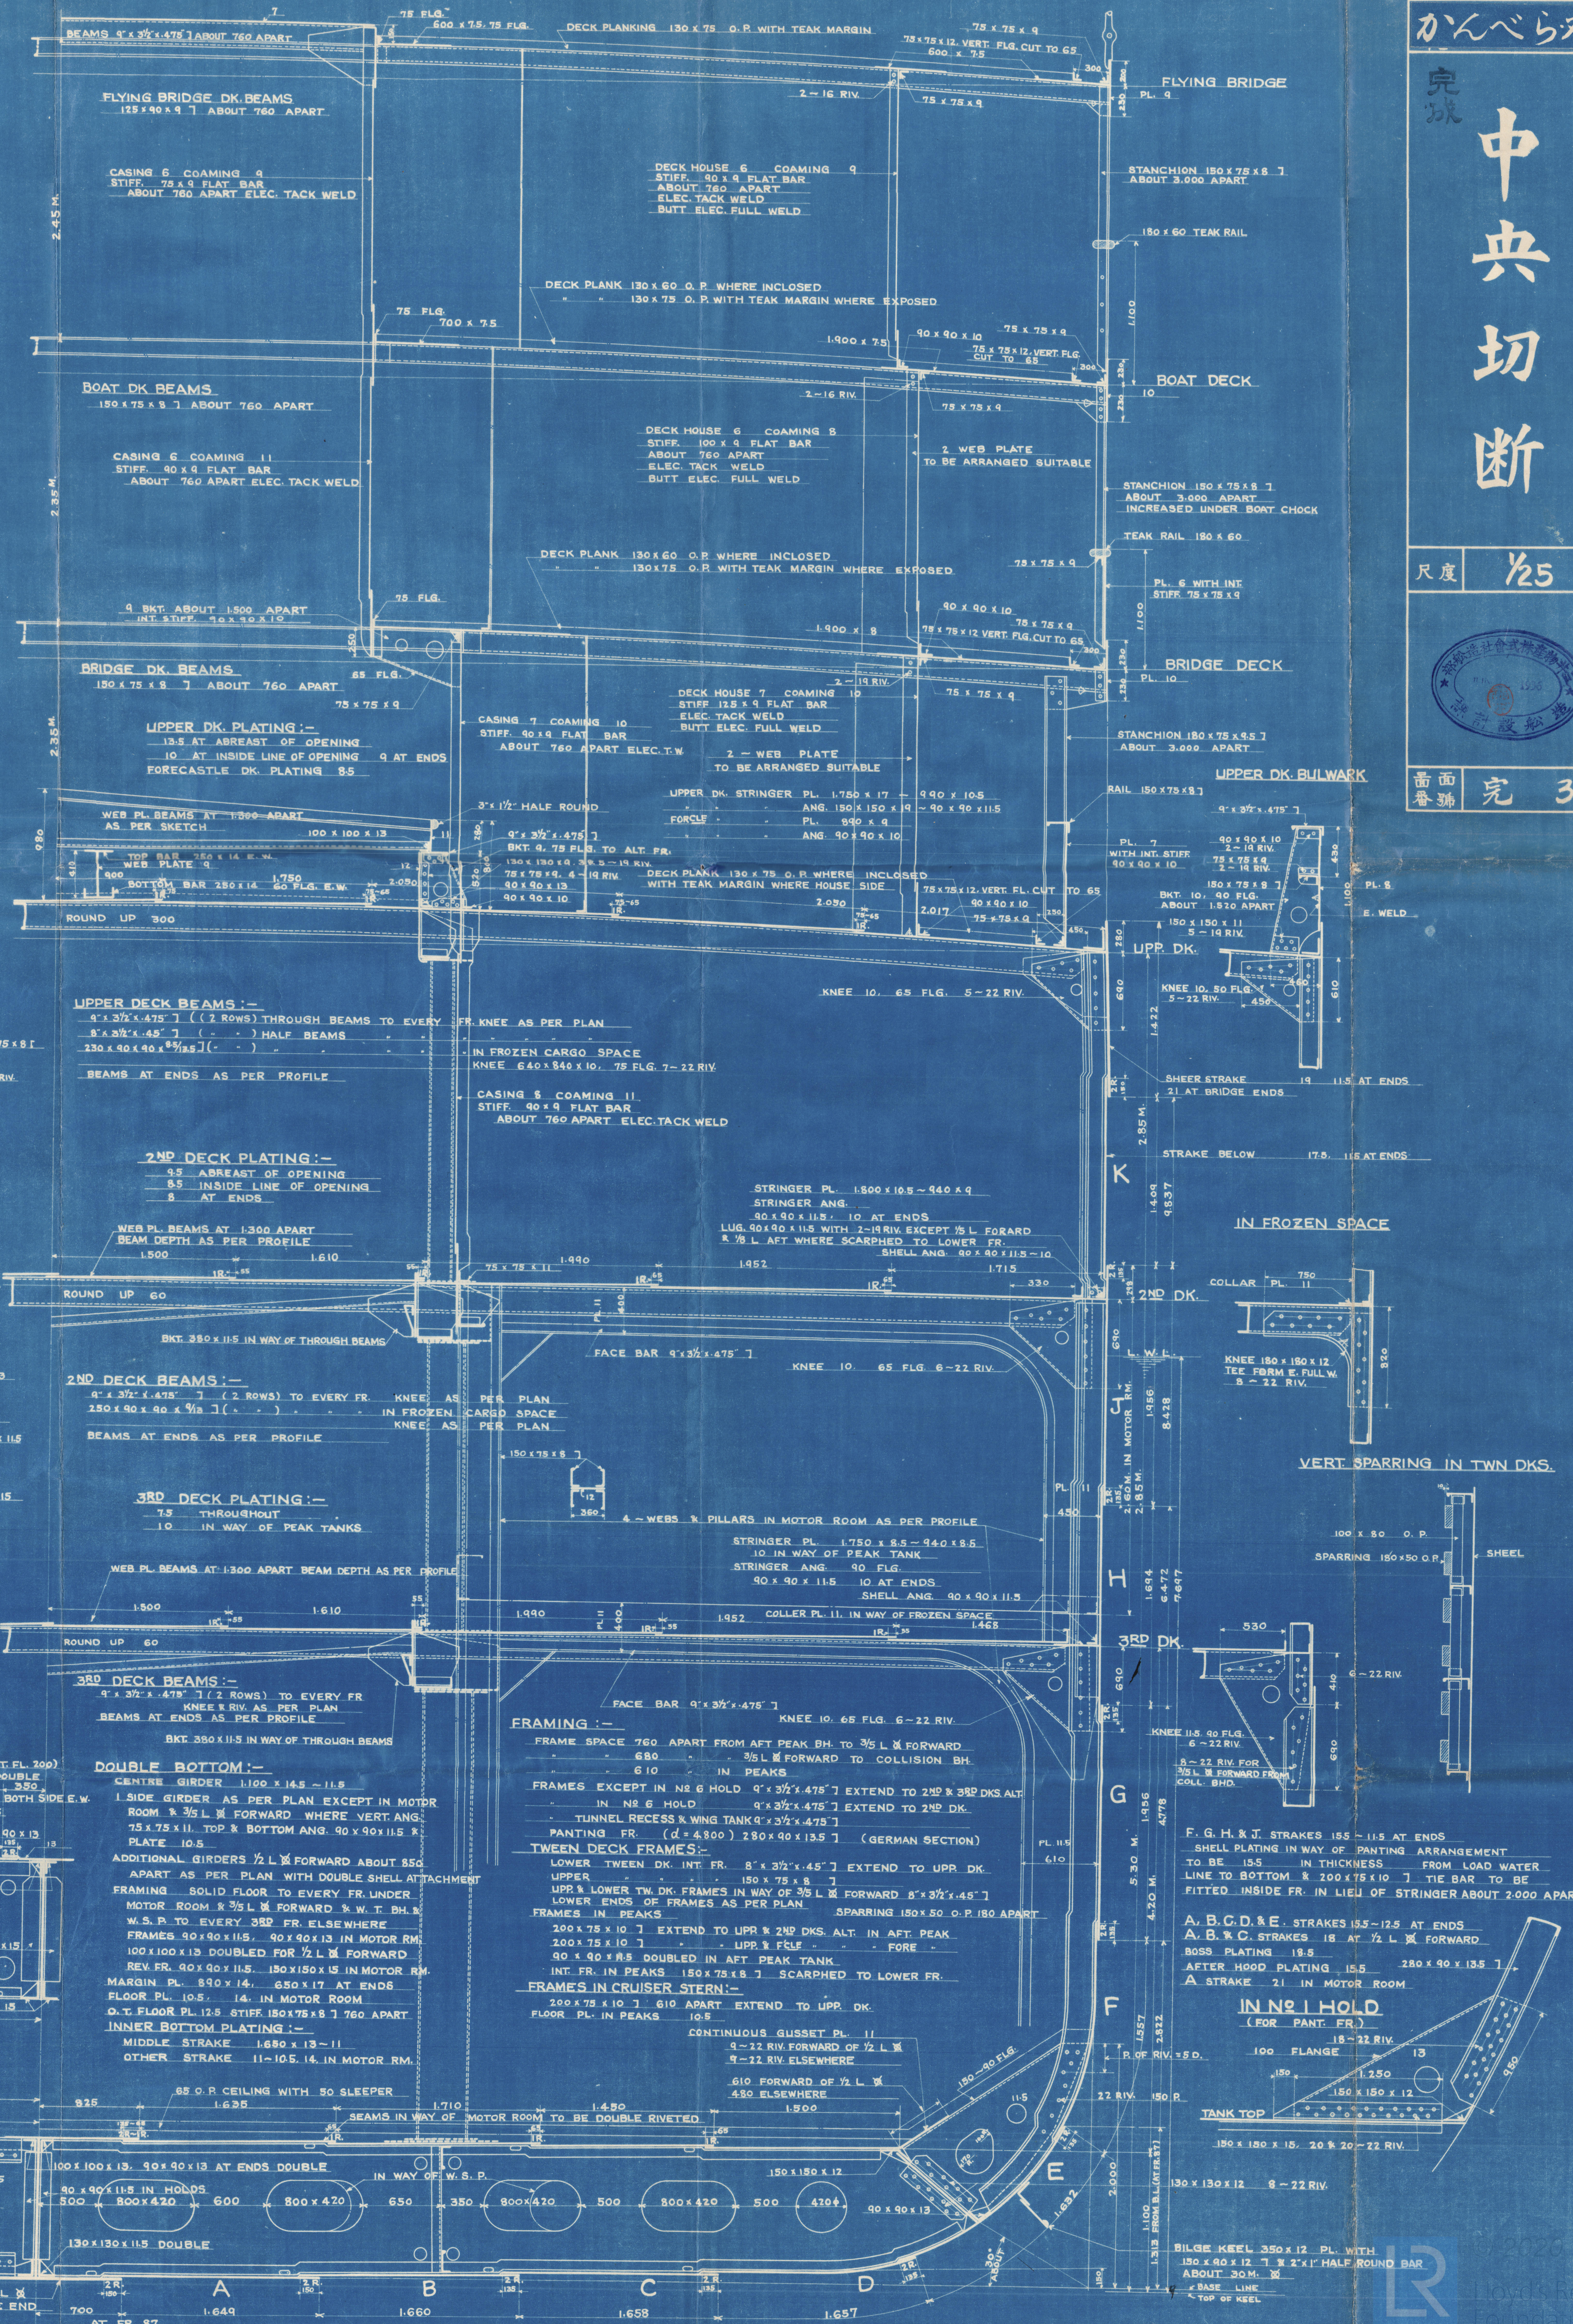

かんべら丸
中央切断
尺度 1/25
番面 完 3


かんべら丸

完成

中央切断

尺度

1/25

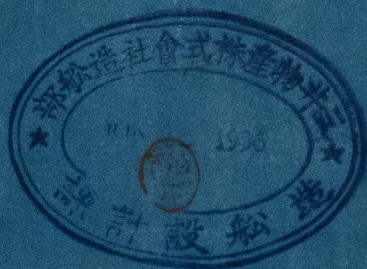

面番

完 3

Canberra Maru

Mid. Sec
(as built)

Koor Report 9607



© 2020

Lloyd's Register
Foundation

009469-009480-0250