

S.S. "BEATTY ROSE."

DIMENSIONS: 220'-0" x 34'-0" x 15'-6" MOULDED.

SCALE 1/2" = ONE FOOT.

CLASSED 100A1 AT LLOYD'S AND BUILT UNDER SPECIAL SURVEY.


S.S. "HAIG ROSE."



TRANSVERSE N° (B+D) = (34+15.5) = 49.5.
 LONGITUDINAL N° L (B+D) = 220(34+15.5) = 10880.
 A. TO MAIN DECK IN WAY OF D.B. (32" HIGH) = (15.5-2'6") = 12'84".
 Q. TO QUARTER DECK IN WAY OF D.B. (32" HIGH) = (19.5-2'6") = 16'84".
 Q. TO QUARTER DECK IN WAY OF ORDINARY FLOORS = (19.5-1'6") = 17'84".
 D IN L. MAIN DECK = 14'19".
 D IN L. QUARTER DECK = 11'28".

10890
 RAISED QUARTER DECK 10'0" x 4'0" ABOVE MAIN DECK = 428
 BRIDGE DECK 3/4" x 15'4" x 7'0" ABOVE MAIN DECK = 80'49"
 FORECASTLE DECK 3/4" x 22'0" x 7'0" ABOVE MAIN DECK = 115'50"
 CASING 1/2" x 55'7" x 7'0" ABOVE QUARTER DECK = 194'53"
 11'08'52".

MAIN & QUARTER DECK BEAMS 6" x 3" x 30' B.A.
 MAIN & QUARTER DECK CARLINGS 6" x 3" x 30' ANGLE
 FORECASTLE DECK BEAMS 5" x 3" x 44' ANGLE
 FORE PEAK BEAMS 5" x 3" x 34' ANGLE
 BRIDGE DECK BEAMS 5" x 3" x 40' ANGLE

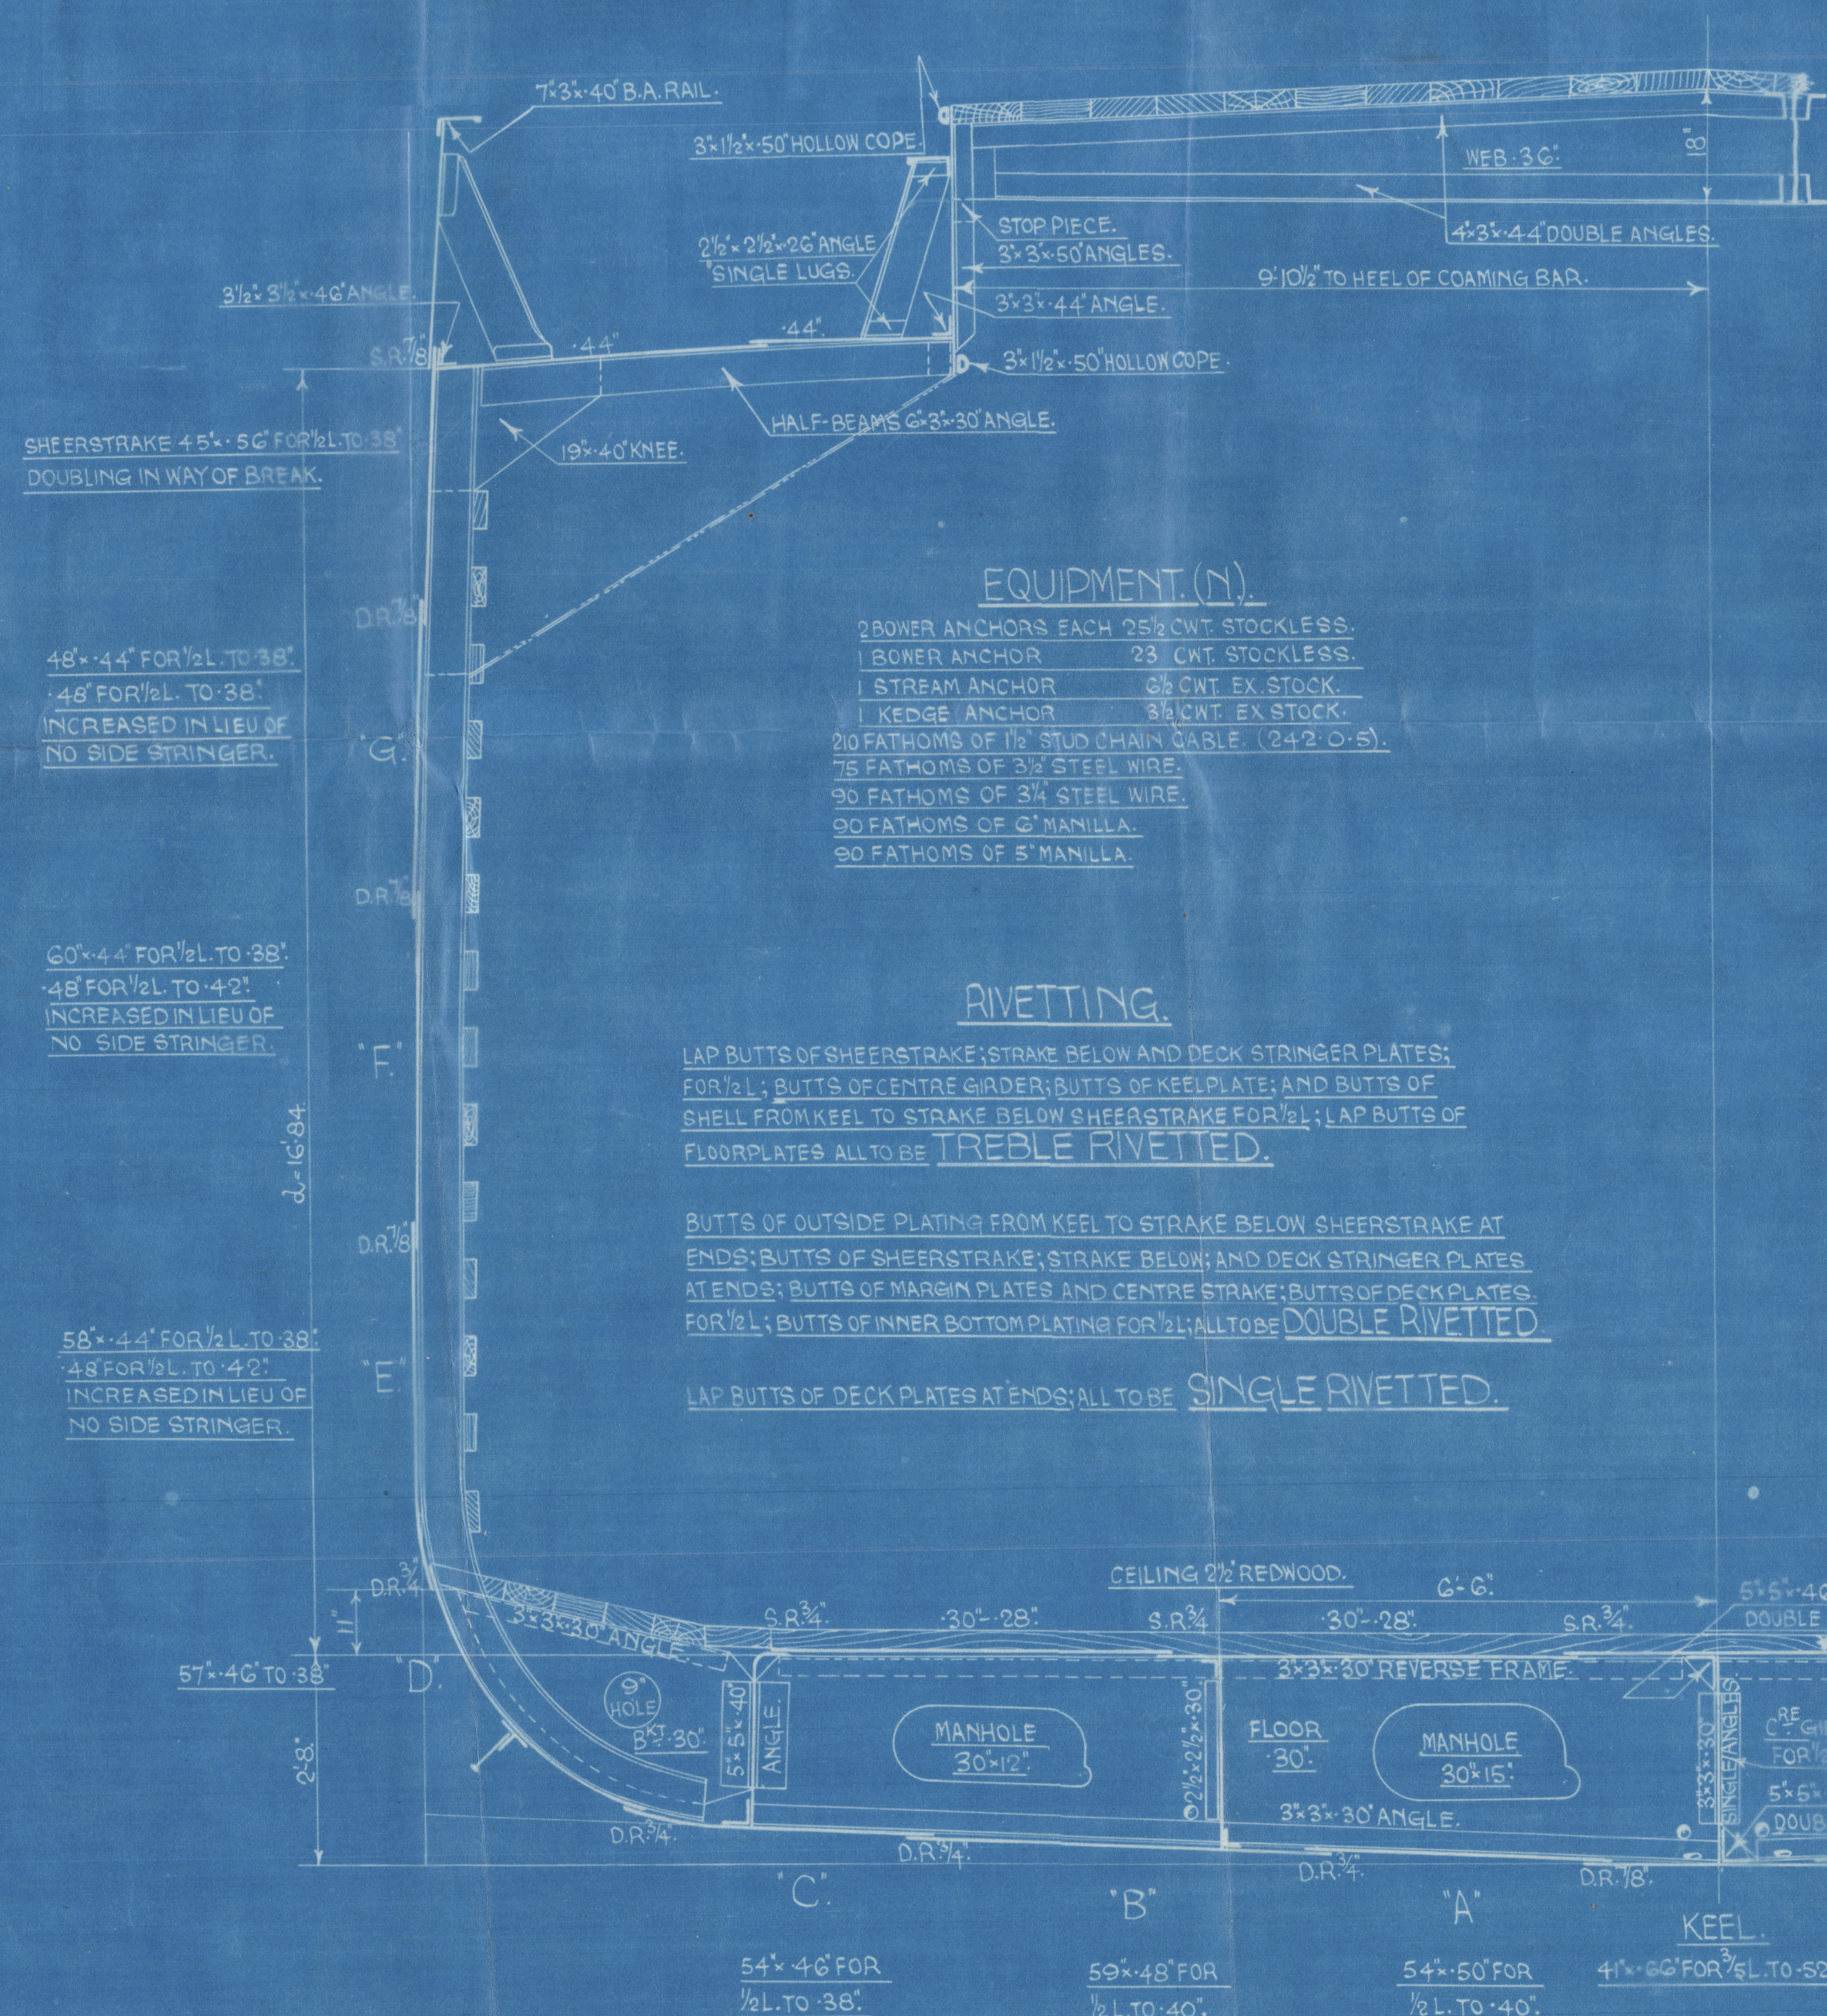

Midship Section

as built.

"Haig Rose"

J Fullerton vol No 267.

GLASGOW REPORT No. 40748

Plans Transferred
To SV Bonchita



© 2020

Lloyd's Register
Foundation

009557-009564-0267