

S467 A/MS No 1113

S468 A/MS No 1114


S469 A/MS No 1115

31 AUG 1945

EMPIRE SEAFRONT

EMPIRE SEABOY

EMPIRE SEABREEZE

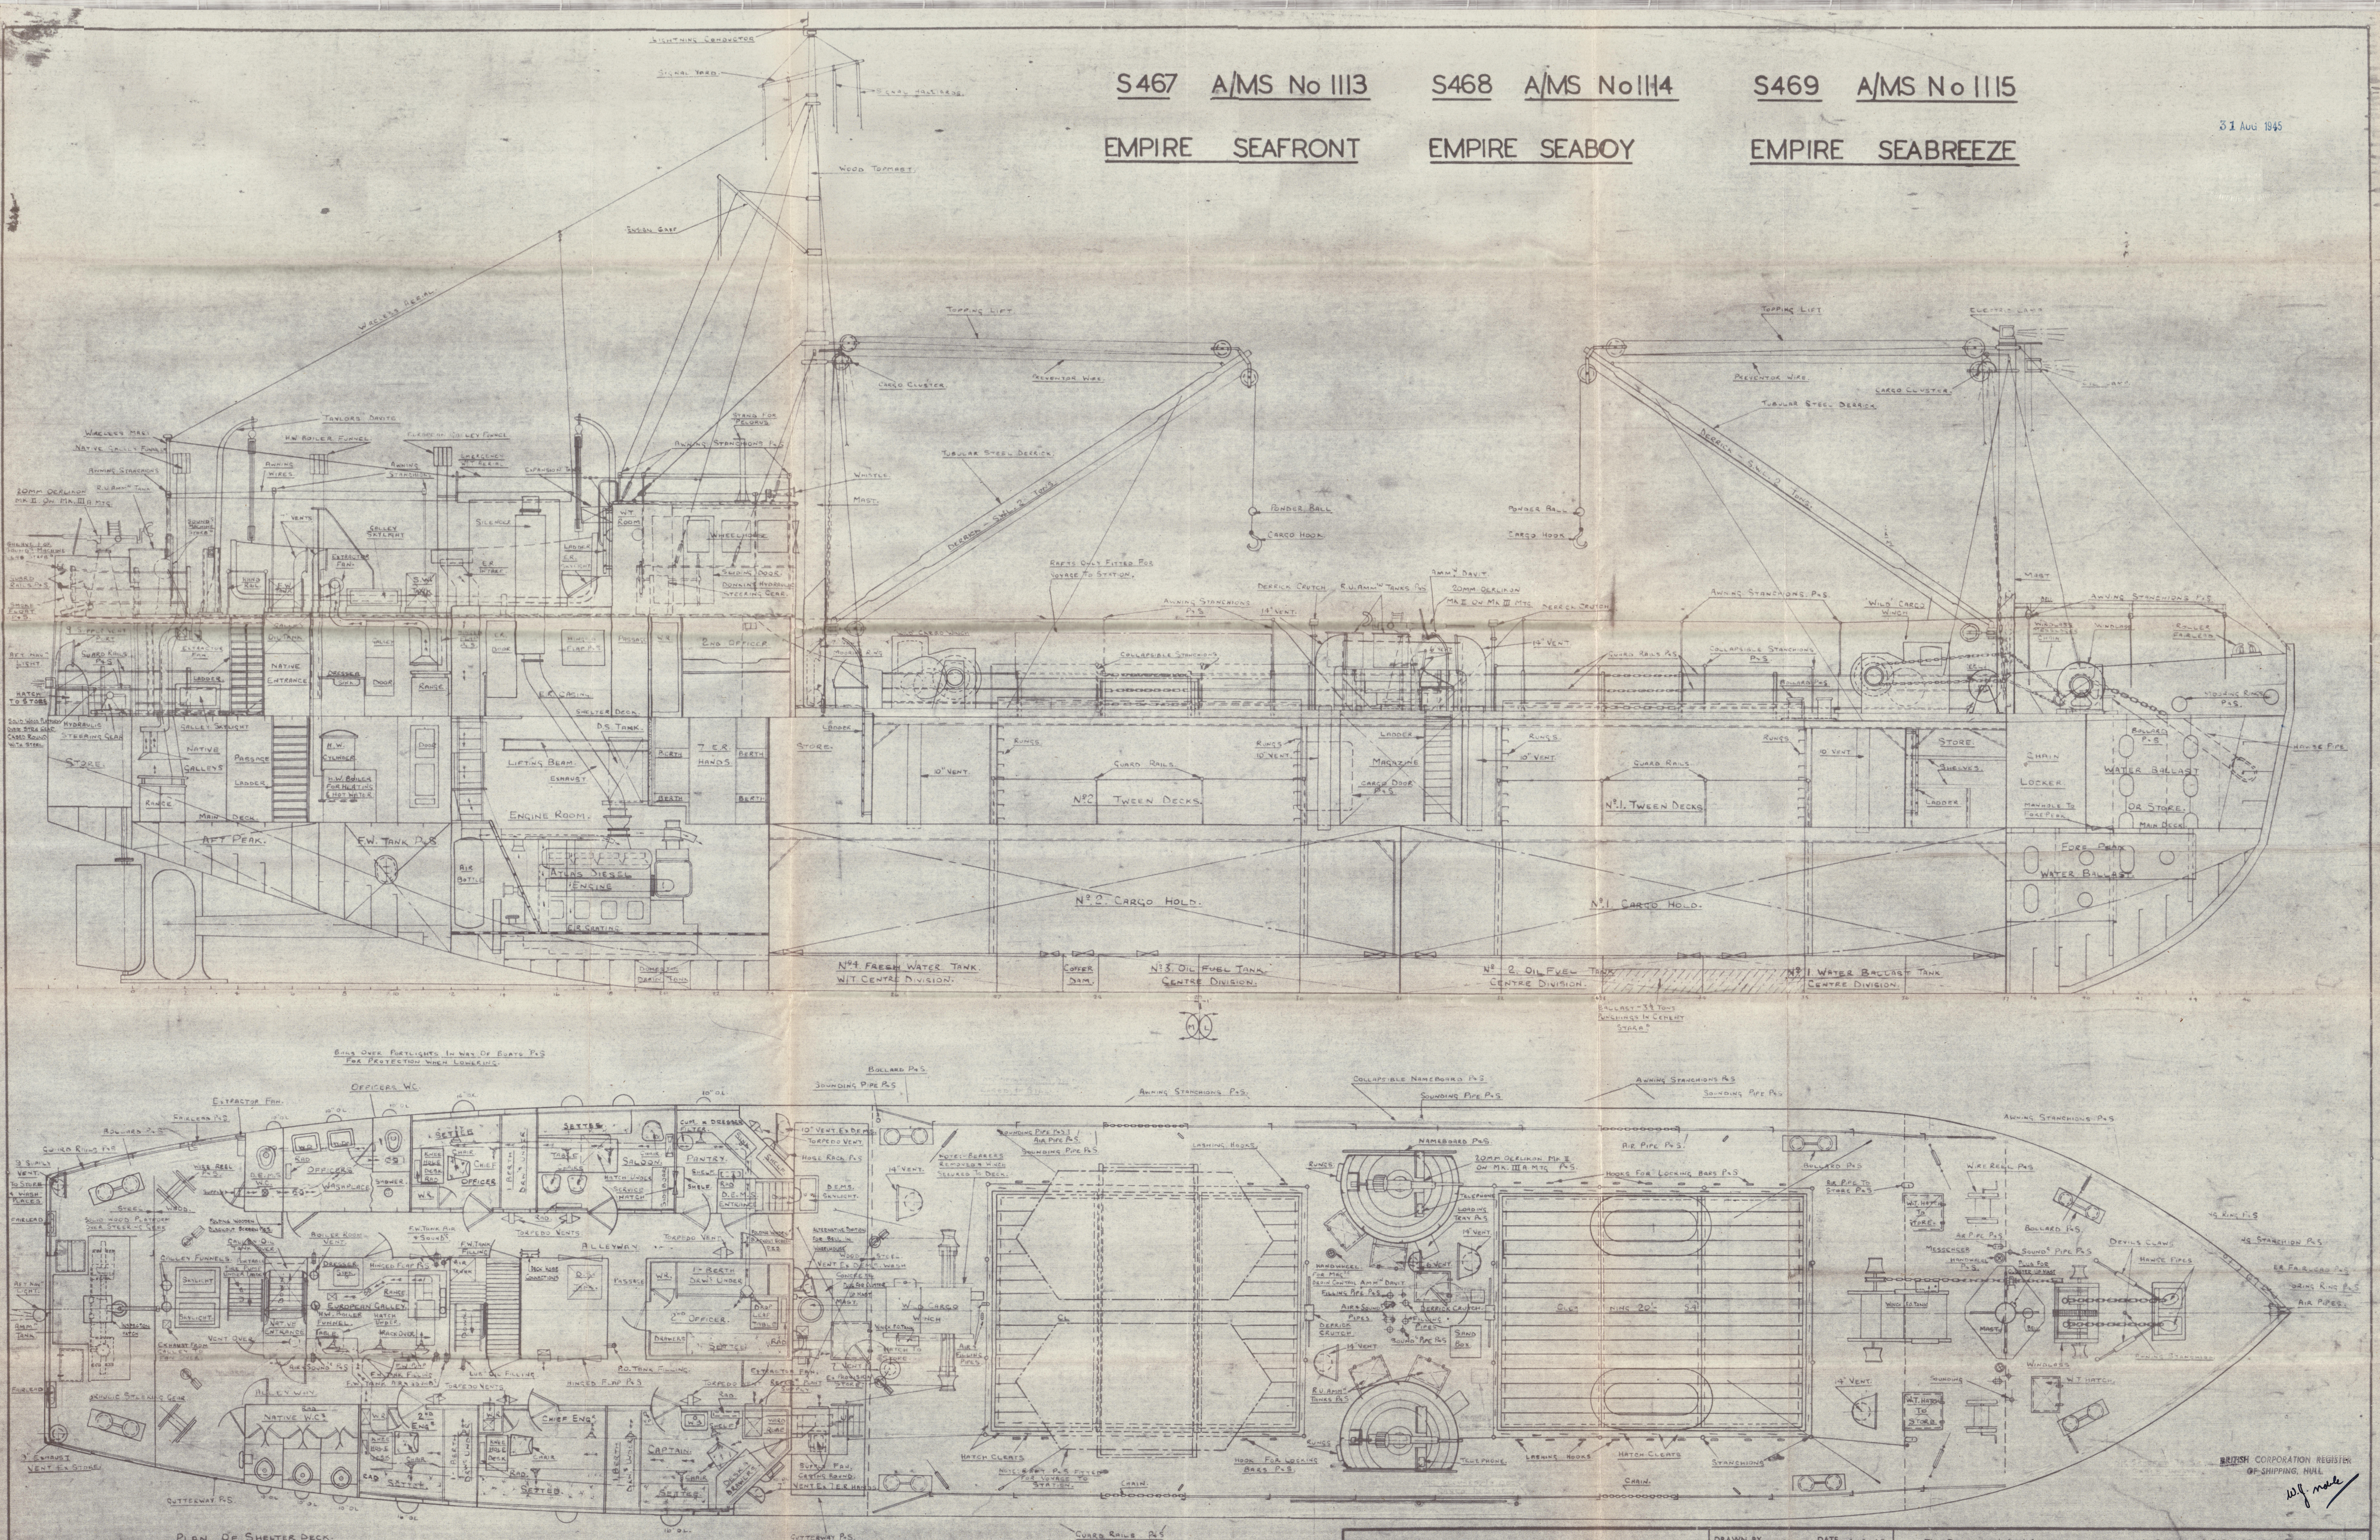

"EMPIRE SEAHAWK"  
AMS NO 1112

DIMENSIONS.  
LENGTH O.A. 145' - 1'  
LENGTH B.P. 141' - 0'  
BREADTH MLD. 27' - 0'  
DEPTH MLD. 11' - 0'

RICHARD DUNSTON LTD.

SHIPBUILDERS,  
THORNE, YORKSHIRE

DRAWN BY	DM	DATE	18-3-45
TRACED BY	DM	DATE	20-3-45
CHECKED BY	AKR	DATE	21-3-45
REVISIONS			
No.	DATE	PARTICULARS	

This Drawing and the information it contains are the Property of RICHARD DUNSTON LTD. It is not to be Traced, Copied or Published without their Written Consent, nor is the information thereon to be misused in any way.	
YARD No. S466	DRG. No. 4500/278/2
TITLE - GENERAL ARRANGEMENT (AS FITTED)	
SCALE - 1/4" TO ONE FOOT	



1

General Cargo [Profile]

R. Dunston Ltd

No 5469.

As built

EMPIRE SEABREEZE NOW SENRI.



© 2020

*Seabreeze  
469*

Lloyd's Register  
Foundation