


26-7-52

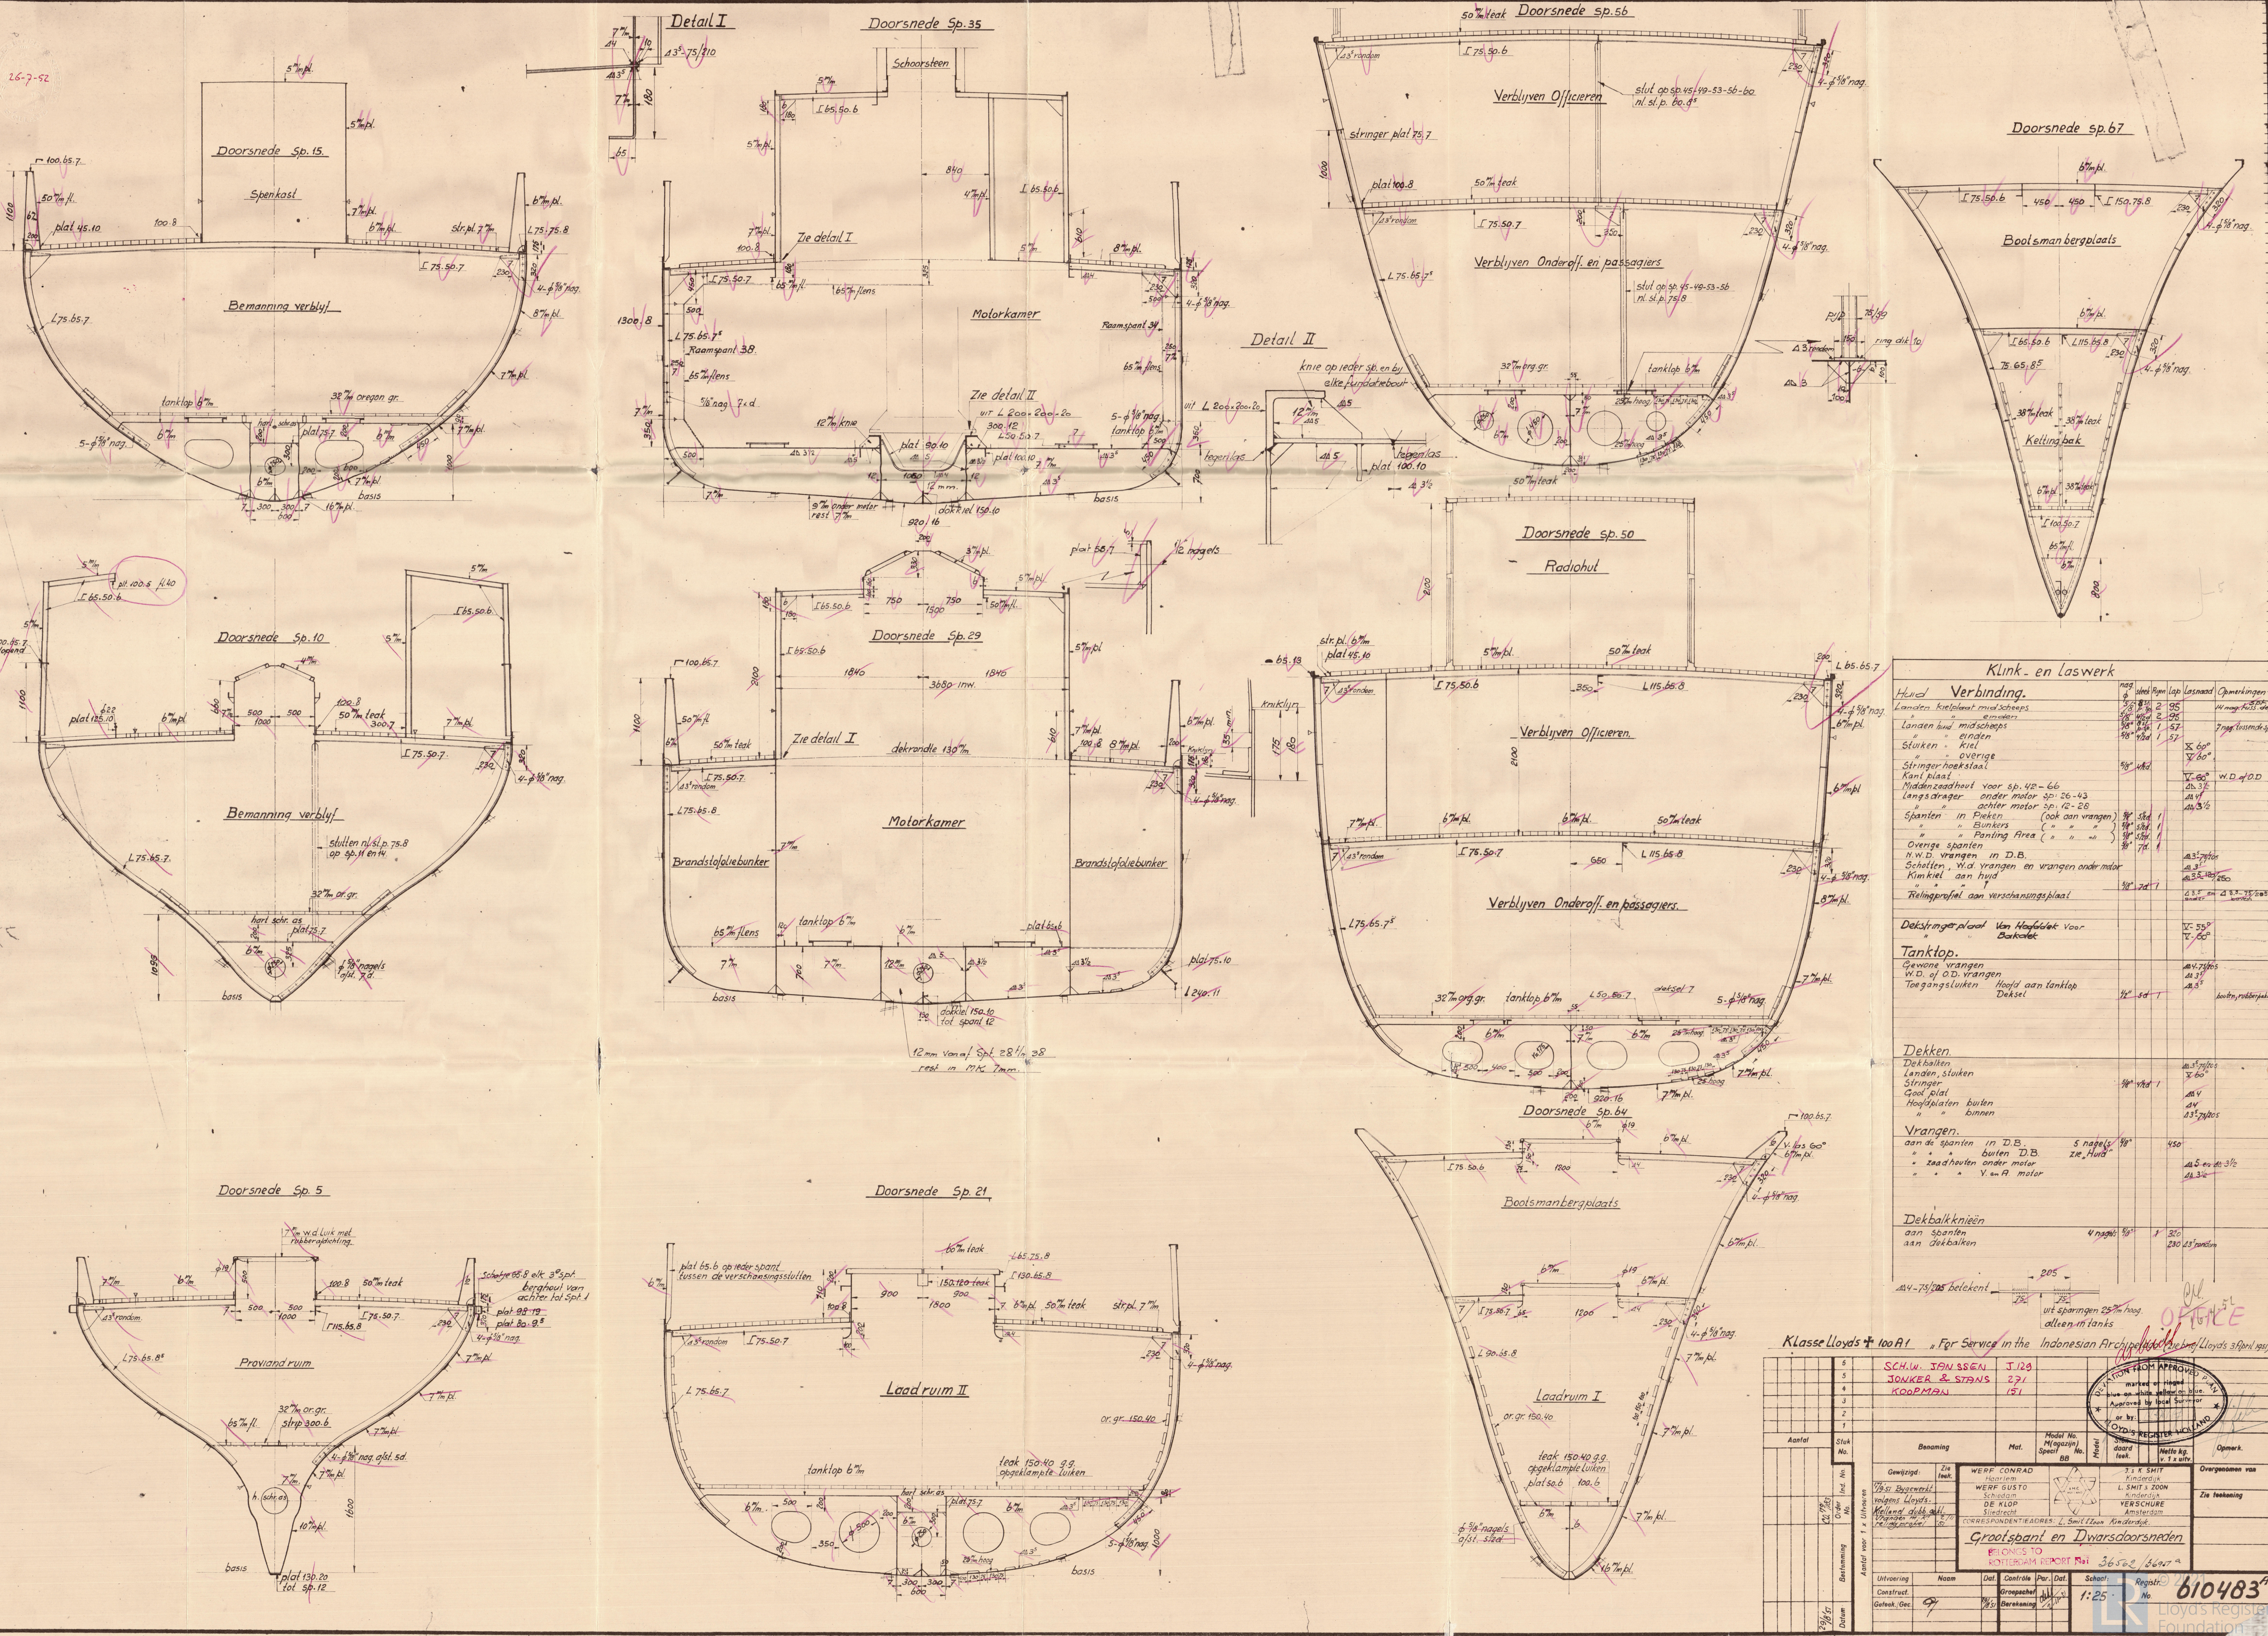

OFFICE


610483^A

Lloyd's Register
Foundation


Midship section + cross sections
(as built)

★ BAJAN

RECORDS DEPT.
LONDON

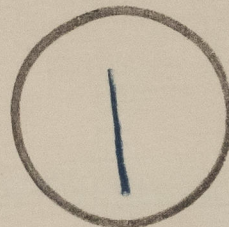

009888 - 009895 - 0089

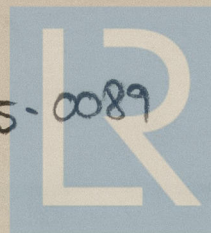

© 2021

Lloyd's Register
Foundation