

MIDSHIP SECTION.

AS BUILT (See F.E. Rpt)
SCALE $\frac{1}{2}" = 1 \text{ FOOT}$

CLASS :- LLOYDS 100 A.I.✠

DIMENSIONS :- 310'-0" LENGTH B.P. x 46'-4" BREADTH MLD. x 25'-2" FLAT SHEER TO UPPER DECK, 34'-2" FLAT SHEER TO BRIDGE DECK.
24'-6" NORMAL SHEER TO UPPER DECK, 33'-6" NORMAL SHEER TO BRIDGE DECK.

LLOYDS NUMERALS (TO NORMAL SHEAR).


1 ST LONGITUDINAL N ^o L × D ÷ 310' - 0" × 24.5 =	7,595
2 ND LONGITUDINAL N ^o L × (B+d) ÷ 310 × (46.33 × 24.5) ÷	21,957.3
$\frac{1}{2}$ TO UPPER DECK ÷ 310 ÷ 24.5	12.65
$\frac{1}{2}$ TO BRIDGE DECK ÷ 310 ÷ 33.5	9.25
d ÷ 24.50 - 3.08	21.42
PERCENTAGE OF ERECTIONS	43.

	EQUIPMENT NUMBER	
L = (B + D)	= 310 + (48.33 + 24.5)	= 21,957.3
POOP	= .75 + 30.7 + 7.75	= 178.4
BRIDGE	= .75 + 76 + 9	= 513.0
FORECASTLE	= .75 + 31.5 + 7	= 164.3
CASING + HOUSE	= .5 + 68 + 7.5	= 247.5
POOP DECK HOUSE	= .5 + 29 + 7.5	= 106.8
CHART ROOM	= .5 + 10.5 + 7.5	= 39.4
LETTER "U"		23,208.7

EQUIPMENT	
2 POWER ANCHORS (STOCKLESS)	45 CWTs.
1 STREAM ANCHOR (EX. STOCK)	12 CWTs.
225 FATHOMS STUD CHAIN CABLE	1 ¹⁵ / ₈ "
90 FATHOMS STREAM STEEL WIRE	4 1/ ₄ "
100 FATHOMS TOWLINE STEEL WIRE	4"
2 @ 90 FATHOMS HAWSERS STEEL WIRE	2 1/ ₂ "
2 @ 80 FATHOMS WARPS MANILLA	6"

33 @ .35" POOP
 SIDE PLATING 3/4" BUTTS & SEAMS SINGLE RIVETED
STRINGER ANGLE 3" x 3" x 5/16"
STRINGER PLATE 30" x 3/8" .35"
DECK PLATING .30" EXPOSED AND .25" SHEATHING.

FORECASTLE
SIDE PLATING .38" BUTTS & SEAMS SINGLE RIVETED
STRINGER ANGLE 3" x 3" x 5/16"
STRINGER PLATE & DECK PLATING .40"
.35" STRINGER & .30" + .35" DECK PLATING.

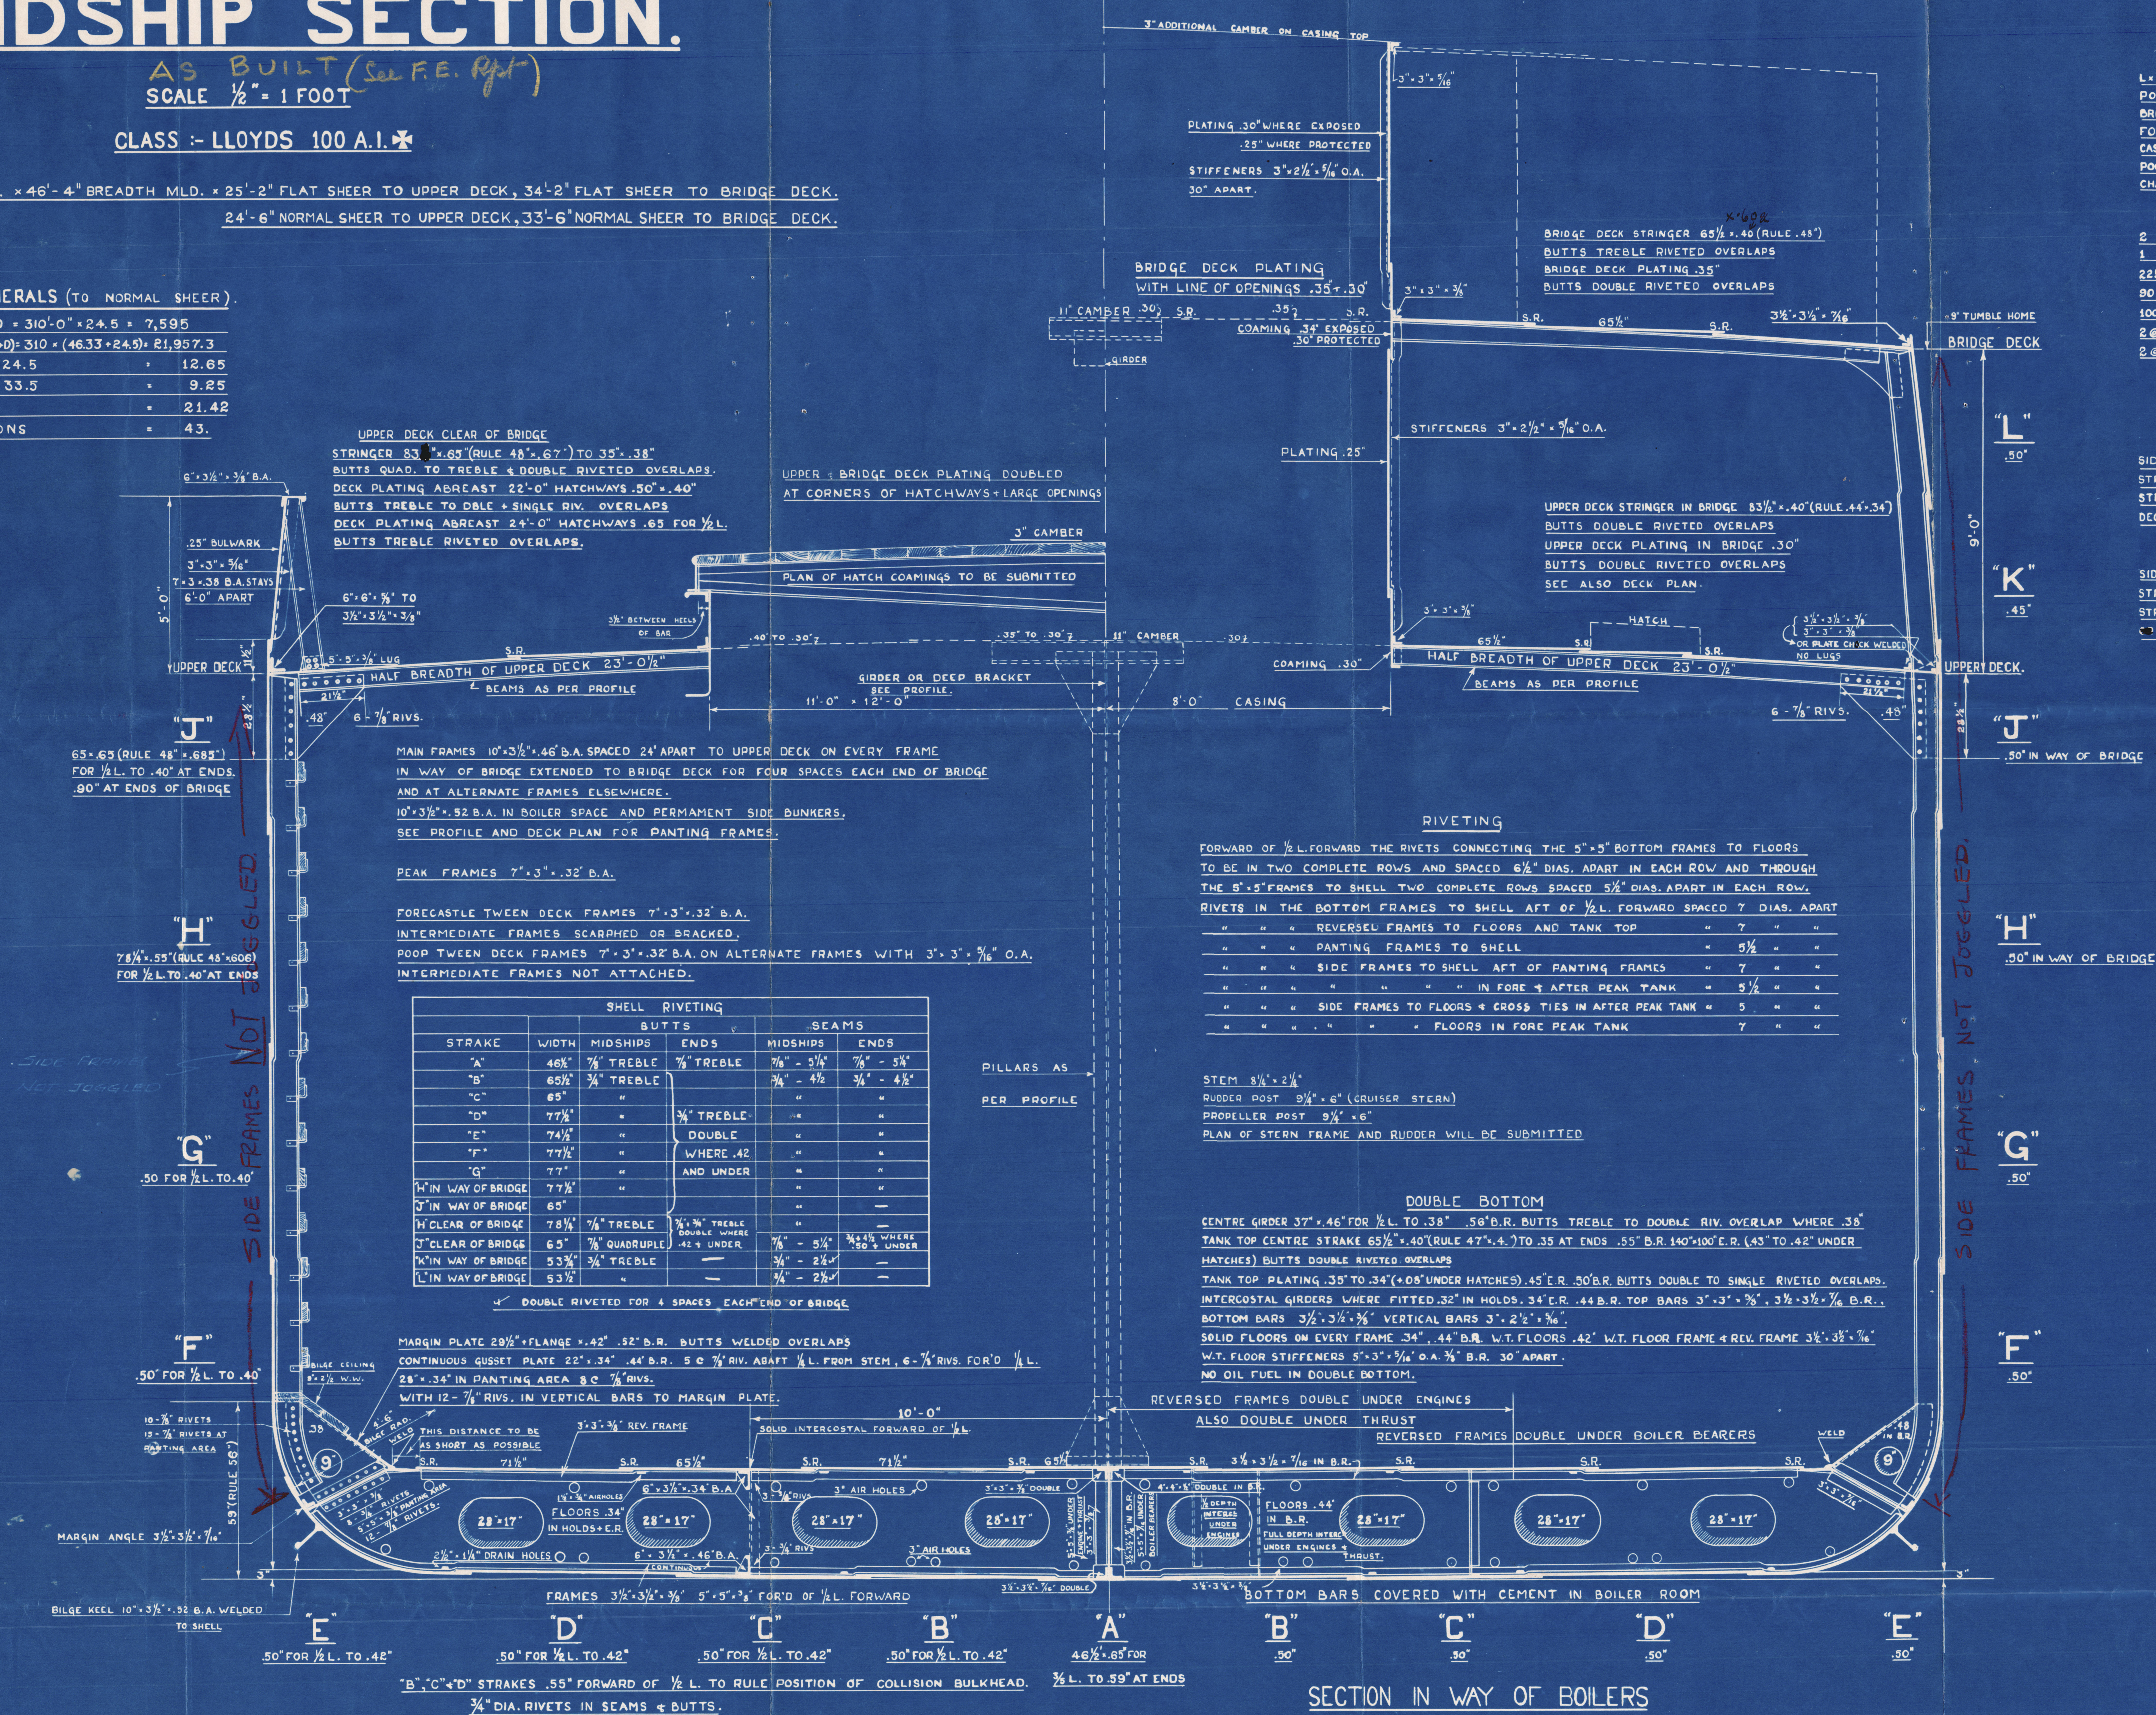

SECTION IN WAY OF BOILERS

ST. JOHN DRYDOCK & SHIPBUILDING CO LTD EAST SAINT JOHN, N.B.	
SHIP <u>S.S. ROCKWOOD PARK.</u>	
PLAN <u>MIDSHIP SECTION</u>	
SCALE: $\frac{1}{2}" = 1'-0"$	DATE
DRAWN BY: J.D.	APPROVED BY:
TRACED BY	
CHECKED BY	
DWG. NO <u>H/9/2</u>	

~~LA GRANDE HERMINE~~

S. S. "ROCKWOOD PARK"

HULL No. 14

BUILT BY

ST. JOHN DRY DOCK & SHIPBUILDING CO.
SAINT JOHN, N.B.

FIRST ENTRY REPORT

ST. J. No. 313.

MIDSHIP SECTION.

AS BUILT (See FERpt page 4)

EX "VIANNA"
N.N.

NN. "Cap Falcon"



© 2021

Lloyd's Register
Foundation

009954-009961-0053