


Nº1519

PROFILE & DECKS

DIMENSIONS:- 425'-0" B.P. x 54'-3" M.L. x 31'-0" D.M.L. TO U.D.K.

SCALE:- 1/16" = 1 FOOT

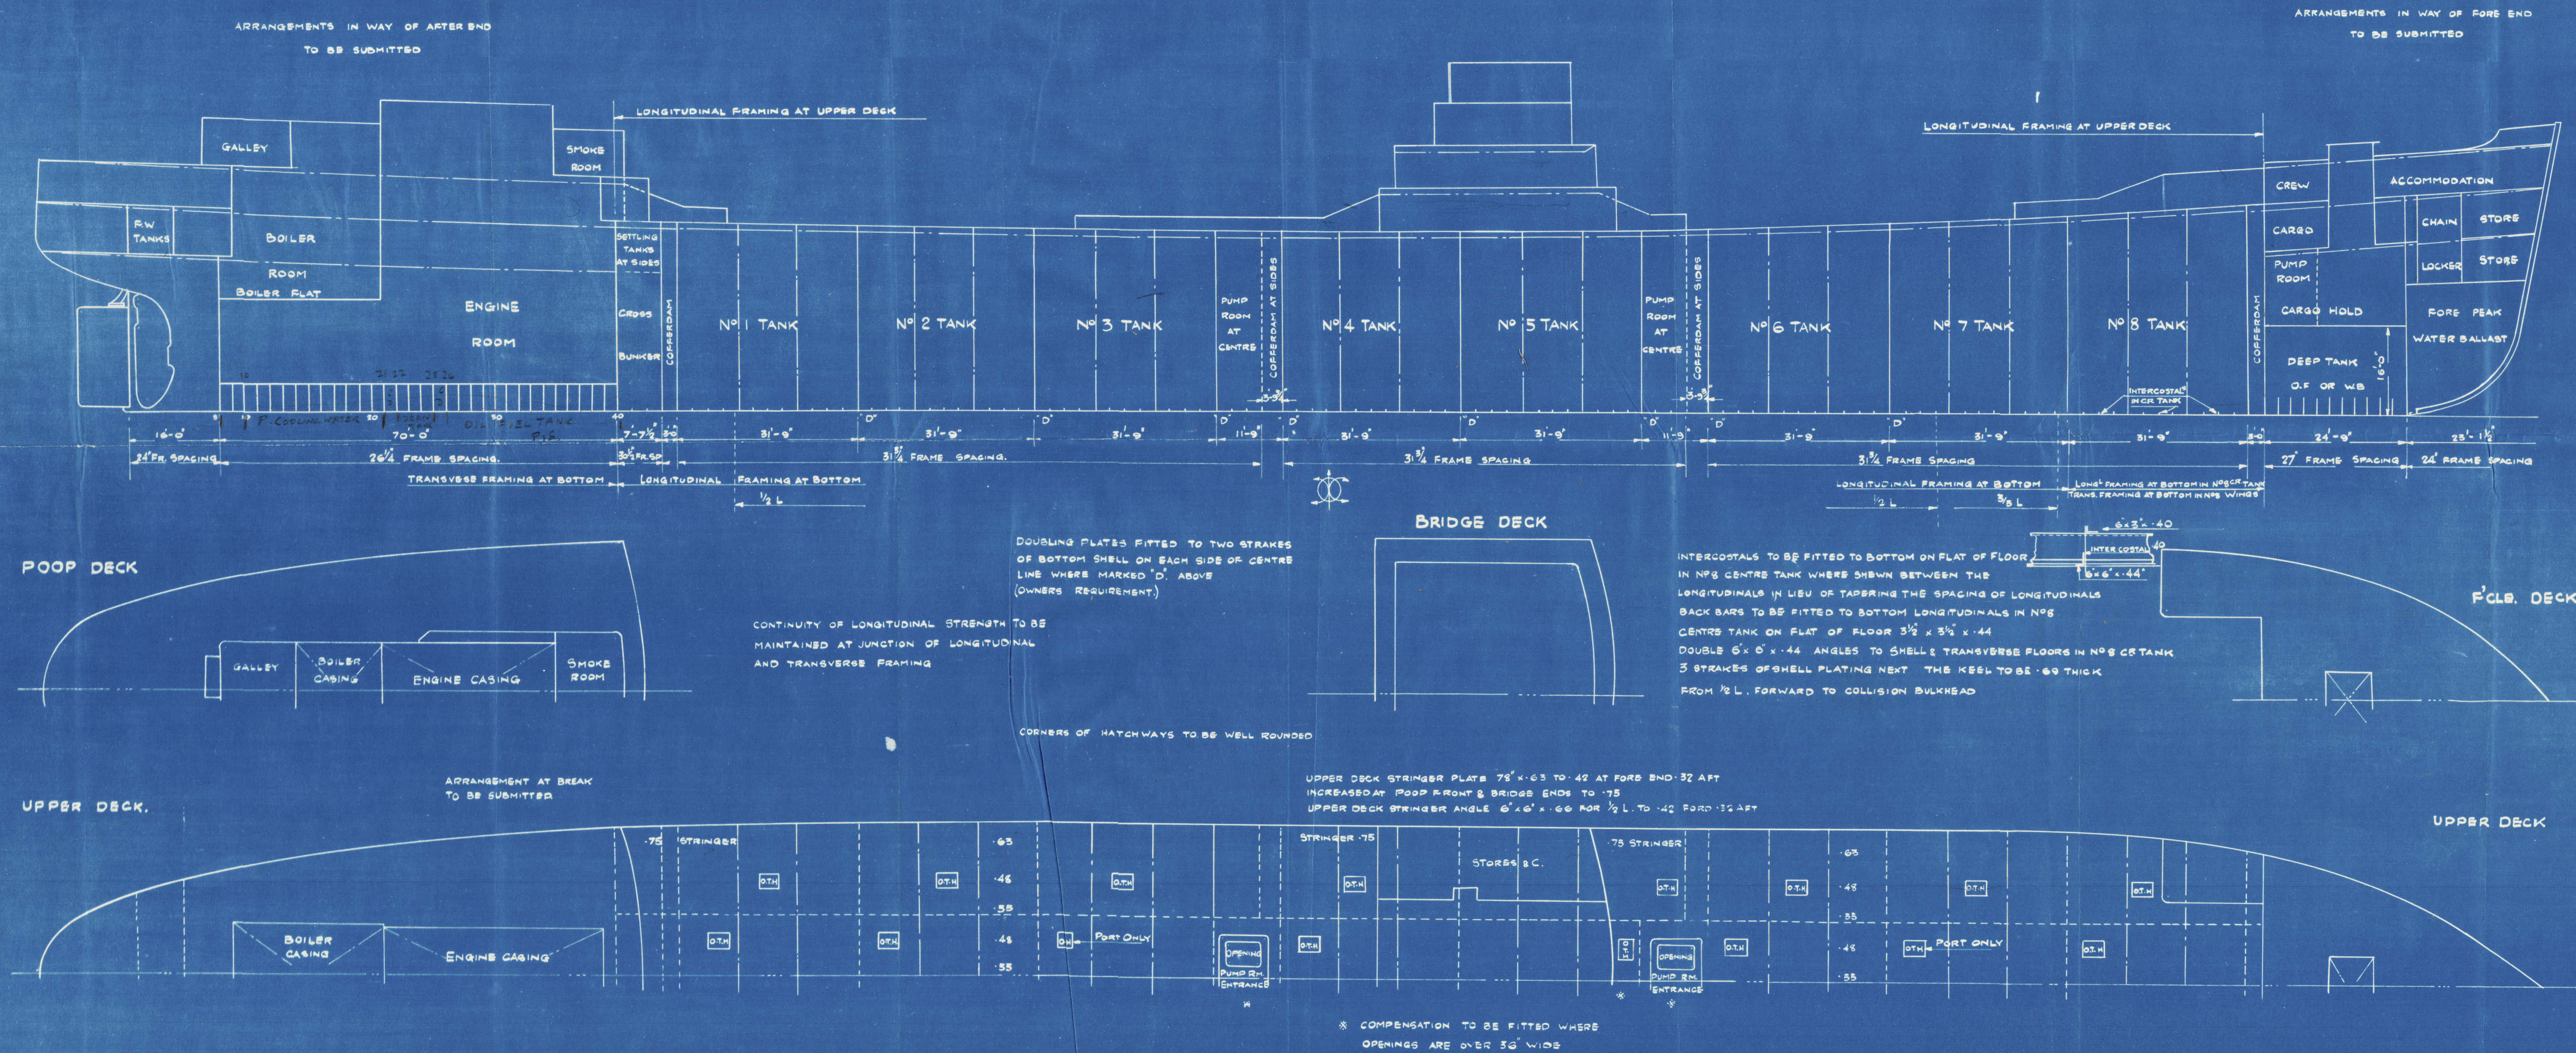

Swan Hunter's No 1519

M.S. "Sepia" X


Profile & Deck
as Built

39

S.S. "SEPIA"

NEWCASTLE ON TYNE.

Report No. 94319

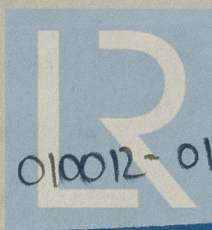

© 2021

010012-010023-0204

Lloyd's Register
Foundation