

# MIDSHIP SECTION

## Nº 614.

DIMENSIONS 331-0 B.P. x 46-6 MLD. x 25-6 MLD.



SCALE 1/2 INCH = 1 FOOT.  
TO CLASS 100 A.1 AT LLOYDS.

### NUMERALS

BREADTH MLD. 46-6  
DEPTH MLD. 25-6  
TRANSIT NO. 720 1st No.  
LENGTH 331  
LONGIT. NO. 23832 2nd No.  
1/2 UPPER DECK 12-98  
1/2 BRIDGE DECK 10-03

RULE EQUIPMENT		
NUMERICAL	23832	
POOP BRIDGE & POLE 150-5-75-3	897	
CASING & HOUSES 60-75-17-95-4-1/2	203	
24991		
2 BOWER ANCHORS	45 CHTS. EACH	STOCKLESS
1 STEAM	12	EX STOCK
2 1/2 FATHOMS	1 1/2	STUD CHAIN CABLE
90	4 1/2	STEEL WIRE
100	4	
2 2 90	7	HANGERS & WARPS
2 3 90	6	

KEGGE ANCHOR DISPENSED WITH AND CABLE  
REDUCED AS A WAR EMERGENCY MEASURE.

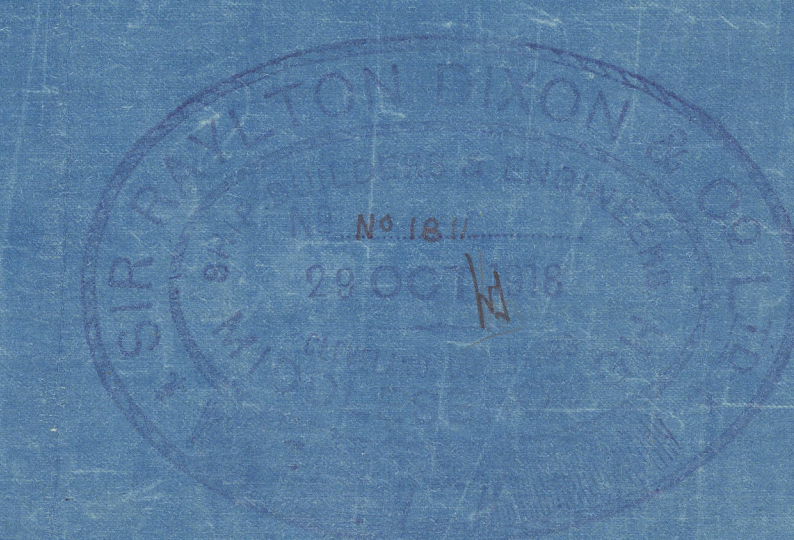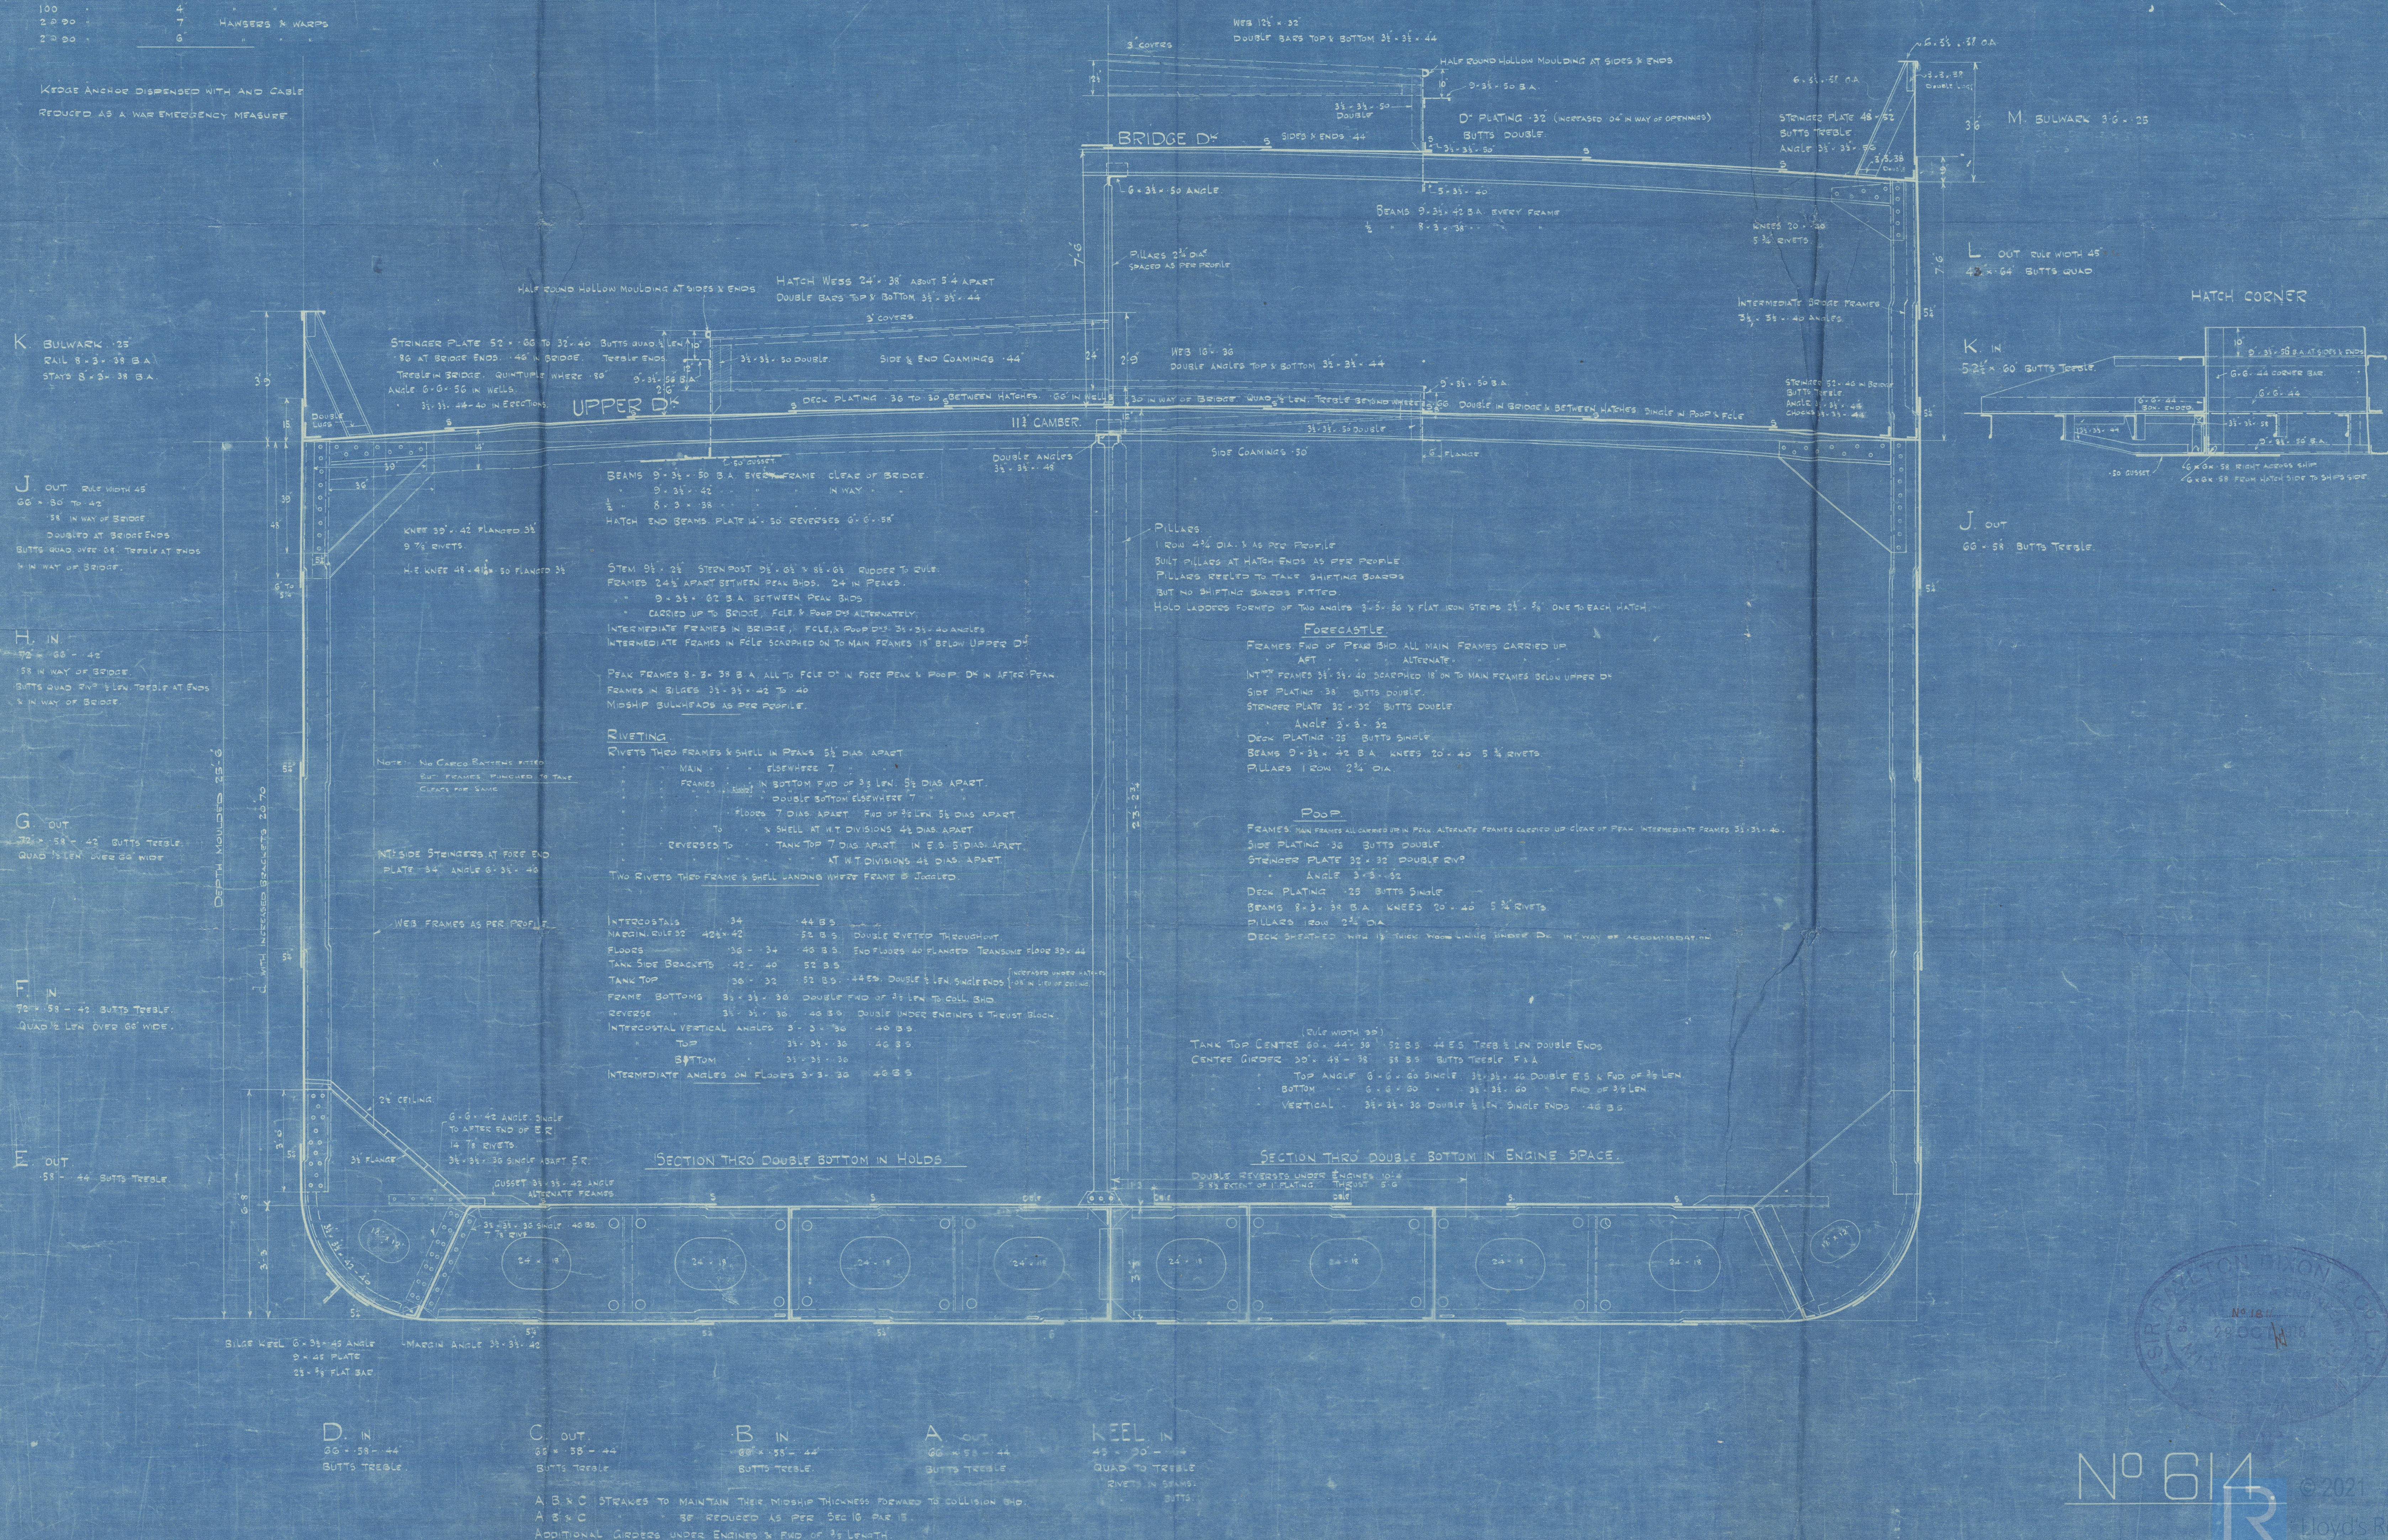



Messrs. Sir R. Dixon & Co<sup>s</sup>

N<sup>o</sup> 614


C TYPE STANDARD

"<sup>meteo</sup> S.S. WAR. TYPHOON"

MIDSHIP SECTION

(as built)

Drawn Rpt. No. ~~10240~~  
10241.

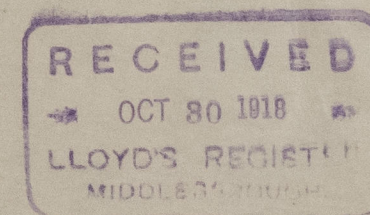

© 2021

Lloyd's Register  
Foundation