
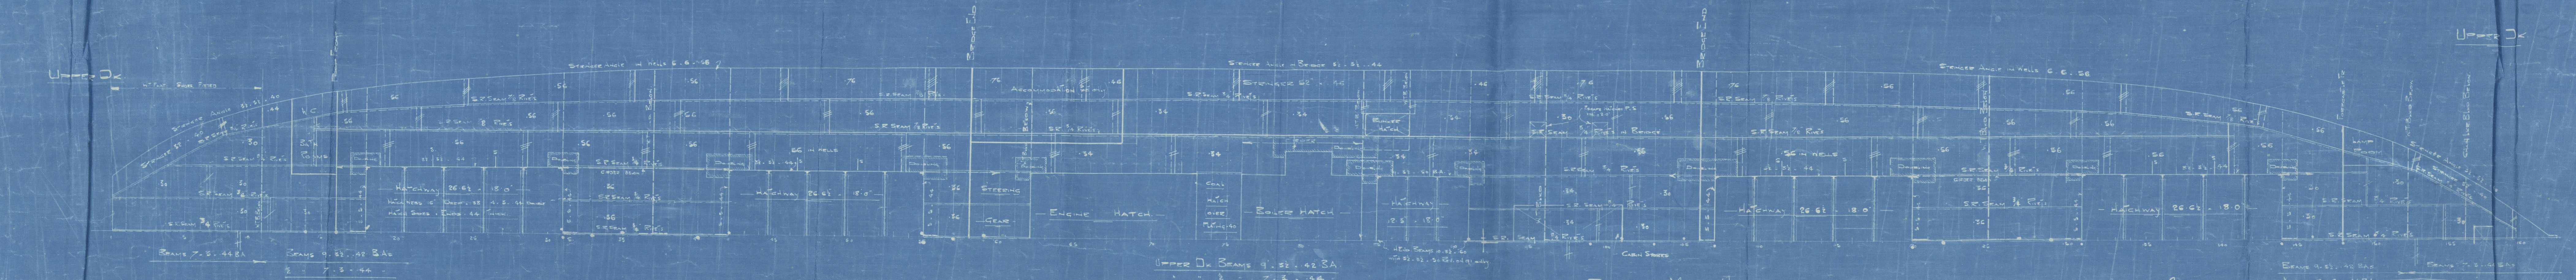
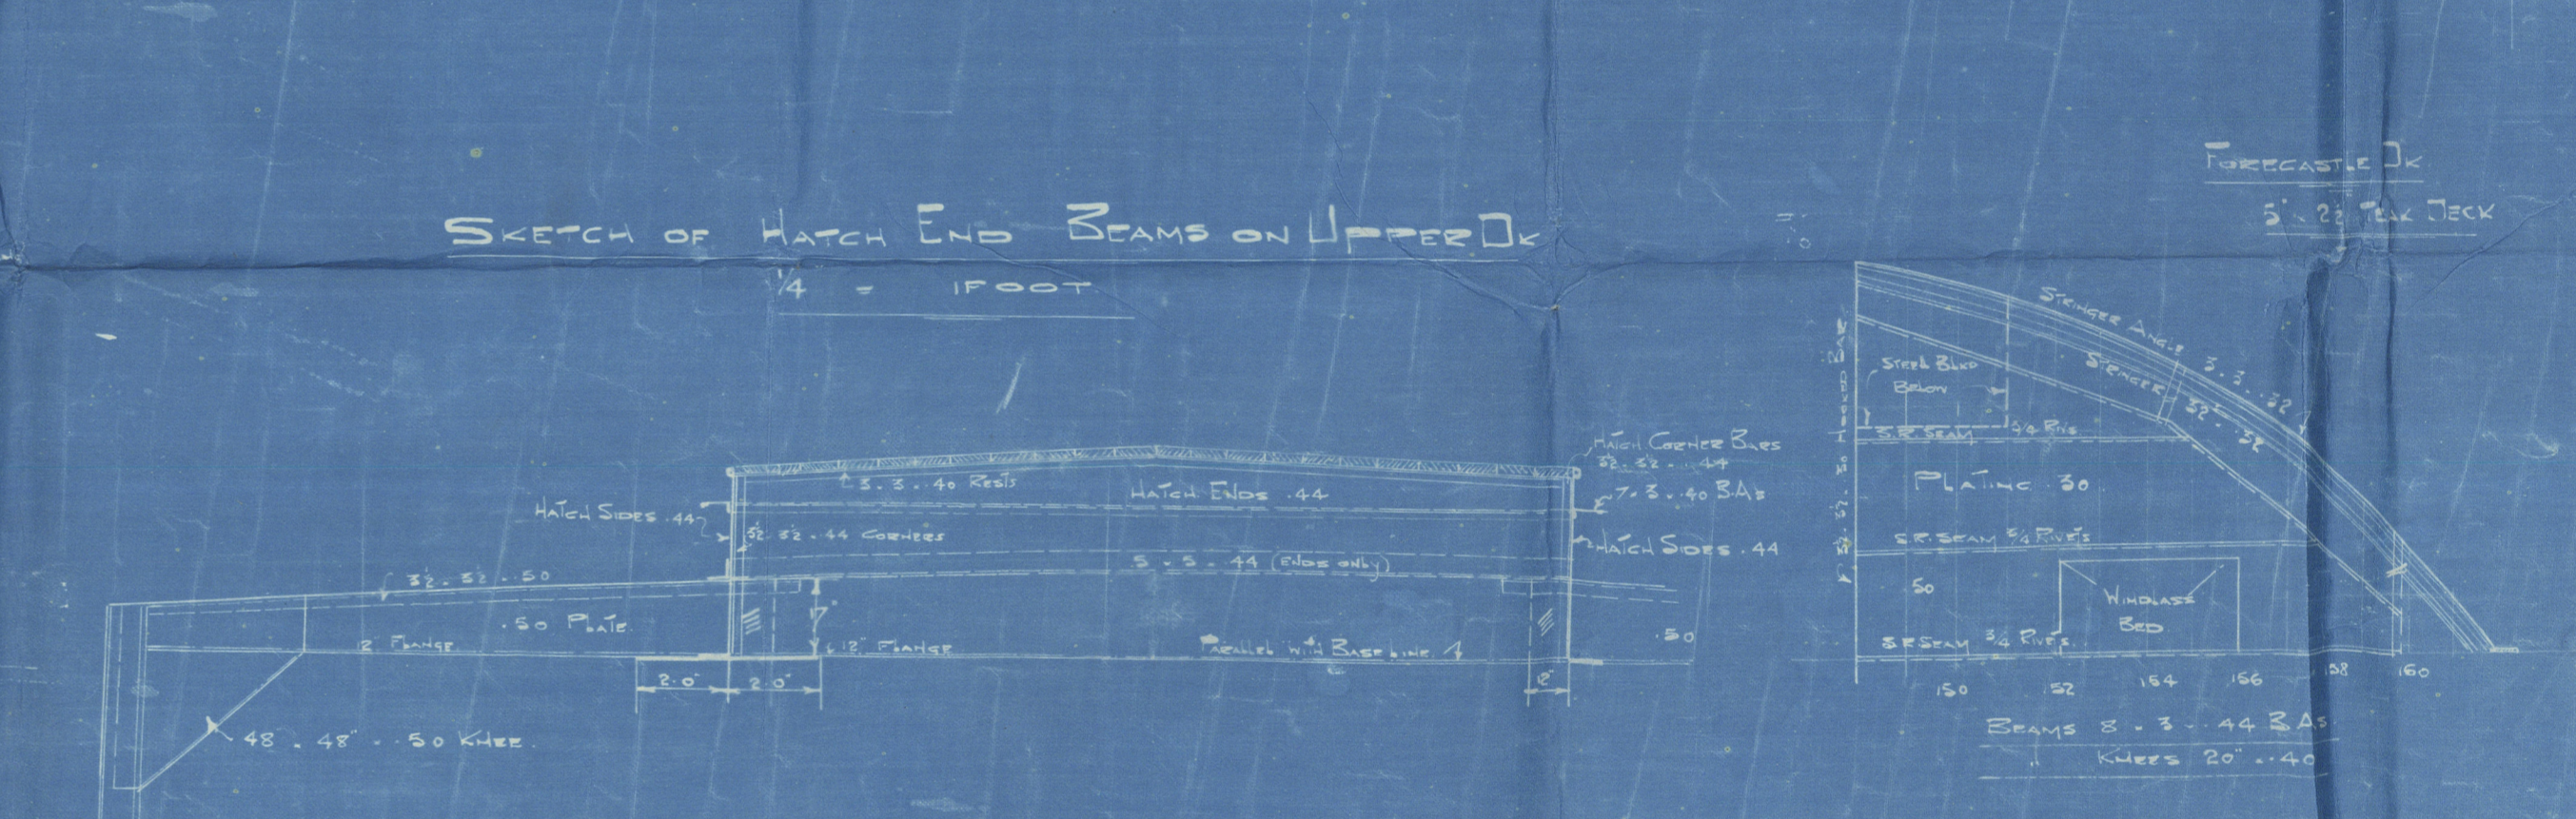
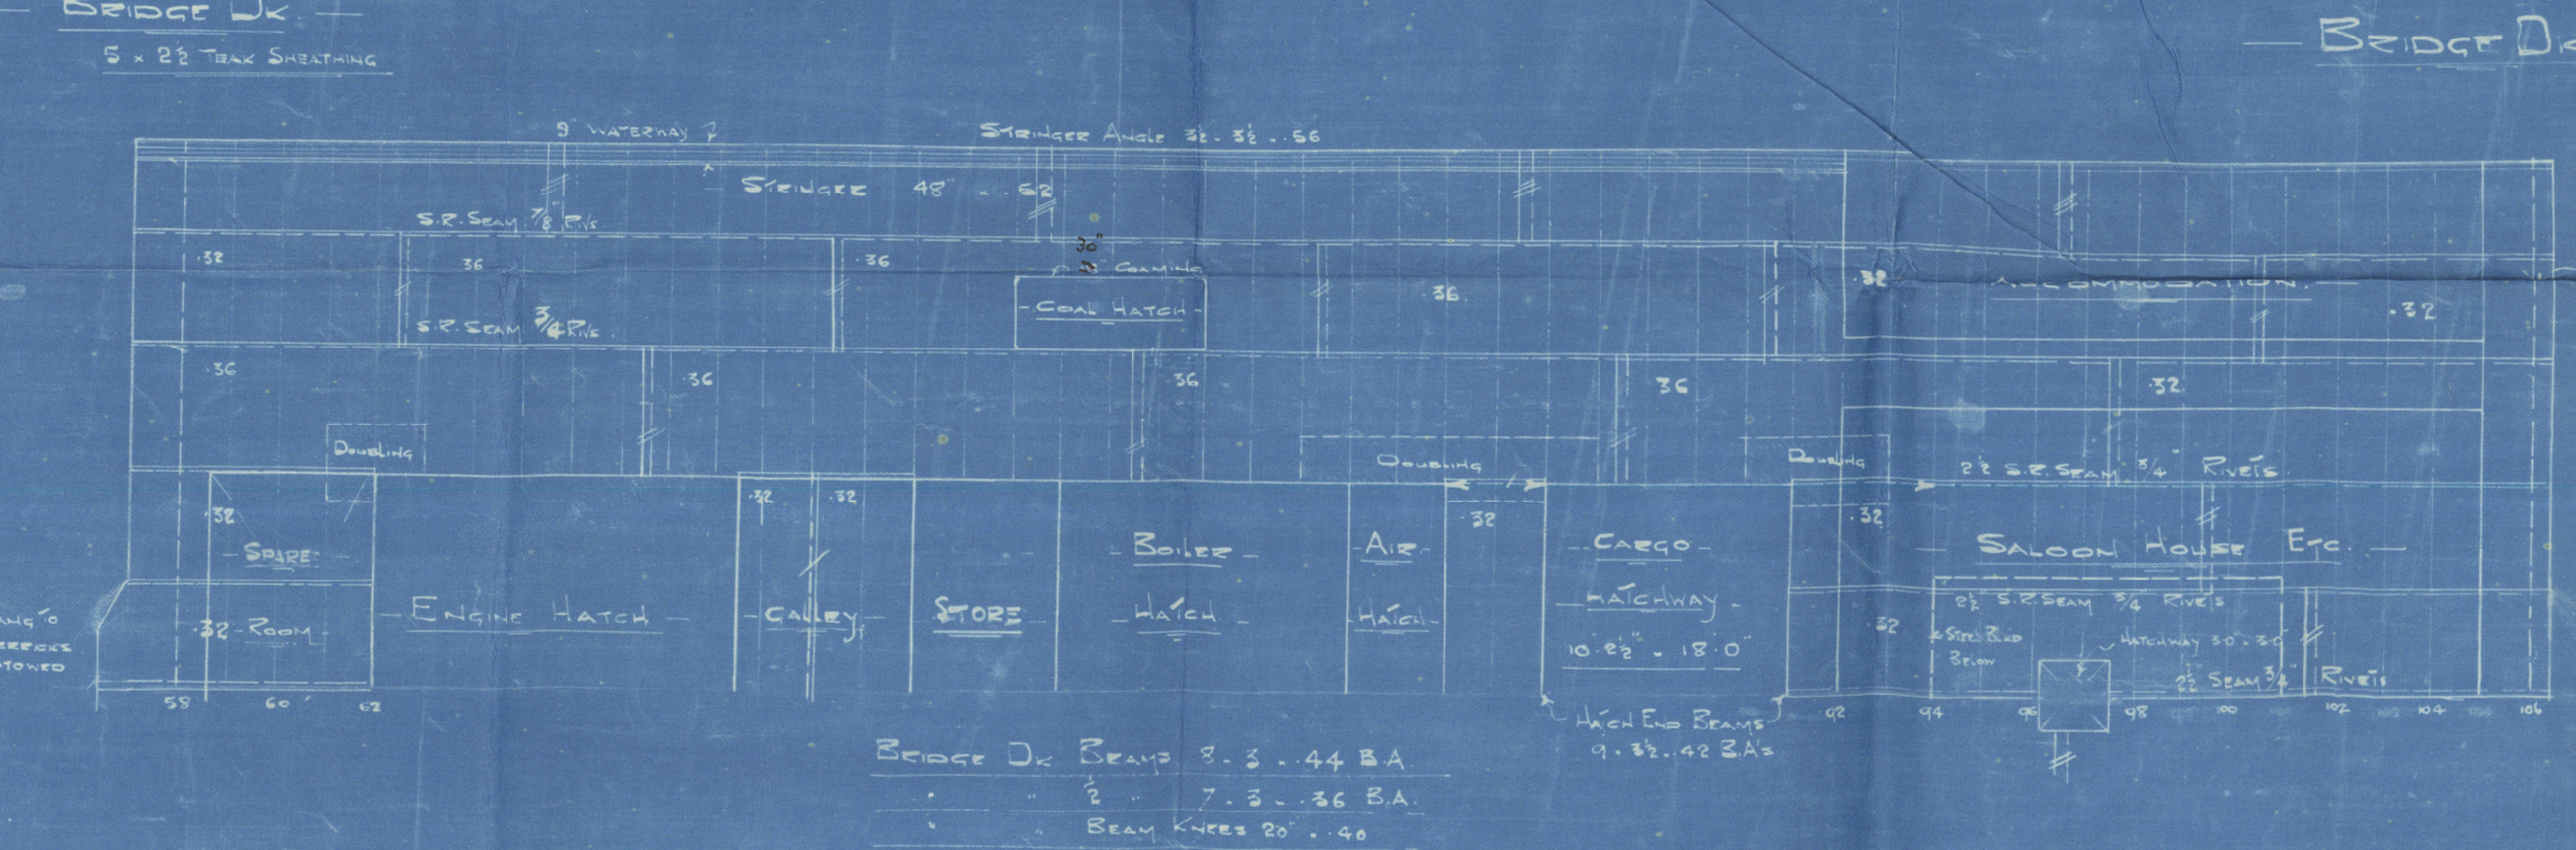
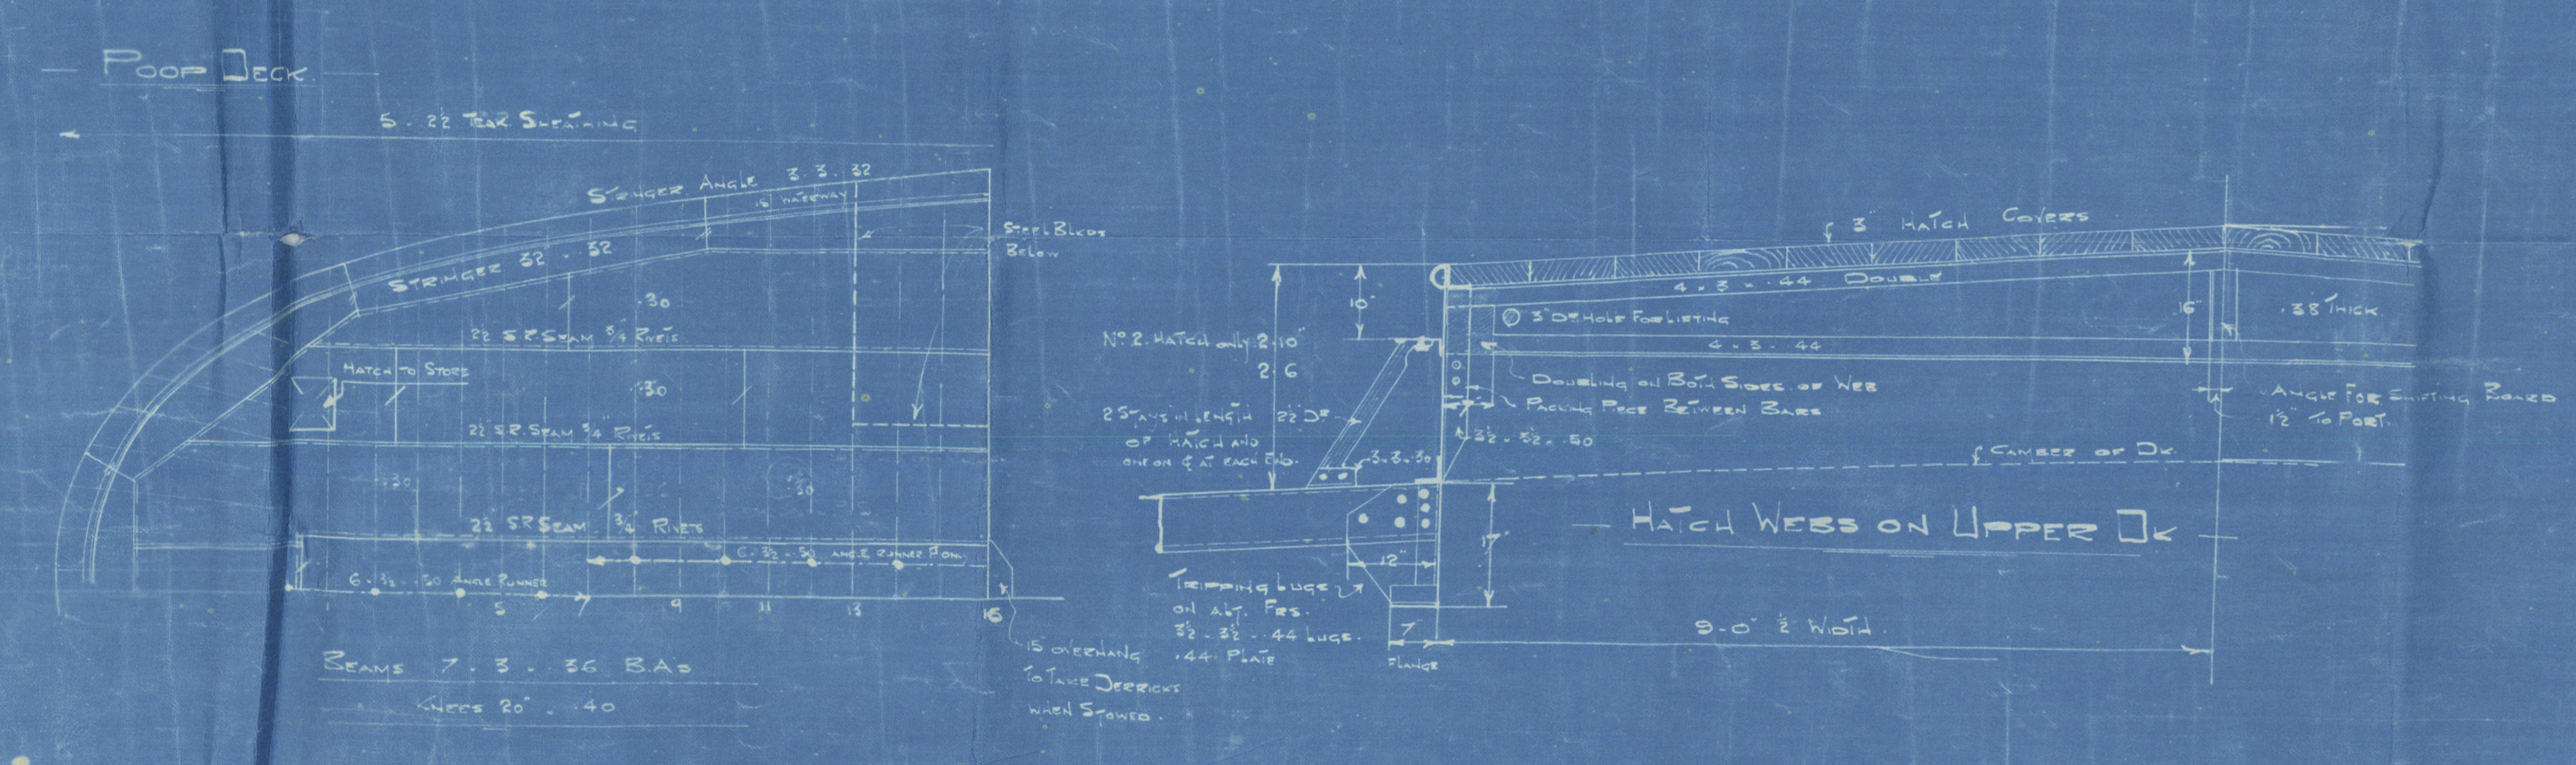
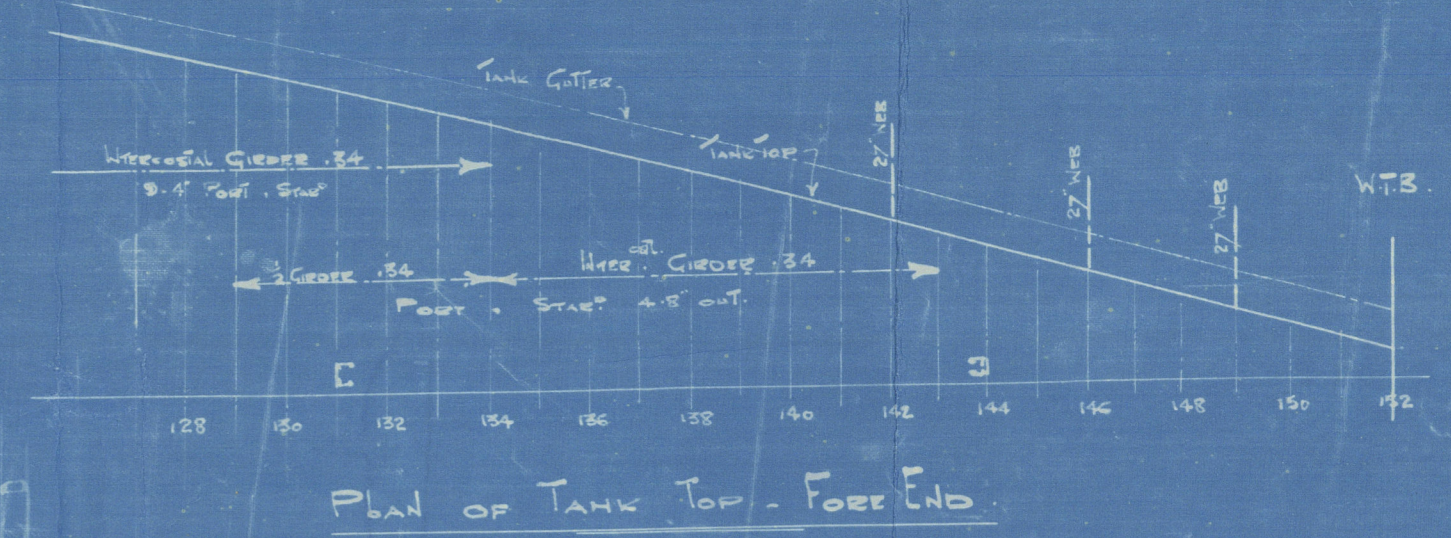


60-1-10


S.S. TAIKOO WAN YI
PROFILE & DECK PLANS
331'-0" B.P. x 46'-6" M.D. x 25'-6" M.D.

SCALE 1/8" = 1 FOOT

CLASS B5 * BRITISH CORPORATION
100 MAT LLOYDS


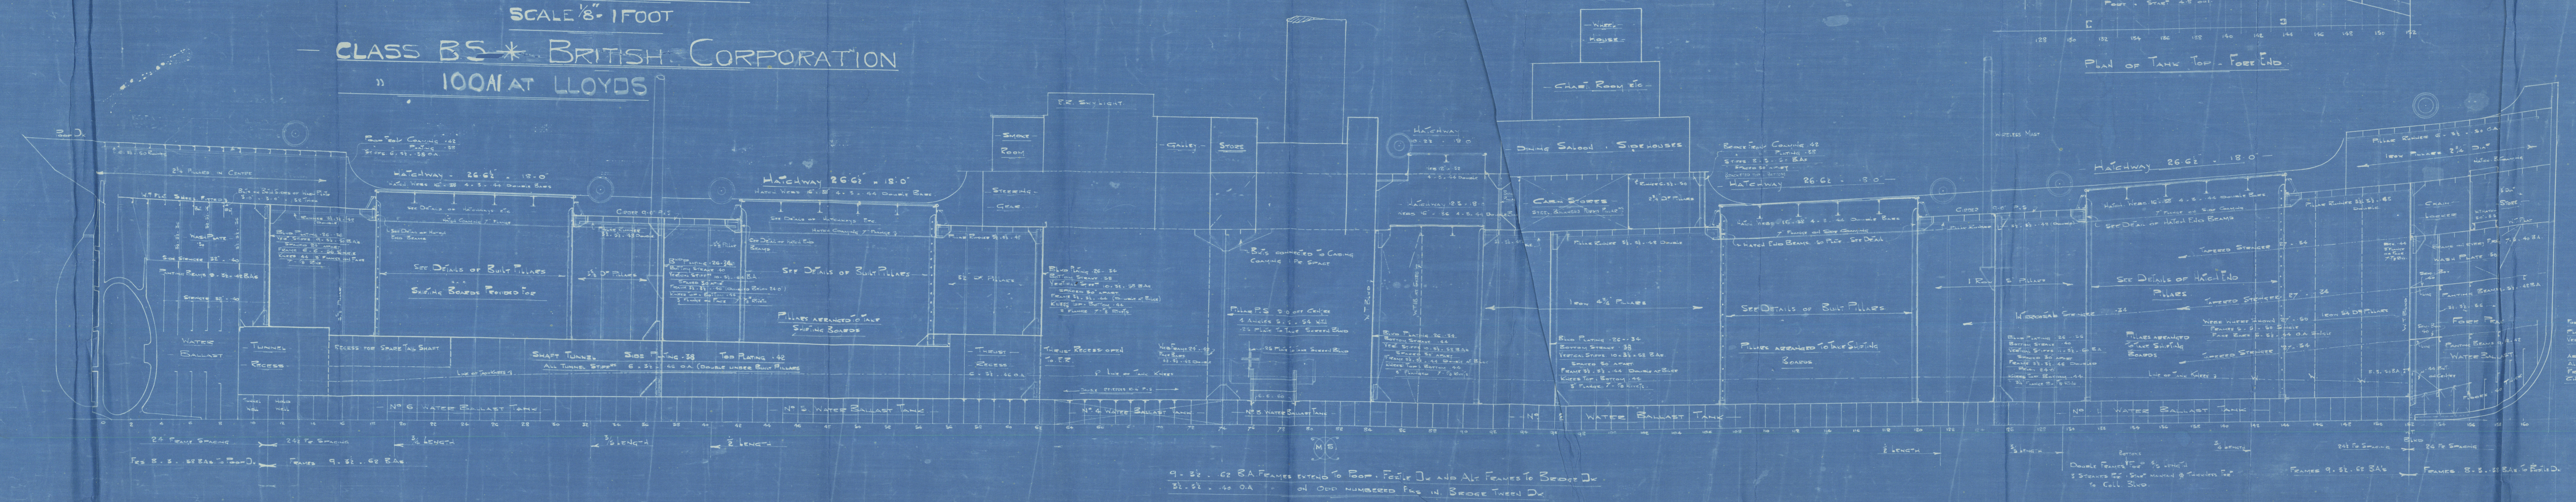


Sketch of Diamond Plates - Arrangement at Hatch Corners

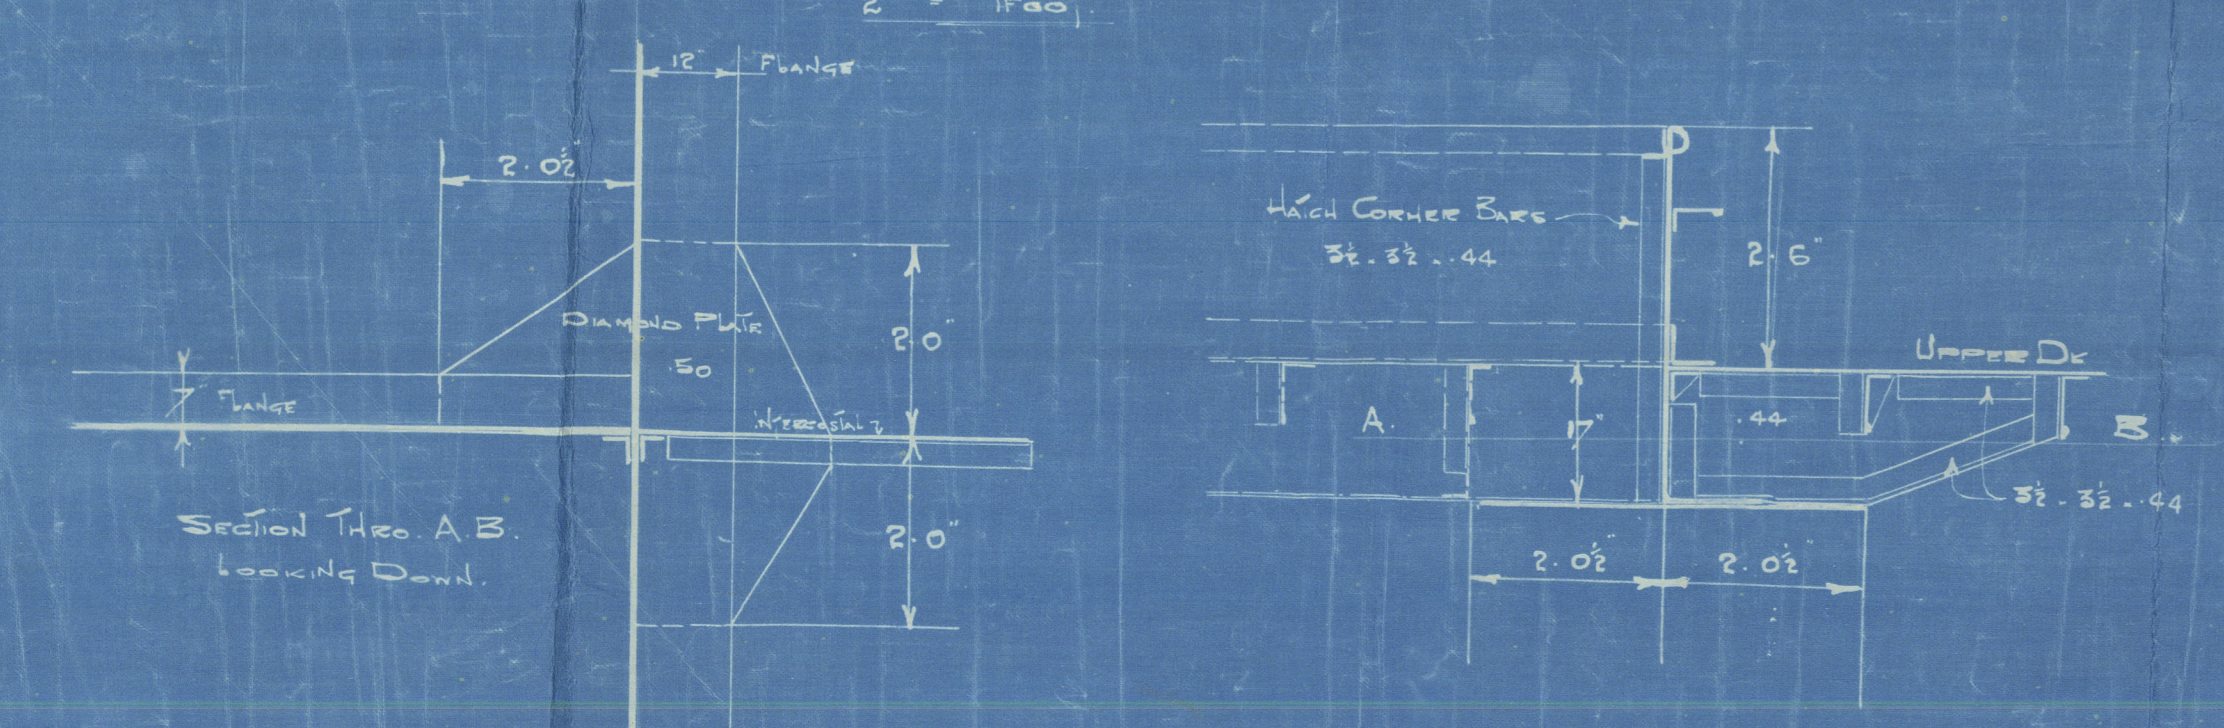

Upper Deck Beams 9'-5 1/2" - 42' 3 1/2" x 7'-5" - 56' 4 1/2" x 7'-5" - 56' 4 1/2"

PLAN OF MAIN HATCHES 26' 6 1/2" x 18' 0"

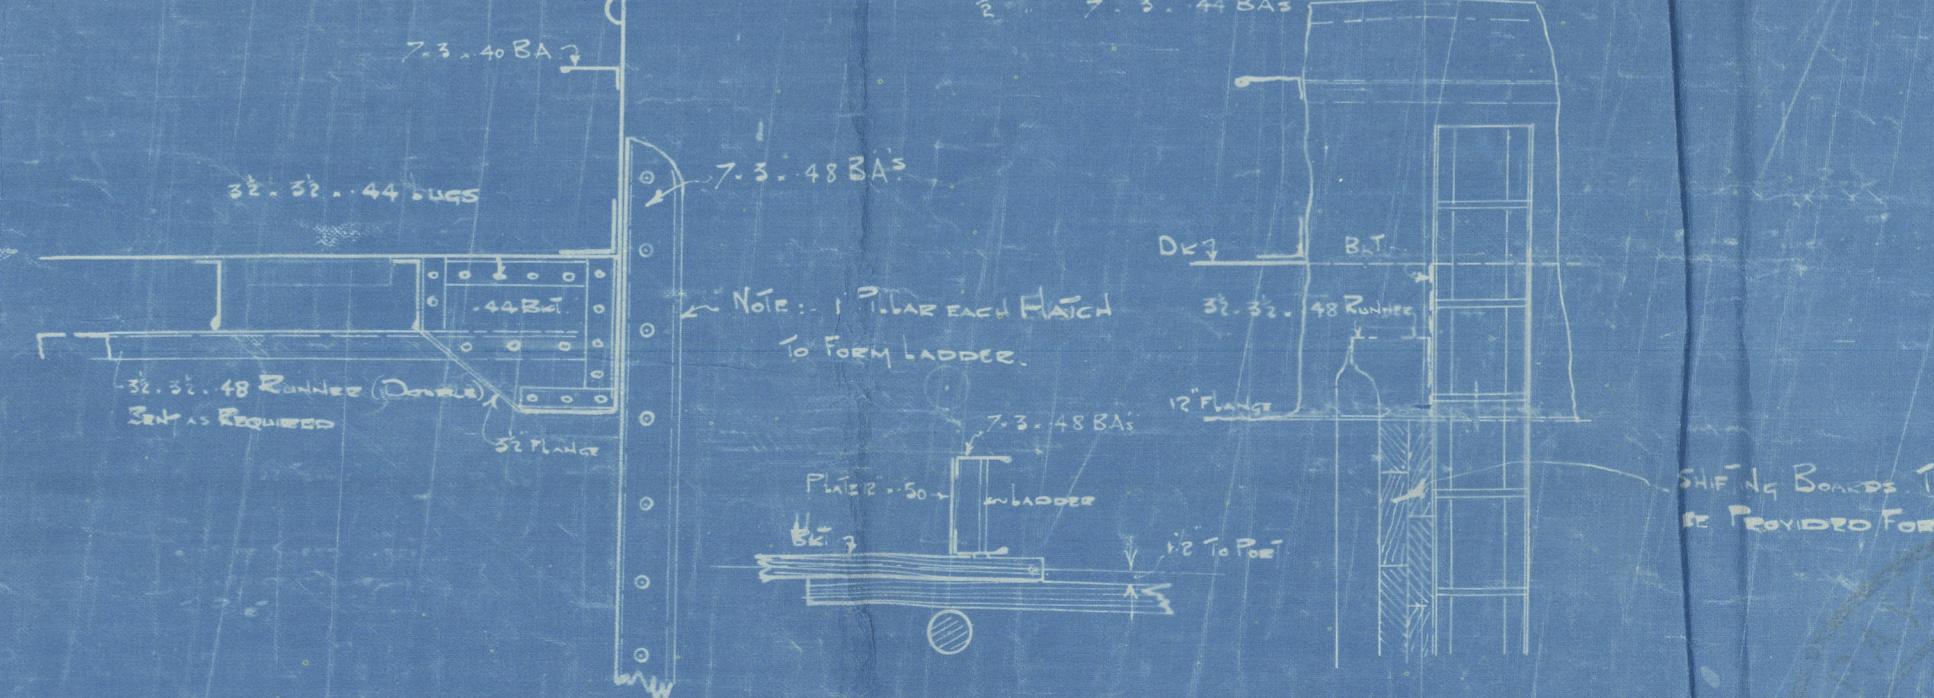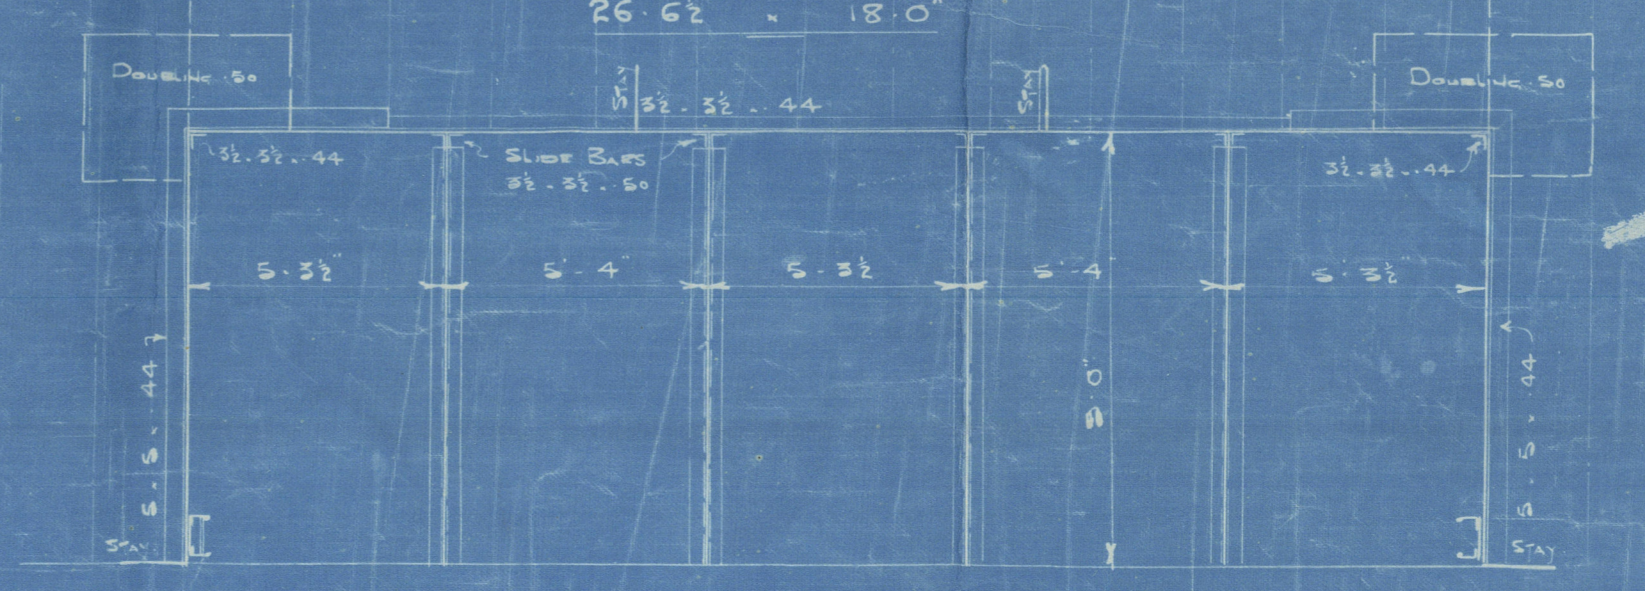

DETAILS OF BUILT PLATES AT HATCH ENDS 1/2" = 1 FOOT

Messrs. Sir Roderick Duxbury


Nº 617

PROFILE & DECK PLANS

(as built)

S.S. TAIKOO, WAN YI

Draw. Rpt. Nº 10410.

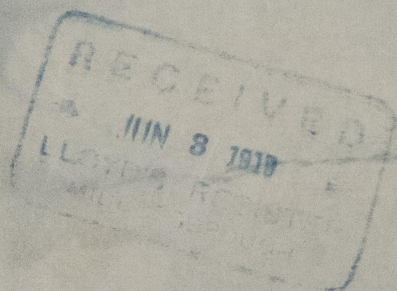

© 2021

Lloyd's Register
Foundation

010067-010078-0180

RECEIVED
JUN 6 1919
LLOYD'S REGISTER.
MIDDLESBROUGH.



© 2021

Lloyd's Register
Foundation