


NET TO CHANGE TRIM ONE CM PER CENT	TONS PER CENT	DISPL. IN K. TONS	DEAD WEIGHT IN K. TONS
17.000	17.000	17.000	17.000
16.000	16.000	16.000	16.000
15.000	15.000	15.000	15.000
14.000	14.000	14.000	14.000
13.000	13.000	13.000	13.000
12.000	12.000	12.000	12.000
11.000	11.000	11.000	11.000
10.000	10.000	10.000	10.000
9.000	9.000	9.000	9.000
8.000	8.000	8.000	8.000
7.000	7.000	7.000	7.000
6.000	6.000	6.000	6.000
5.000	5.000	5.000	5.000
4.000	4.000	4.000	4.000
3.000	3.000	3.000	3.000
2.000	2.000	2.000	2.000
1.000	1.000	1.000	1.000
0	0	0	0

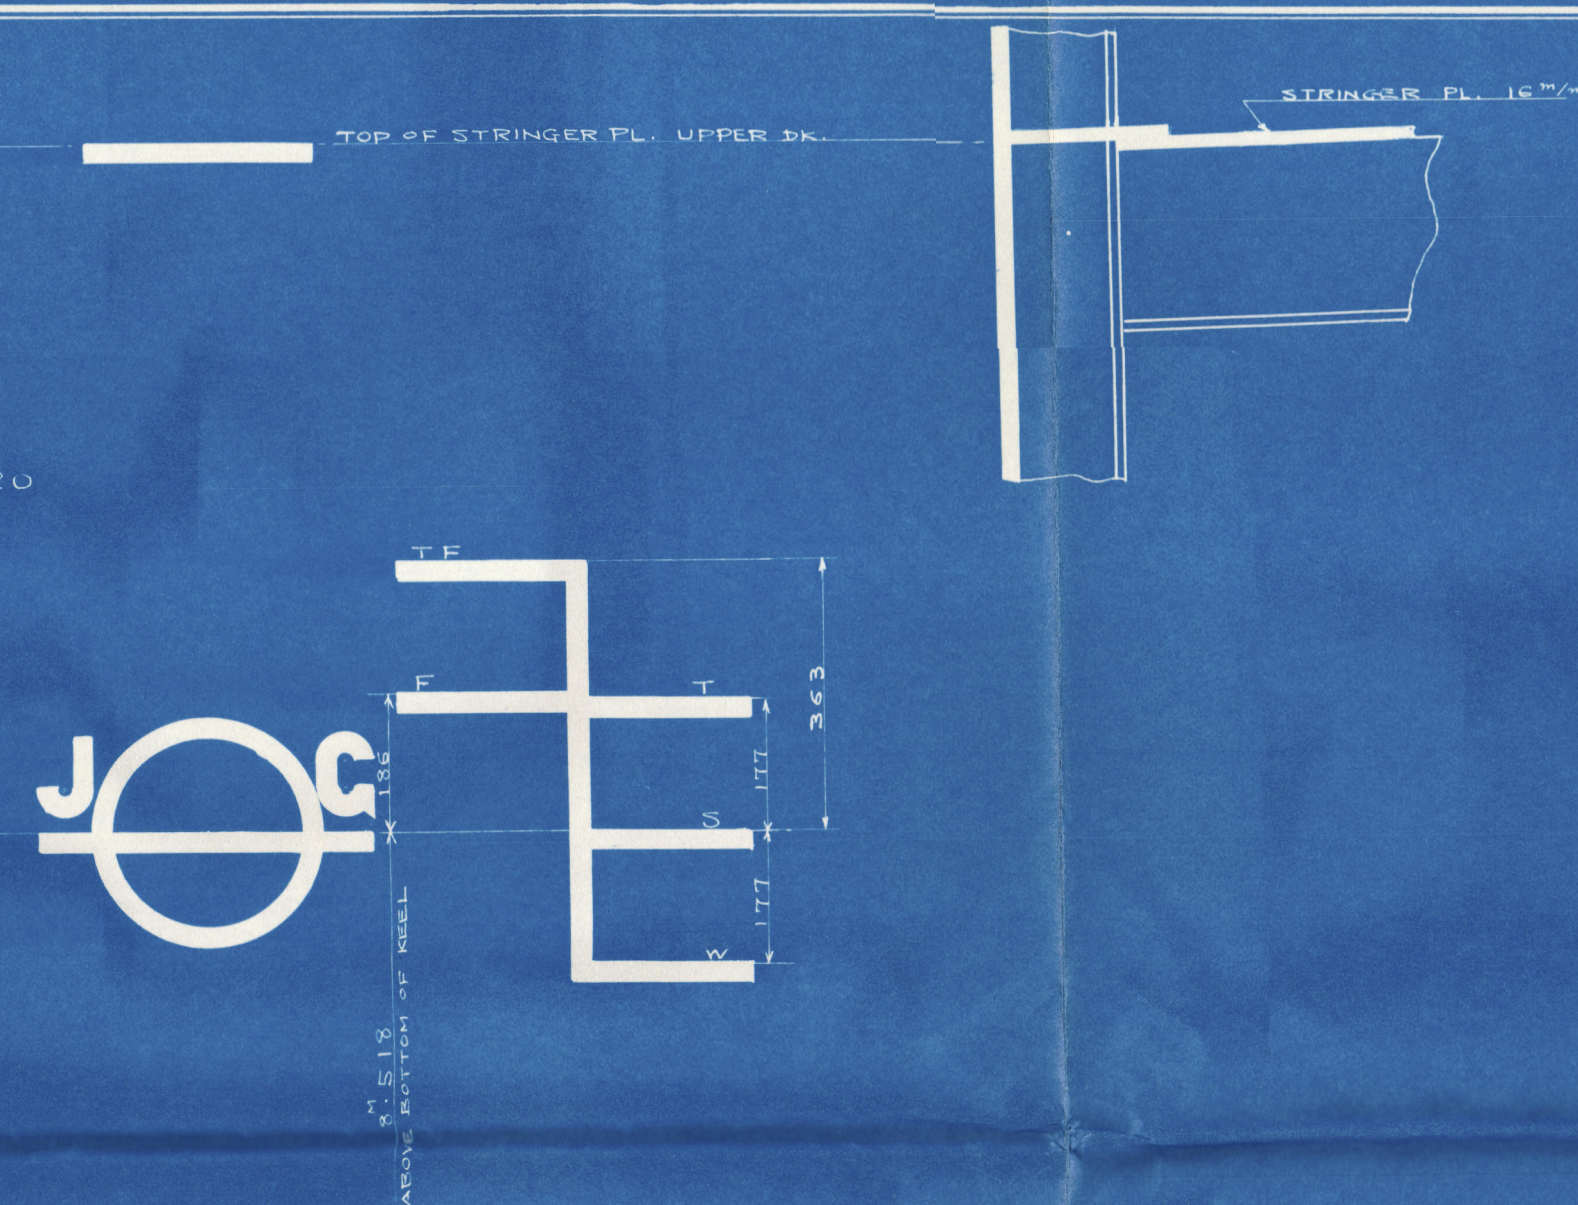

# TAMON MARU CAPACITY PLAN SCALE 1:200

PRINCIPAL DIMENSIONS	
LENGTH BETWEEN P.P.	170.000
BREADTH MOLDED	16.000
DEPTH	10.700
GROSS TONNAGE	7715.61
NET TONNAGE	4425.92
DEAD WEIGHT	11108.2

CARGO HOLD & CARGO SPACES							11/23/11 08:50M TON	
ITEM	SIDE	FROM	GRAIN		BALE		GG	KG
			IN TONS	IN TONS	IN TONS	IN TONS	IN TONS	IN TONS
NO.1 CARGO HOLD		151-154	117.9	119.1	134.1	135.4	13.5	13.5
NO.2		157-161	2.6	2.7	2.6	2.6	0.3	0.3
NO.3		164-169	2.2	2.2	1.8	1.8	1.6	1.6
NO.4 CARGO HOLD DECK TANK	P	171.1	1.6	1.6	4.8	4.8	4.2	4.2
	S	5	5.2	4.7	5.1	4.5	25.5	25.5
NO.5 CARGO HOLD		172.1	17.1	15.1	15.8	13.4	57.7	57.7
NO.6		10-12	6.2	5.2	5.5	4.5	53.7	53.6
S U M M								
NO.1 TWELVEN BALE CARGO SPACE		181-195	7.5	6.5	6.6	5.6	51.5	51.5
NO.2		191-195	1.1	1.2	1.3	1.4	34.6	34.7
NO.3		196-198	9.7	8.2	8.4	7.1	64.3	59.4
NO.4		197.1	1.1	1.1	1.6	1.6	31.5	31.5
NO.5		6-32	9.7	7.2	6.8	6.1	54.3	53.3
S U M M								
			5.2	4.7	4.7	4.2	43.8	
FOUR THIRTY EIGHT CARGO SPACE								
UNDER DECK TANK		174-181	9.5	8.4	8.7	7.4	15.7	12.4
UNDER DECK CARGO SPACE	S	17-33	4.5	4.1	5.8	5.0	24.3	24.5
S U M M								
			1.6	1.6	1.8	1.6	67.3	18.2
GRAND TOTAL								
			16.4	14.4	14.3	11.6		
SILK ROOM								
PARCEL ROOM	P	39-43					56.0	5.6
MAIL ROOM	P	13-12					5.0	12.7
TOTAL								
						2.8		



NO 6 5 5  
多聞丸

# CAPACITY PLAN

積量圖

完成圖

尺度		1/200	
工事番号		100-655-0	
浦賀造船所 株式會社 浦賀造船所	設計部		
	部長	平	
	造船設計課	課長	29.7.20
	係長	6.28	
	製圖	H. Kogami	
製圖年月日		June 28, 1954	
出圖年月日			
類別番号		算X21-	
圖面番号		完成 2	

1.300 x 800

"Tamon Maru" ★  
"As Built"

Yka F.E. Rpt. No. 1457.



RECORDS DEPT.,  
LONDON.



© 2021

Lloyd's Register  
Foundation

010079-010088-0188