


MAST, WINDLASS, WINCHES AND STEERING GEAR
TO BE SUPPORTED TO SURVEYORS SATISFACTION

TABLE FOR ELECTRIC WELDING		
	FULL WELD SINGLE CONTINUOUS	
	FULL WELD DOUBLE CONTINUOUS	
	FULL WELD AROUND NOTCHES ETC	
	BUTT WELDS CONTINUOUS	
	TO 14mm WITH DEEP PENETRATING ELECTRODES	
	FOR UNION MELT WELD	

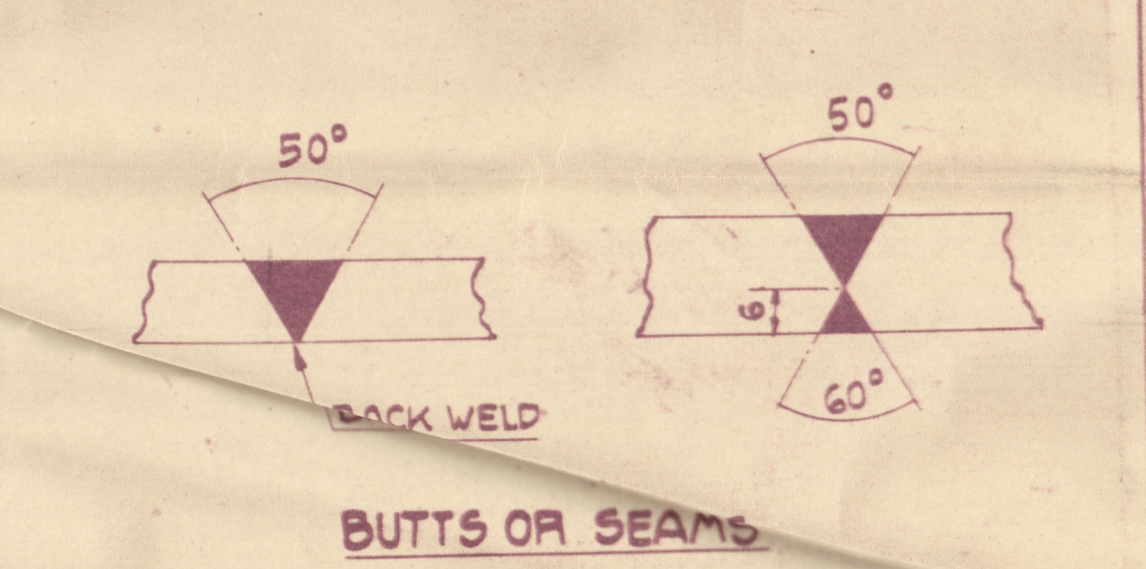

MARK	ALTERATION	DATE	APPROVED
A	COFFERDAM FR. 76-77 TO 75-76	2-6-49	2-6-49
B	CHAIN-LOCKER IN CREASED	2-6-49	2-6-49
C	PUMPROOM-CASING BREATHED	2-6-49	2-6-49

DIMENSIONS	
LENGTH OVER ALL	316'-5" 157.46 MET.
LENGTH BETWEEN RP	480'-0" 146.30 "
BREADTH MOULDED	64'-0" 19.50 "
DEPTH TO MAIN DECK	35'-6" 10.82 "
EQUIVALENT DEPTH	34'-6" 10.52 "
HEIGHT OF POOP	8'-0" 2.44 "
" " BRIDGE	" " " "
" " FORECASTLE	" " " "

CLASS	
LLOYD'S REGISTER 100 A.1	
CARRYING PETROLEUM IN BULK	
SPECIAL NOTATION "LONGITUDINAL FRAMING"	
ELECTRICALLY WELDED	
LLOYD'S LENGTH 480.1'	
NUMERALS	
L/D =	1658
L x (B+D) =	47353
L/D =	13.55

ROTHENBURG FIRST ENTRY REPORT No 1815

1/5 ISLAS OCEANAS

1/5 FITTED PLAN

UDDEVAL LARVET AB.

No 111, 112, 113

LONGITUDINAL SECTION

AND PLANS.

ATTED BY C. S. SKALA 1:100

KALK AV. 2. H. DRYN. 19-3-48

BRANESKAD AV. 1/11


© 2021 Lloyd's Register

1453

'ISLAS ORCADAS' ★

Longh section a plane
(as built)

RECORDS DEPT.
LONDON

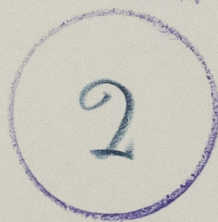

© 2020

Lloyd's Register
Foundation

010137-010149-0143